


*WS. 7/2/80  
and 8/1/80*

LEGAL DESCRIPTION:  
 WICHITA, KS  
 ZONED LIGHT COMMERCIAL  
 B.Z.A. # 1-80

APPROVED BY	DATE
REVISIONS	
NO.	DATE
1	8-23-80
DRAWN BY	
CHECKED BY	
DATE	
1980	

 BZA 1-80

BZA 1-80

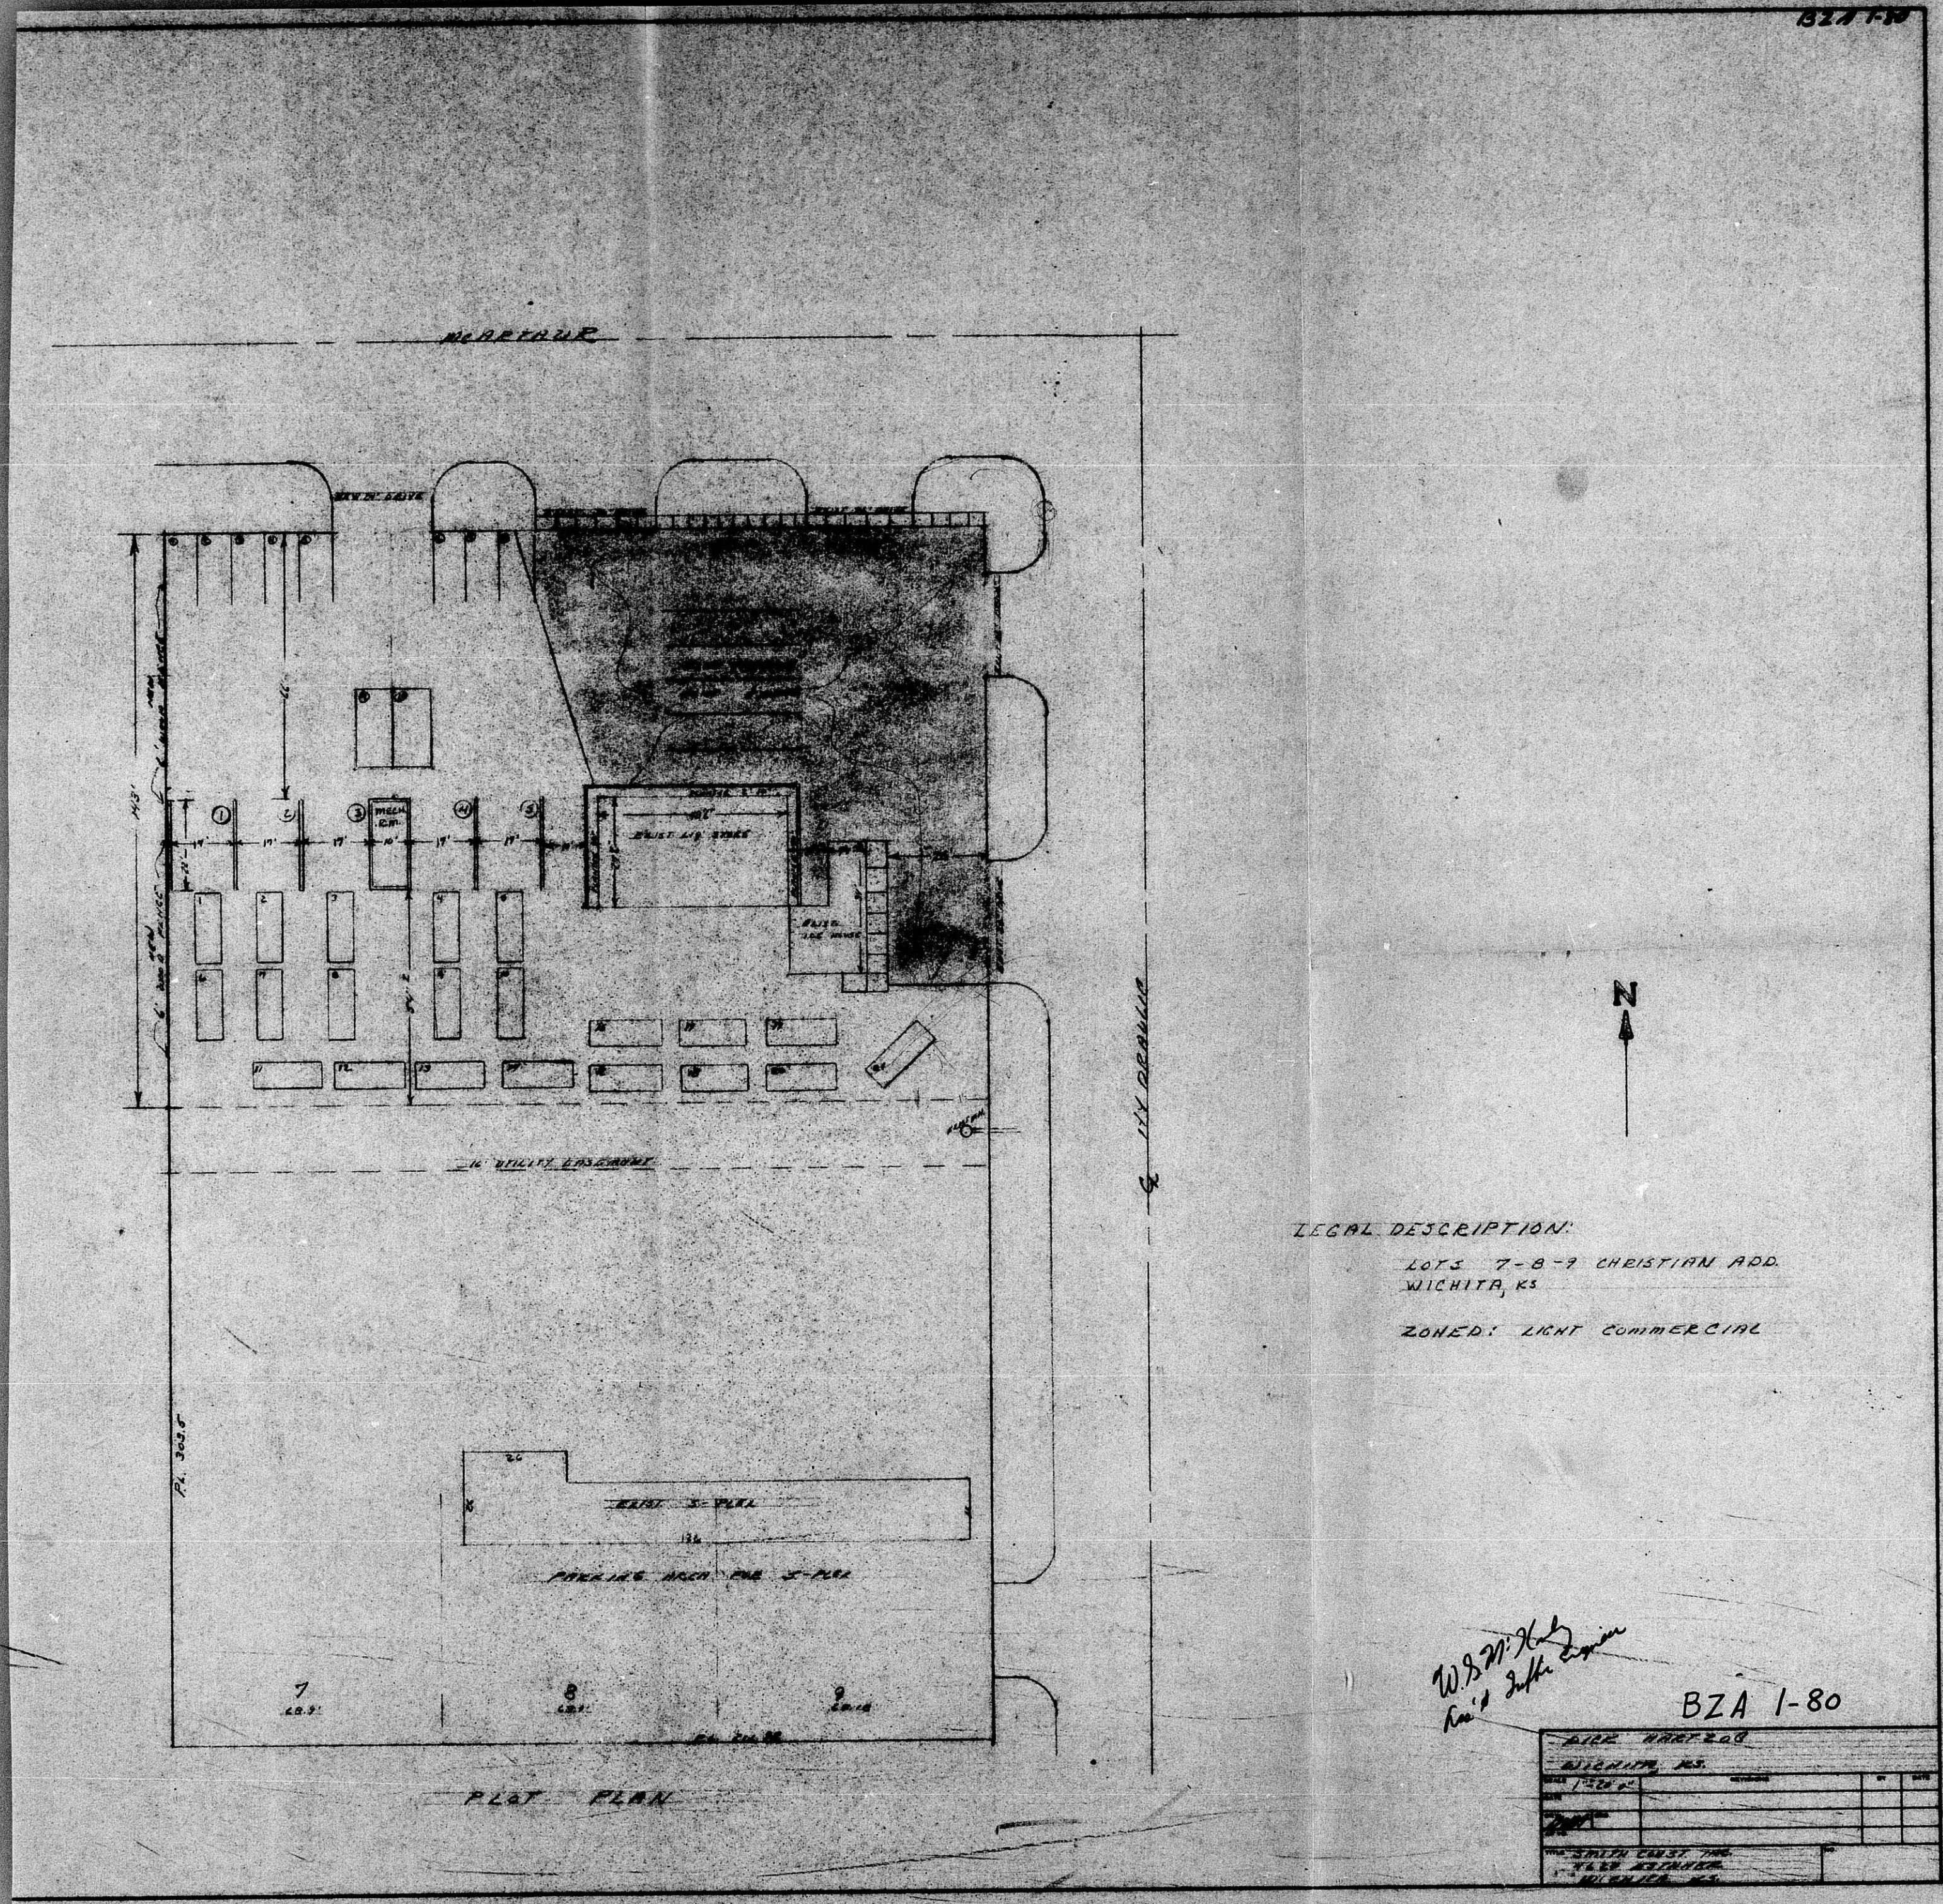


LEGAL DESCRIPTION:  
 LOTS 7-8-9 CHRISTIAN ADD.  
 WICHITA, KS  
 ZONED: LIGHT COMMERCIAL


BZA 1-80

BZA 1-80	
WICHITA, KS	

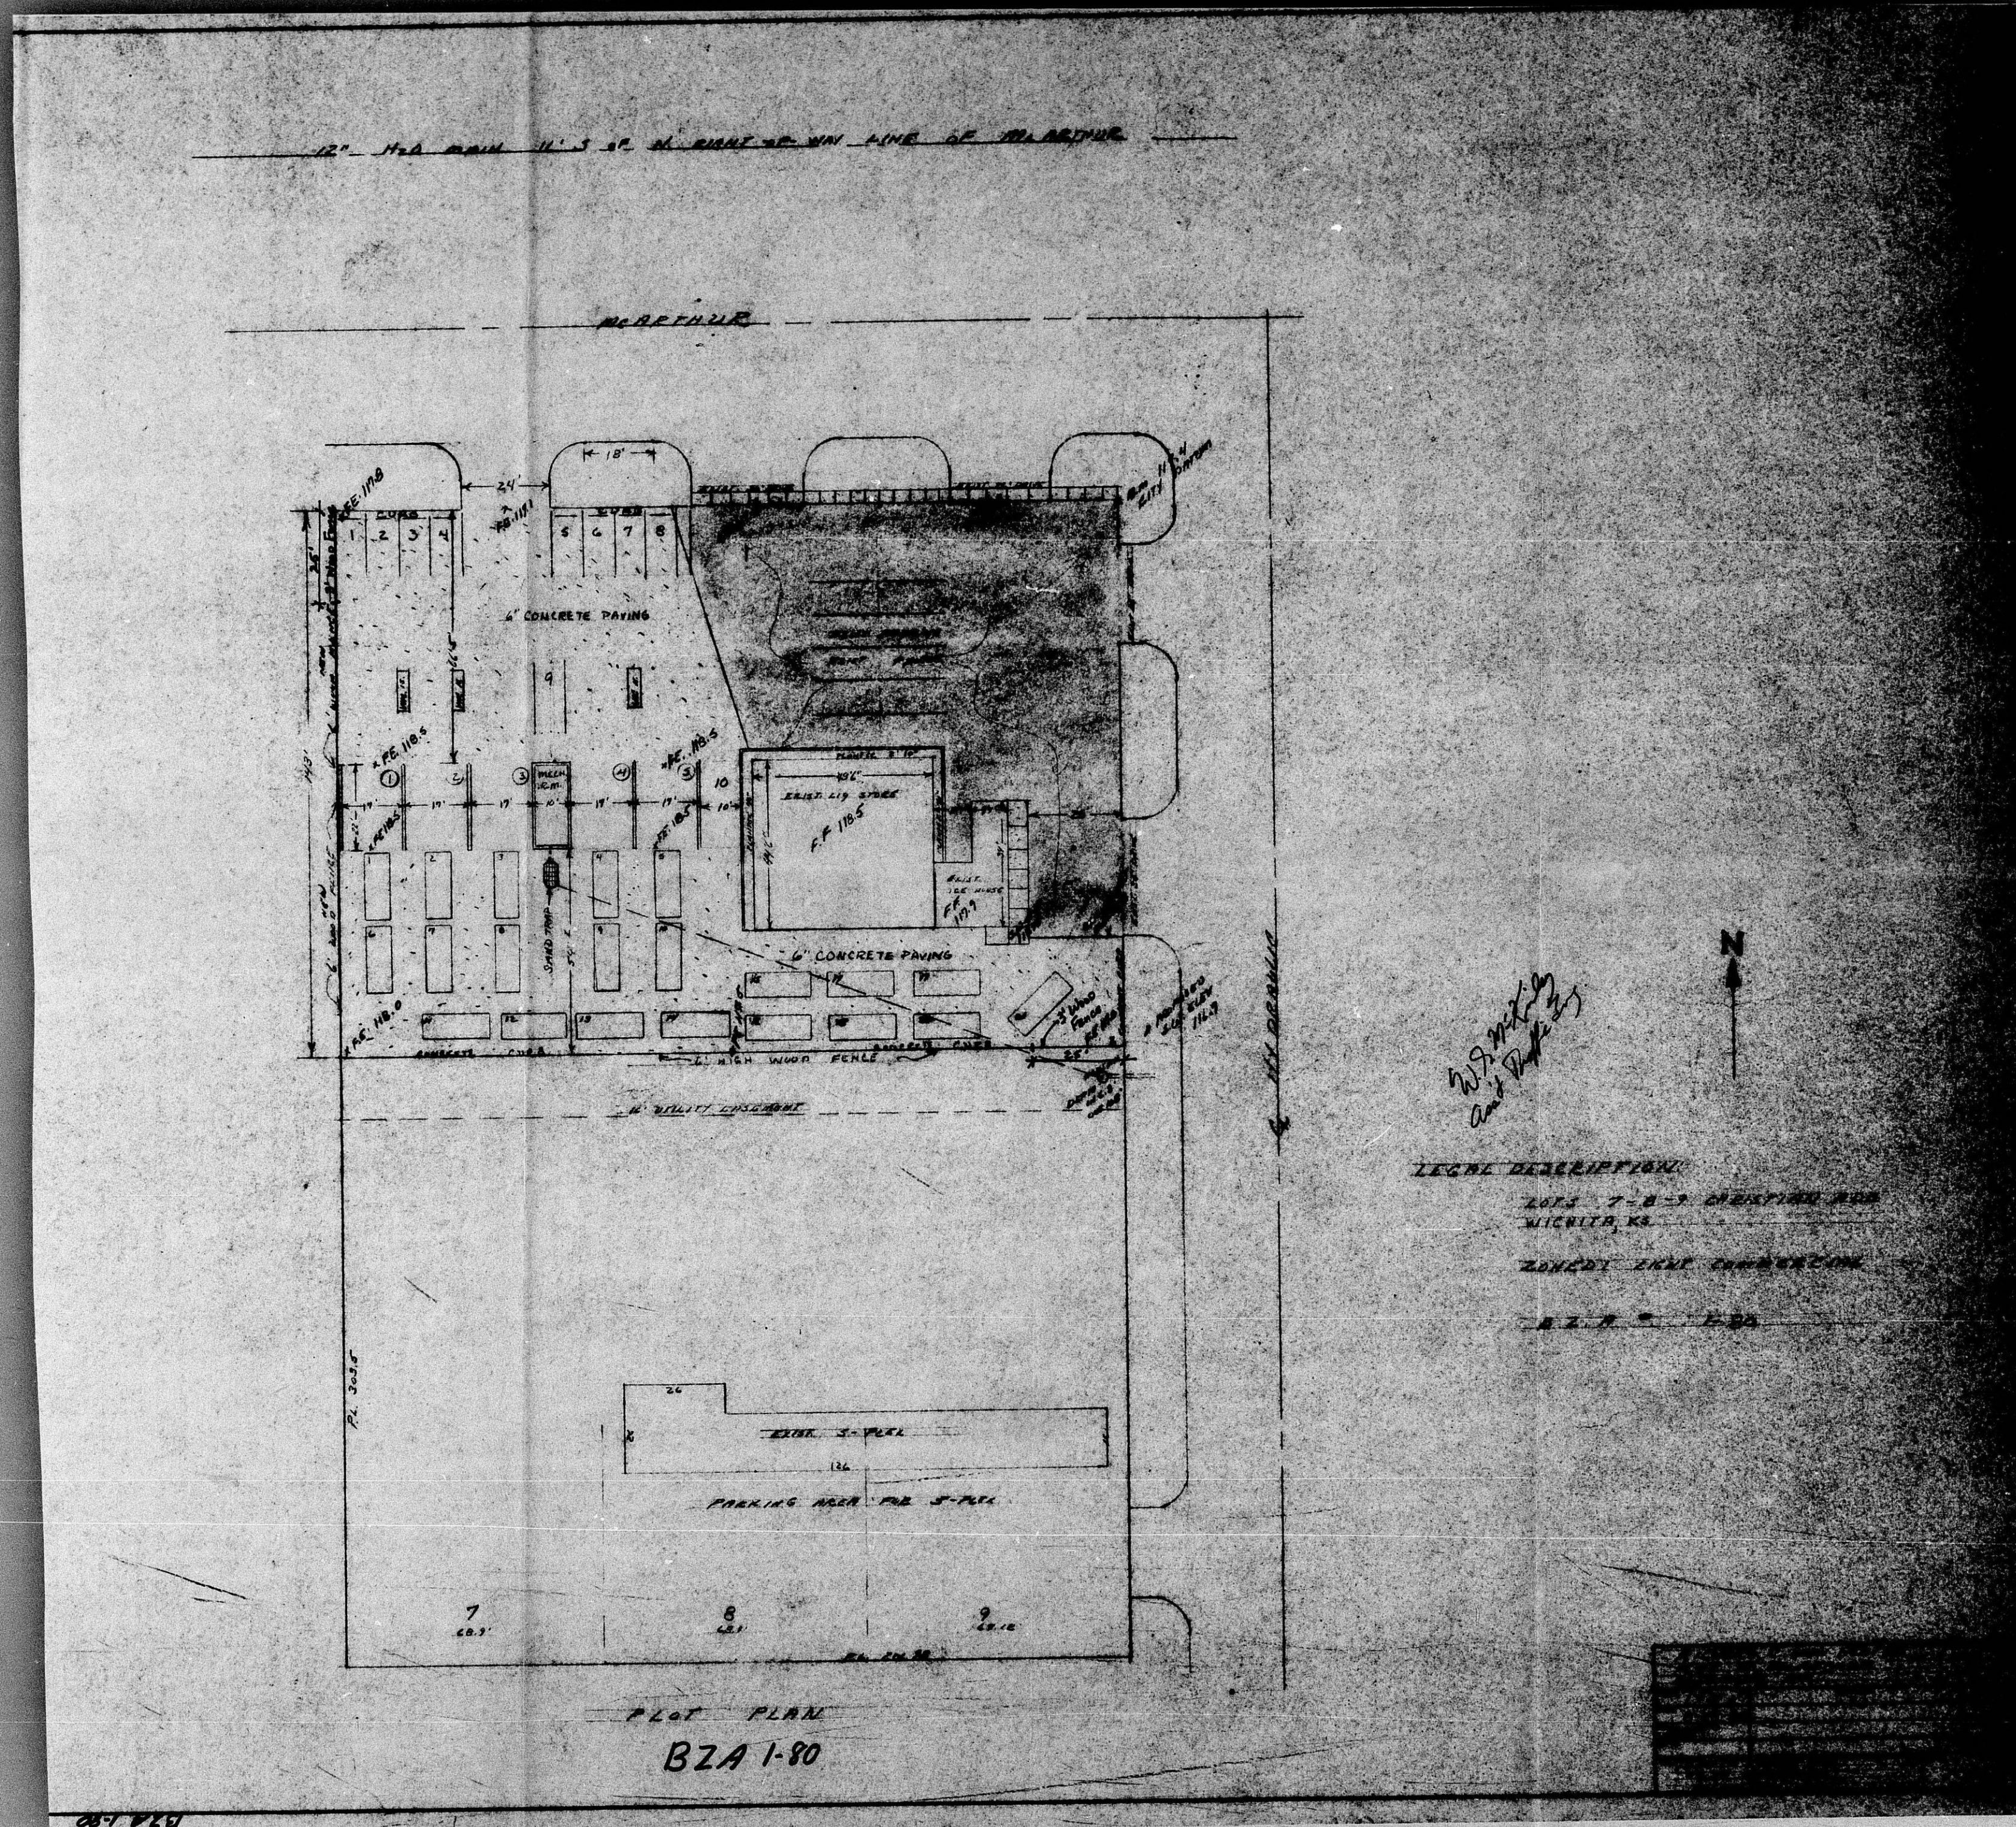


**LEGAL DESCRIPTION:**  
 B.Z. 1-80

**PLOT PLAN**  
**BZA 1-80**