


NOTES:  
 1703 E PAWNEE  
 SCALE 1" = 10"

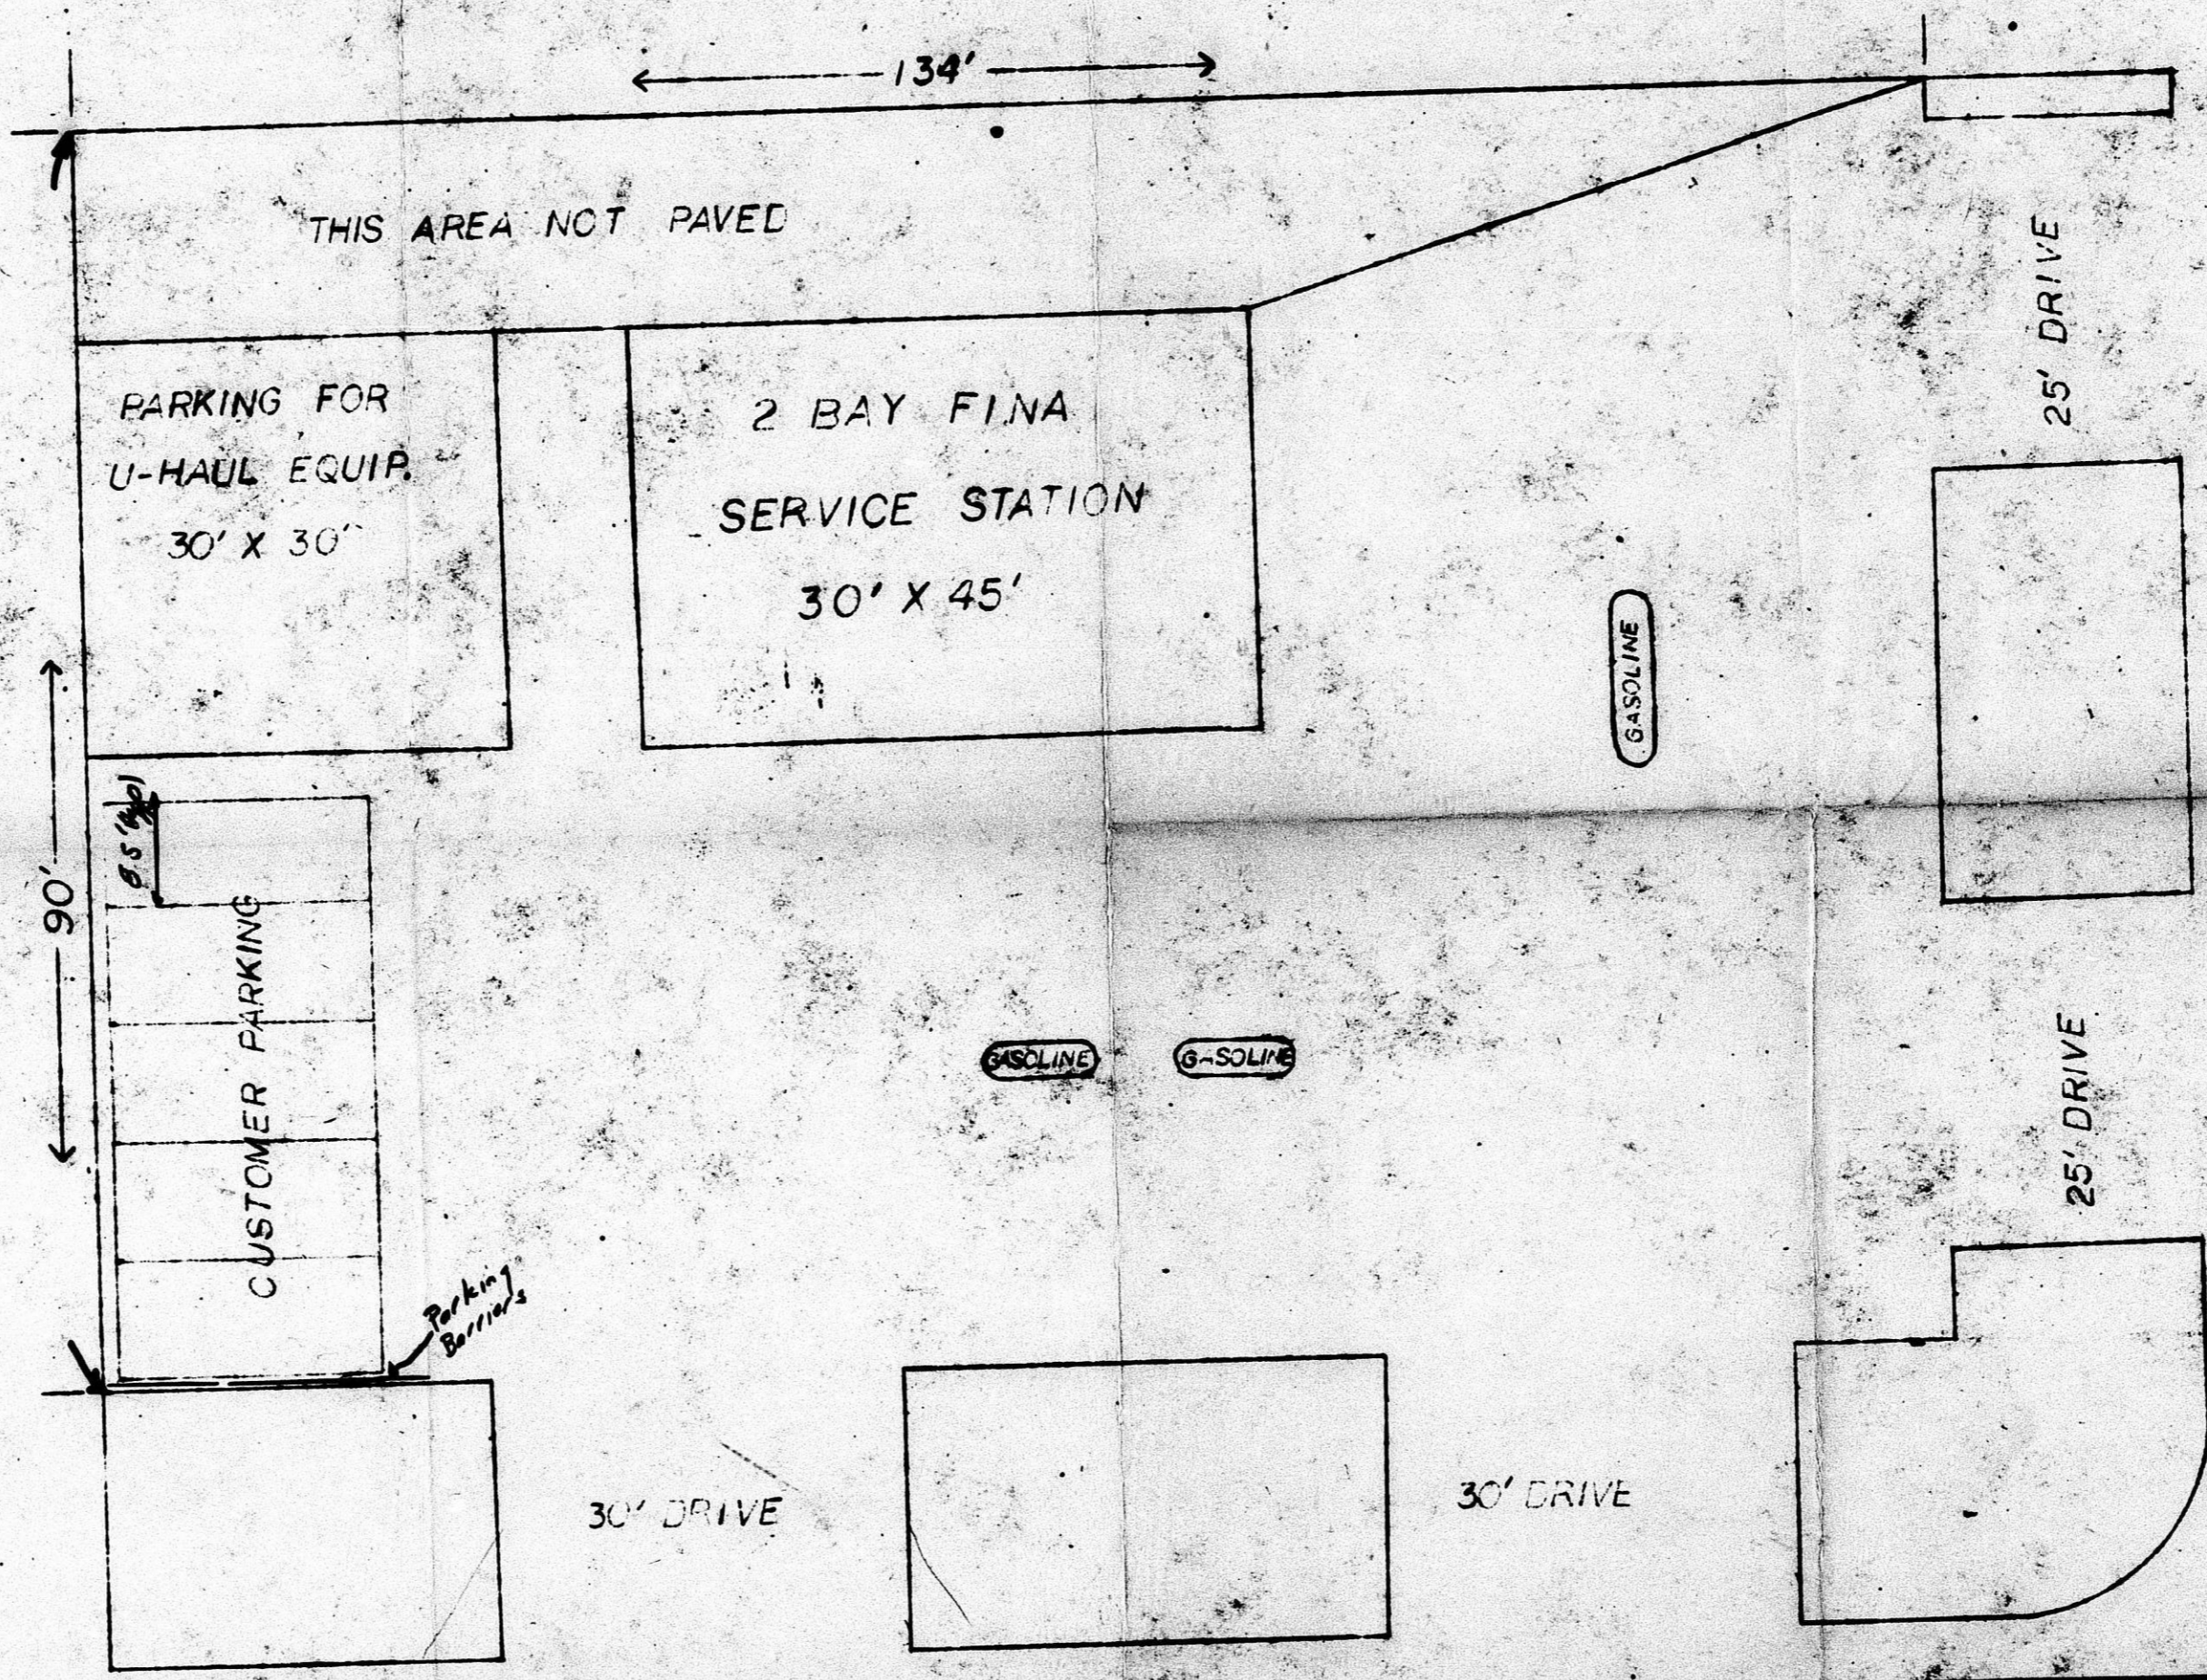

TRAFFIC ENGINEERING DIVISION APPROVED  
 Date: 4-25-67  
 (A) Parking barriers shall be provided at all locations that are adjacent to public property so that vehicles will not obstruct public property. They shall have a minimum height of 6 feet and a maximum cross section of 4" x 6".  
 (B) Steel pipe shall be painted and 4" or greater in width.  
 (C) Posts, signs and signs shall be installed in proper manner and shall conform with code of the city.

BLANK FROM THE...