LEGEND

- (A) shopping center : 2 levels
- (B) apartments
- (C) future
- (D) development
- (E) areas
- (F) future apartments

16.1 acres in (A) (C) (D) areas

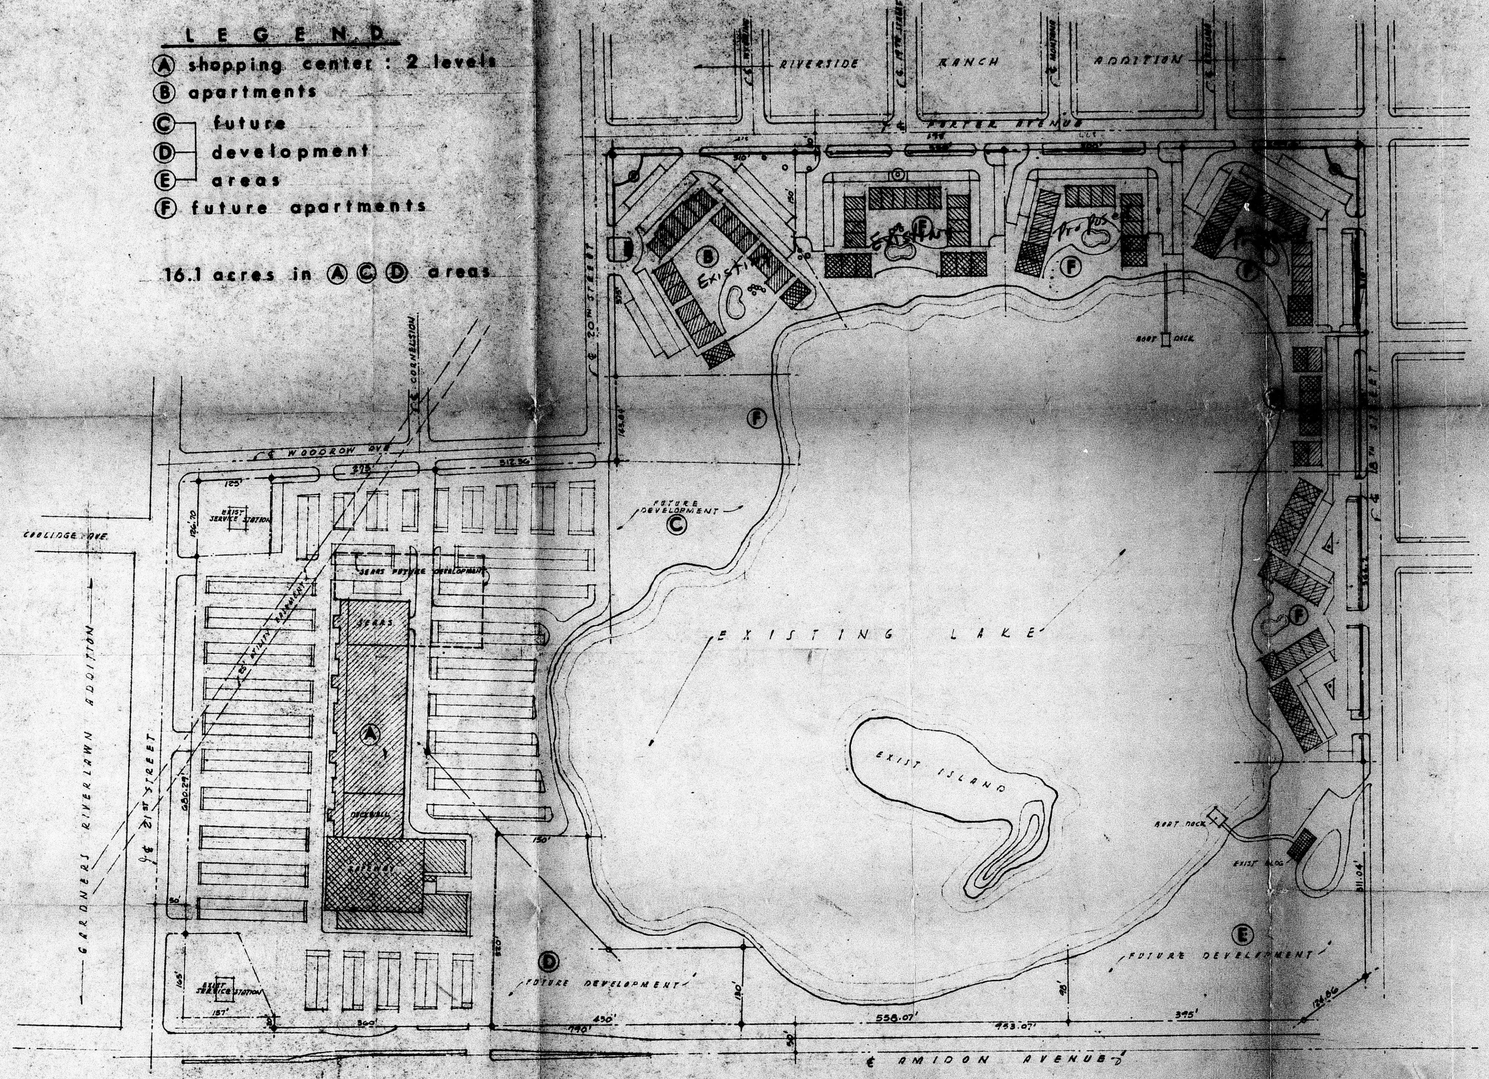

PLOT PLAN - LAKEVIEW ESTATES

SCALE 1" = 180'-0"

FILMED FROM THE BEST AVAILABLE COPY