Revised Pl

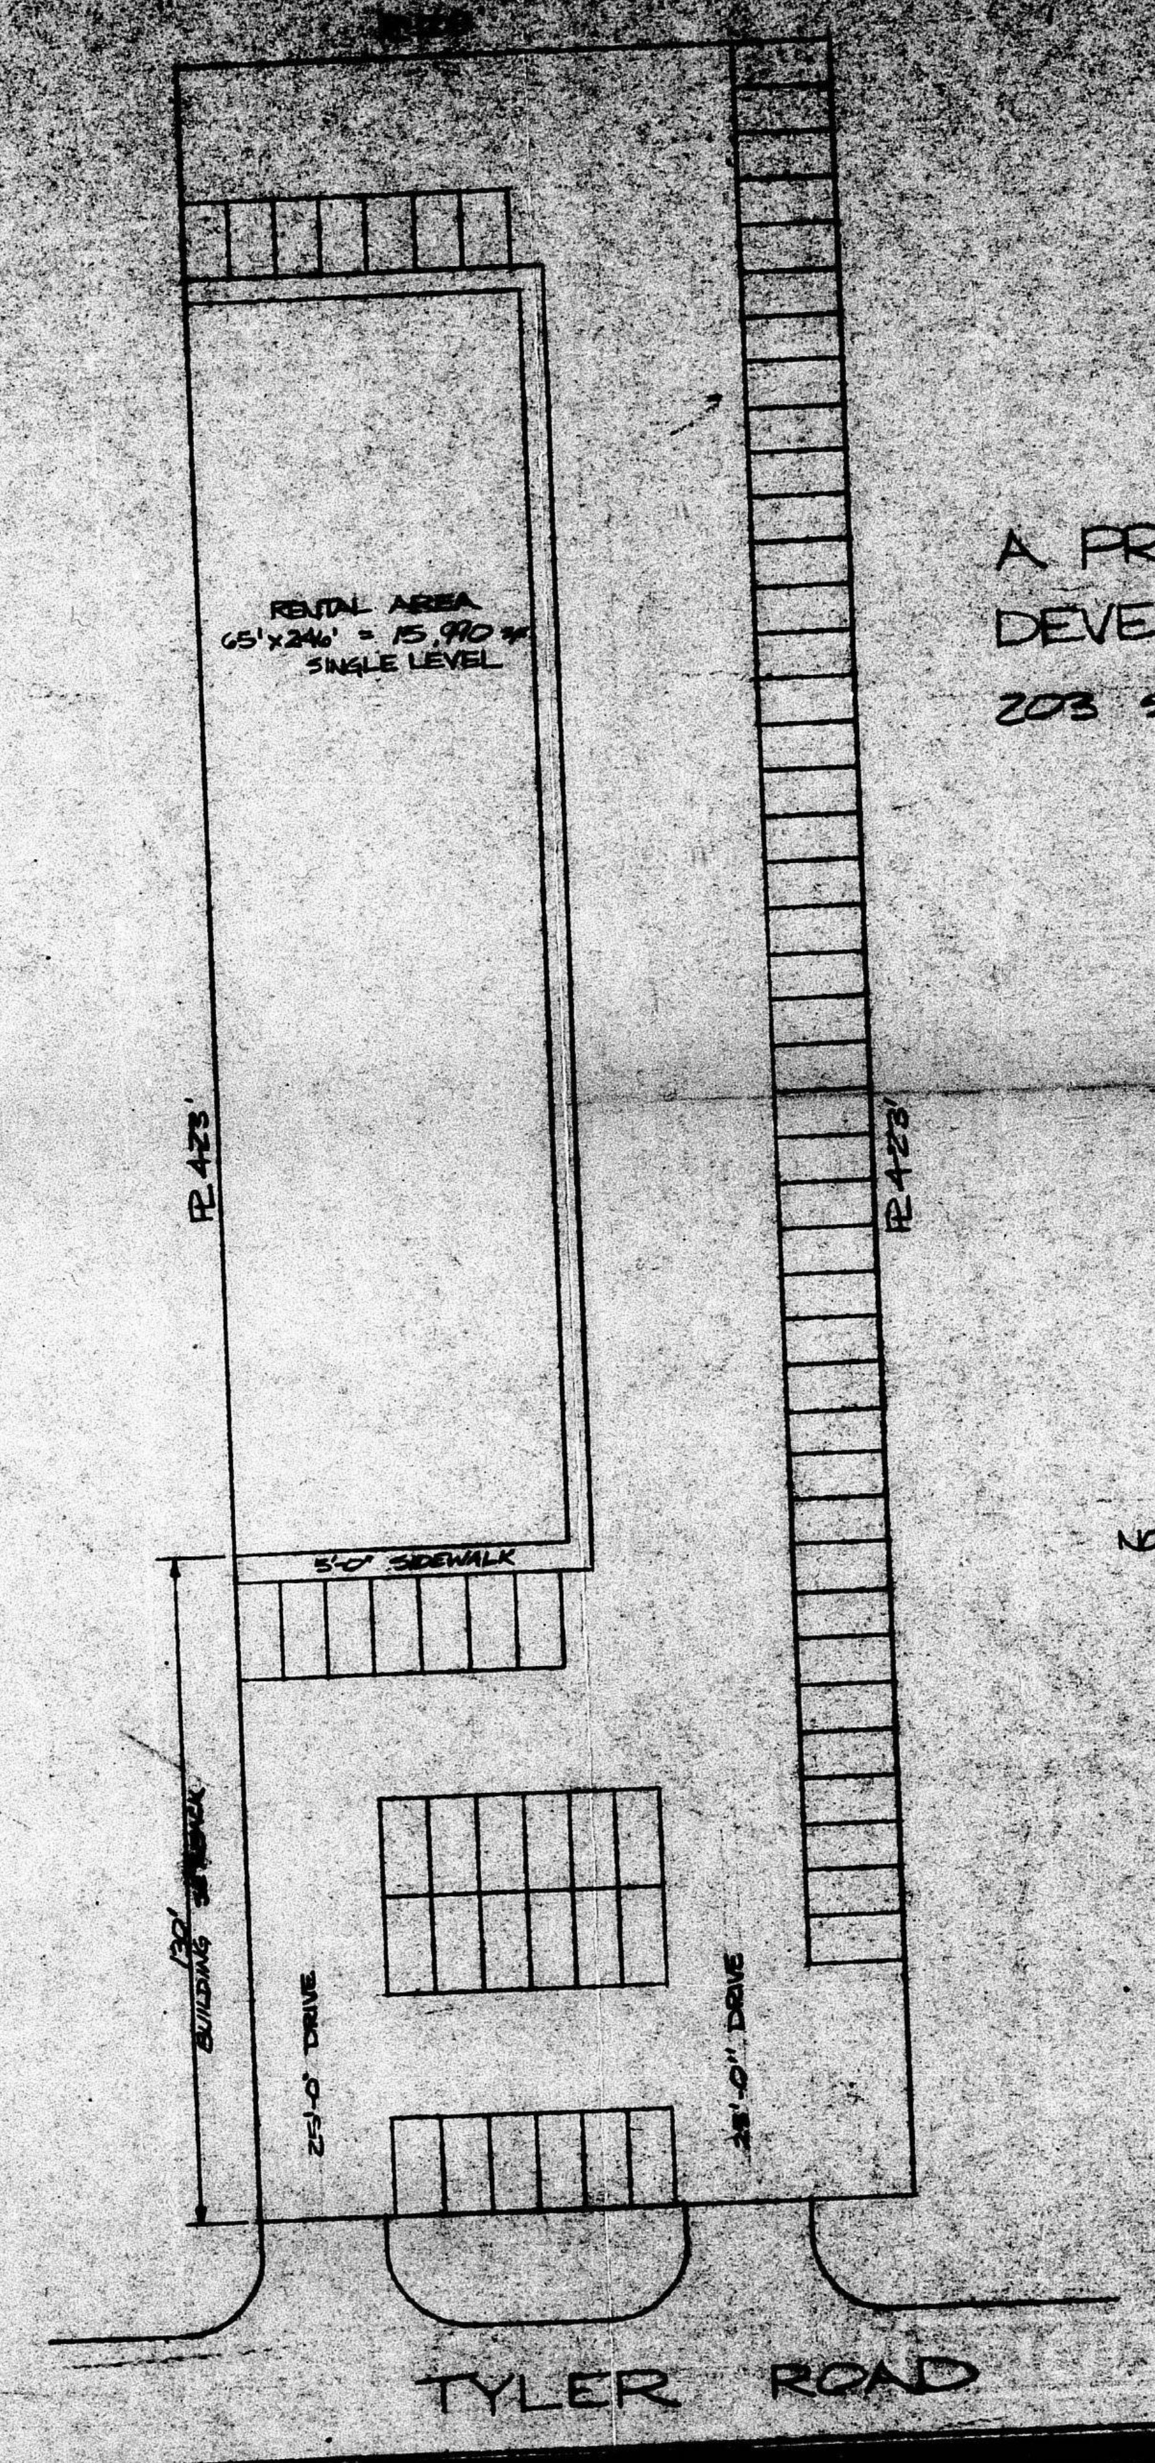

A PROPOSED COMMERIAL
DEVELOPMENT LOCATED AT
203 SOUTH TYLER WICHITA, KS.

SITE PLAN

N

NOTES:
PARKING REQ'D - 64 CARS
PARKING SHOWN - 74 CARS

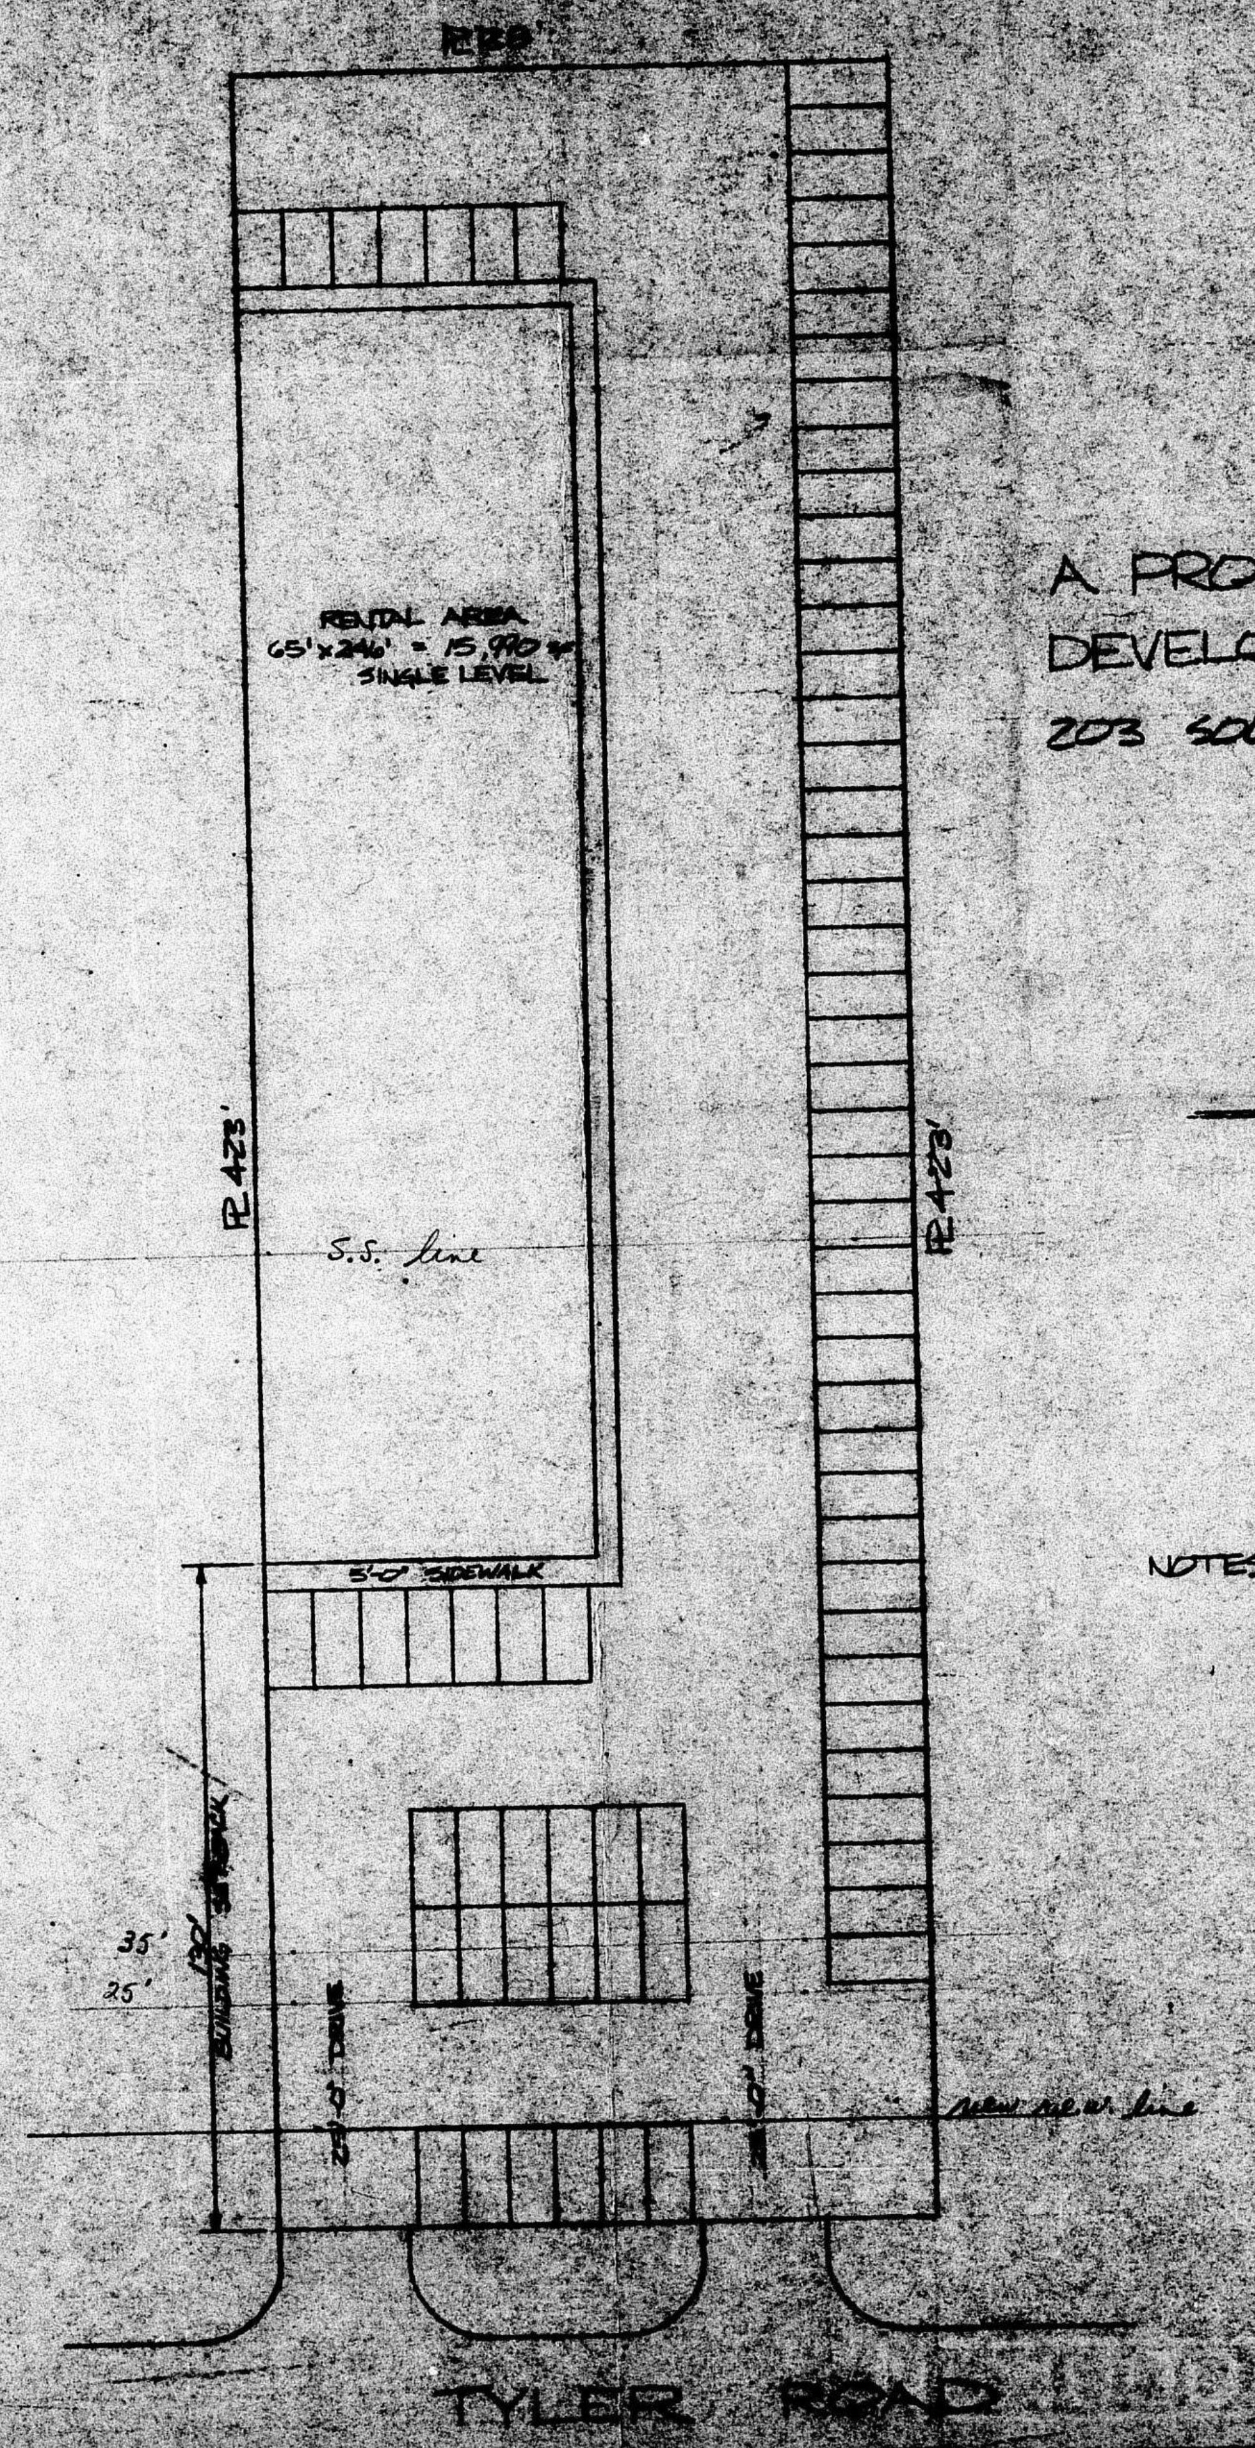

A PROPOSED COMMERIAL
DEVELOPMENT LOCATED AT
203 SOUTH TYLER WICHITA, KS

SITE PLAN

SCALE 1"=30'-0"

NOTES:
PARKING REQ'D - 64 CARS
PARKING SHOWN - 74 CARS

Revised plan

BZA7-78

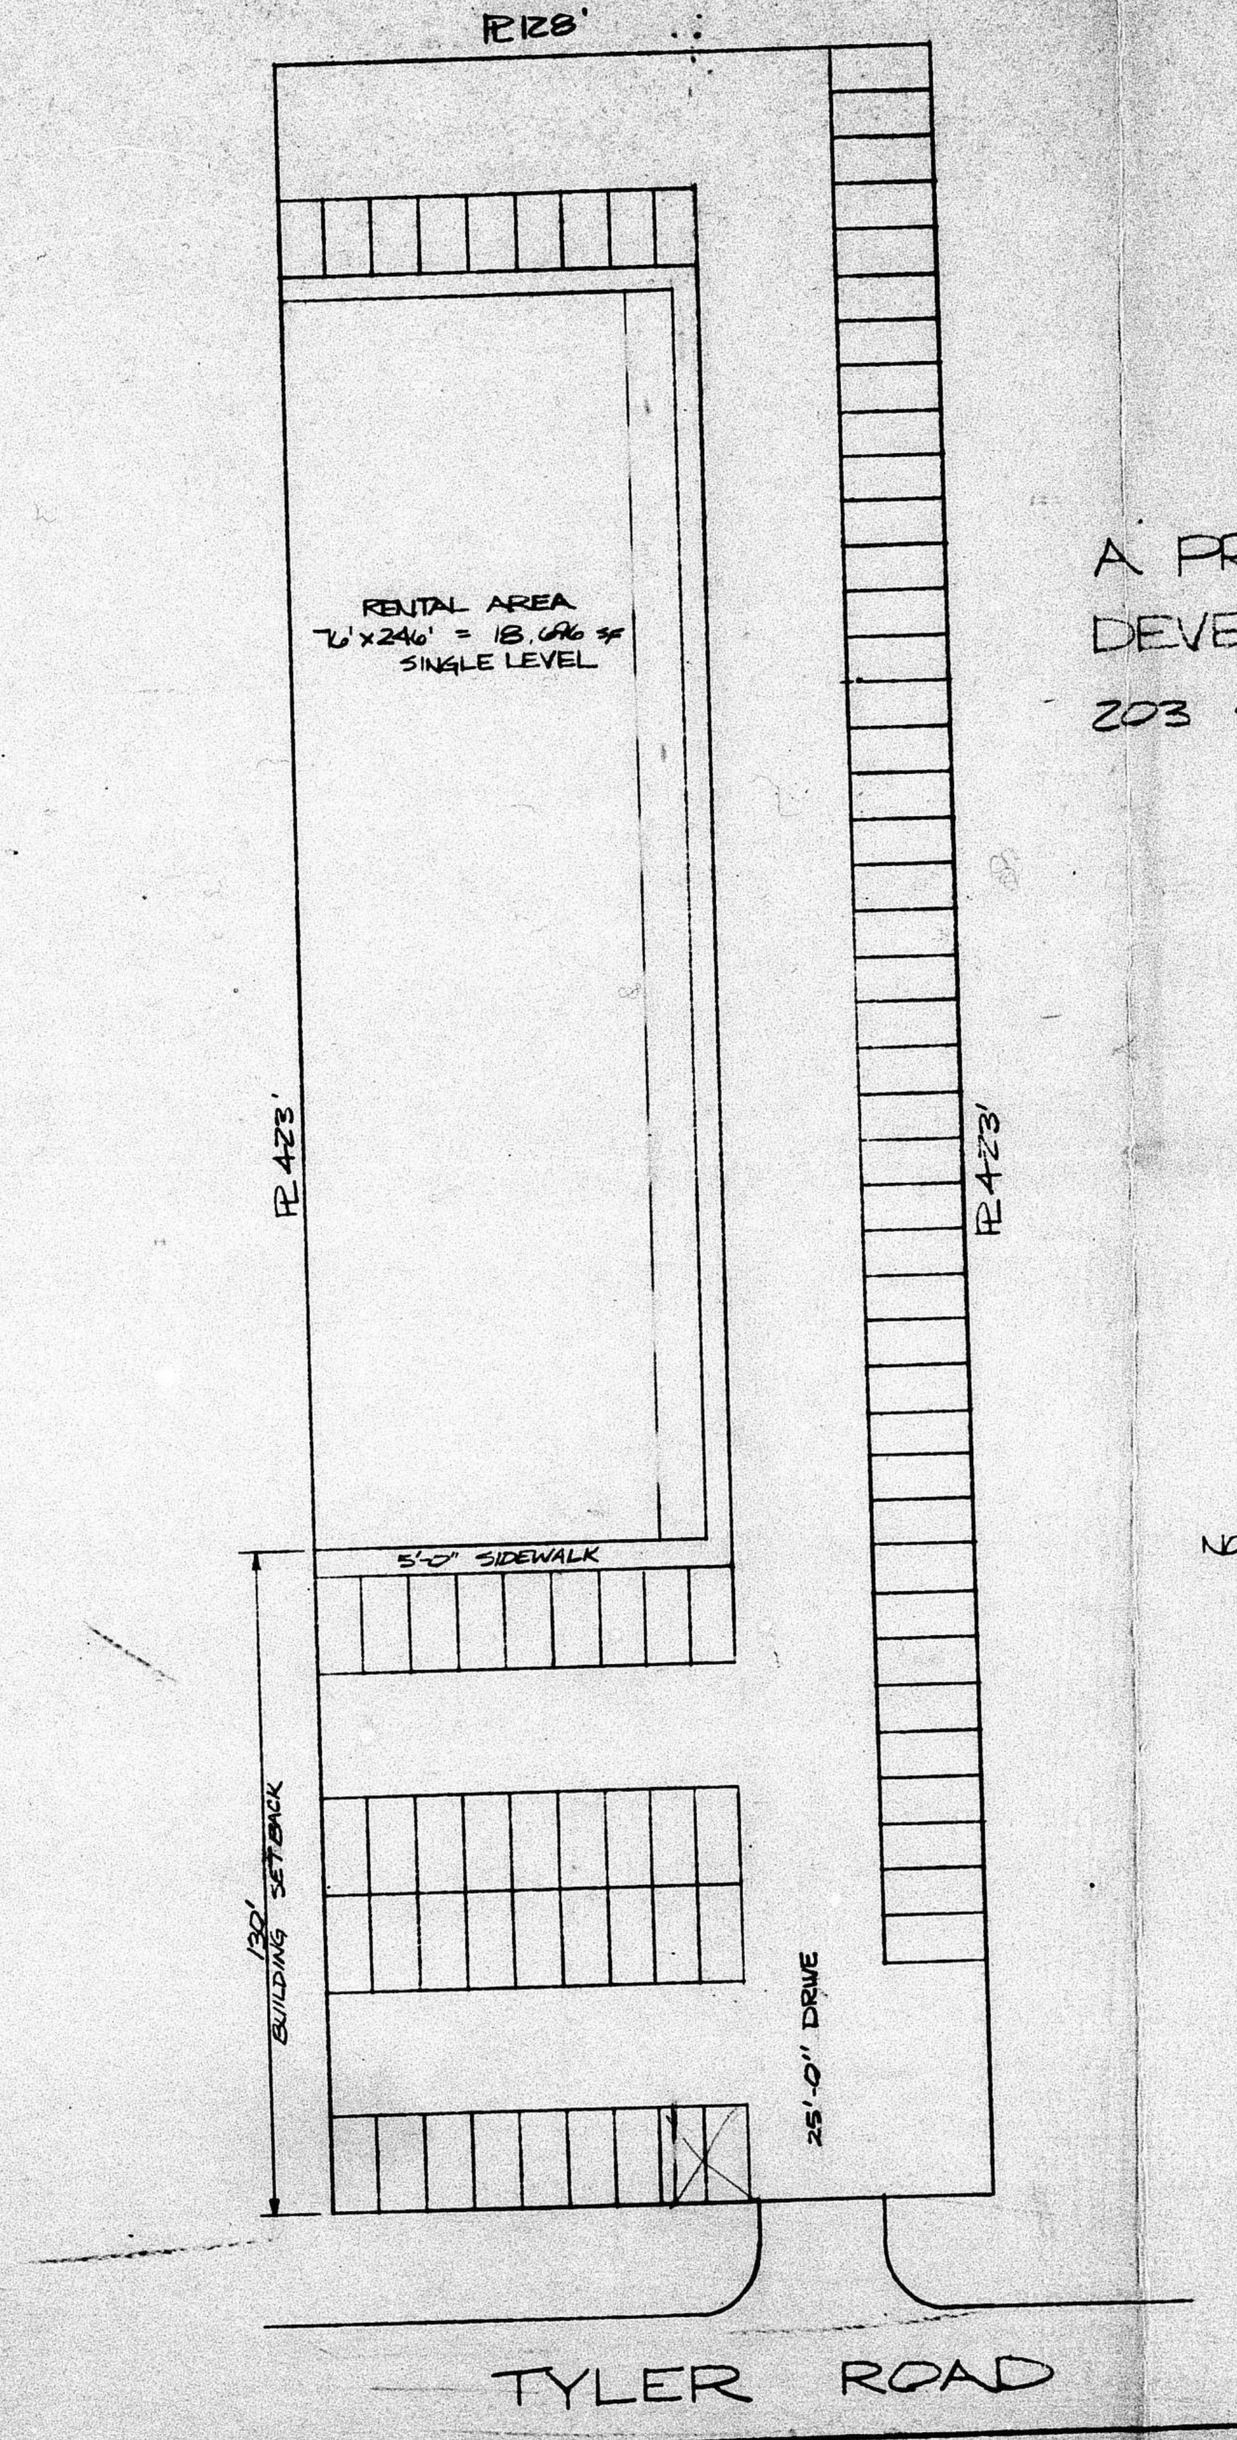

A PROPOSED COMMERIAL
DEVELOPMENT LOCATED AT
203 SOUTH TYLER WICHITA, KS.

SITE PLAN

SCALE 1"=30'-0"

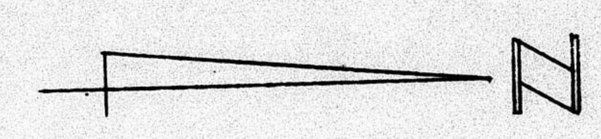

NOTES:
PARKING REQ'D - 79 CARS
PARKING SHOWN - 87 CARS

BZA 7-78

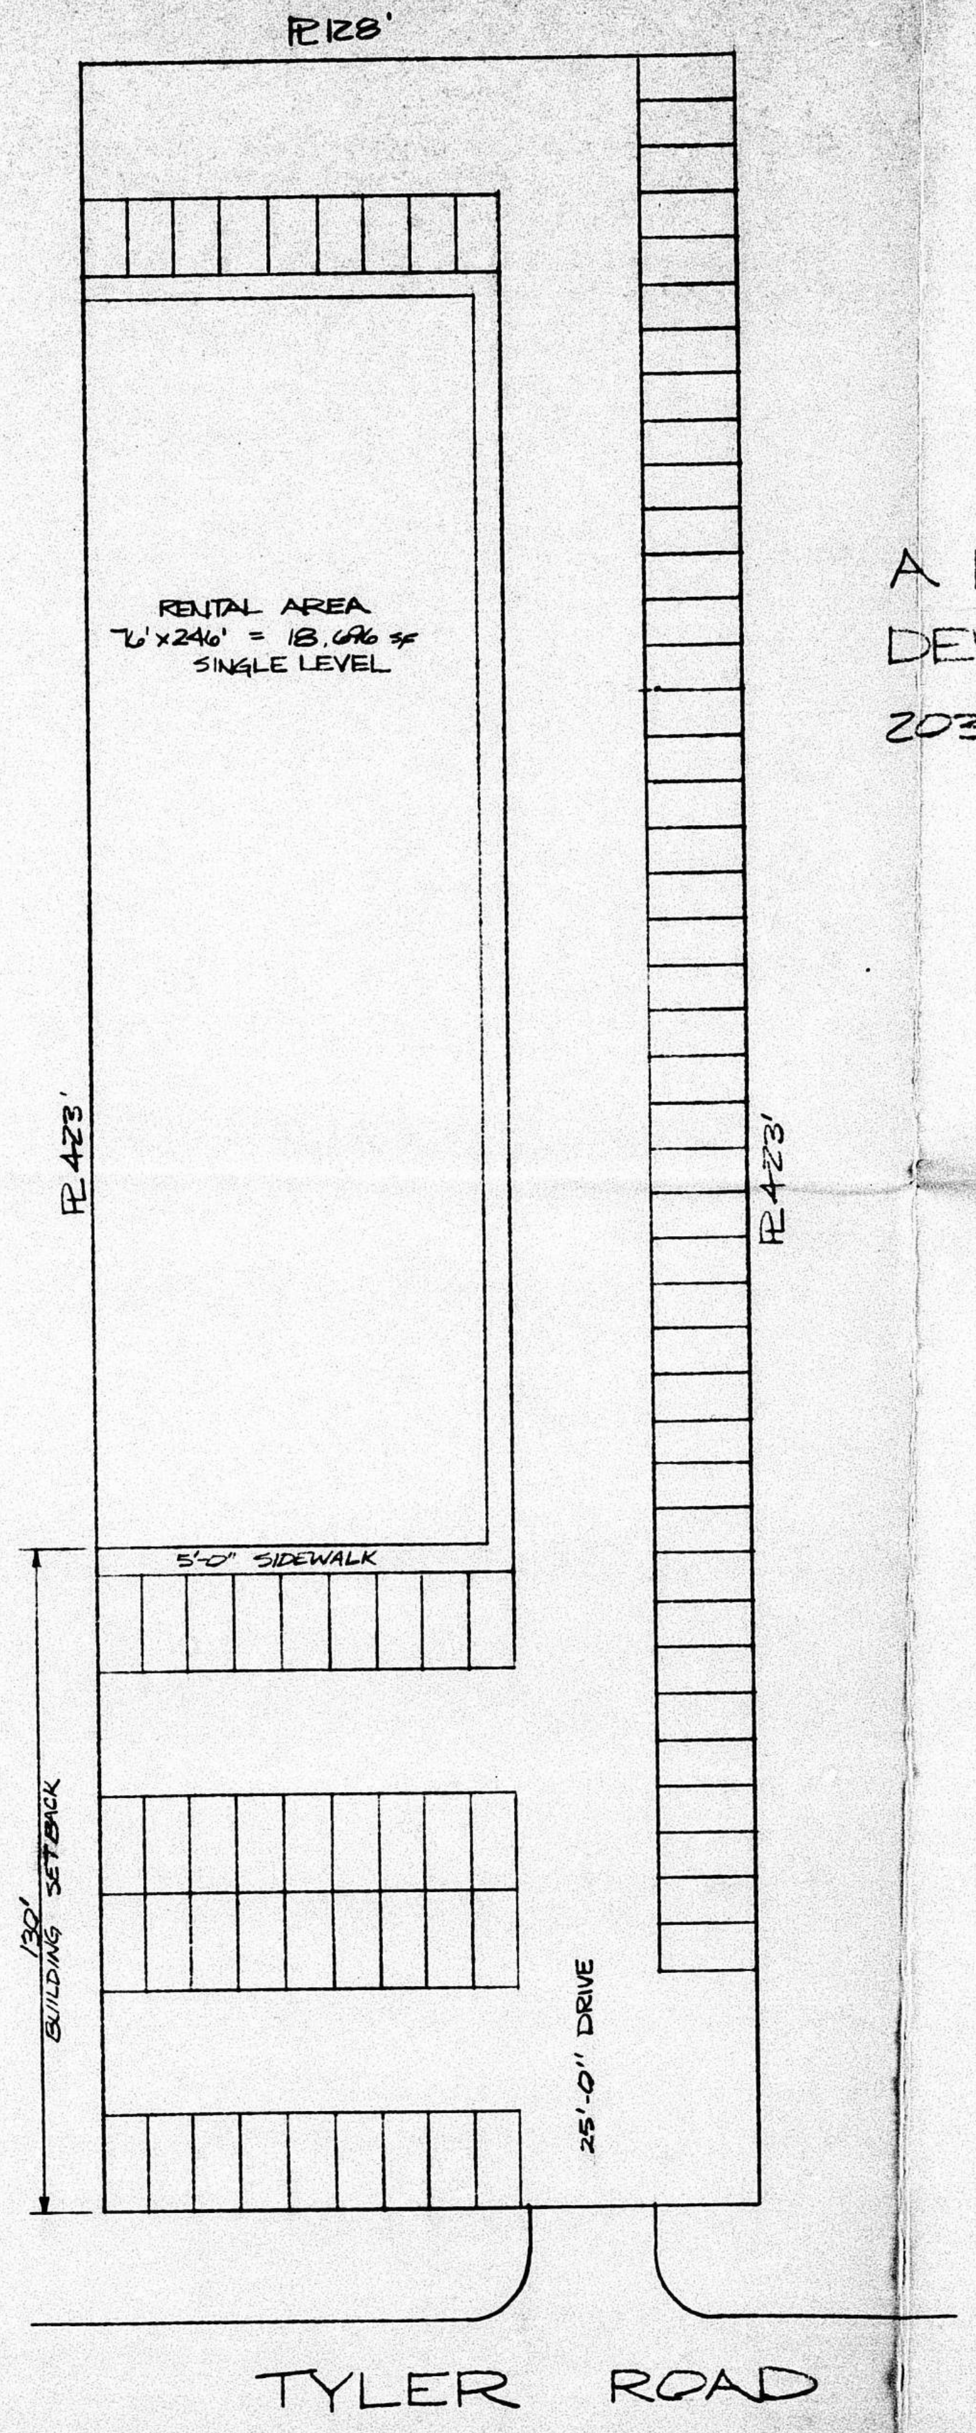

A PROPOSED COMMERIAL
DEVELOPMENT LOCATED AT
203 SOUTH TYLER WICHITA, KS.

SITE PLAN
SCALE 1"=30'-0"

NOTES:
PARKING REQ'D - 79 CARS
PARKING SHOWN - 87 CARS

BZA 7-78

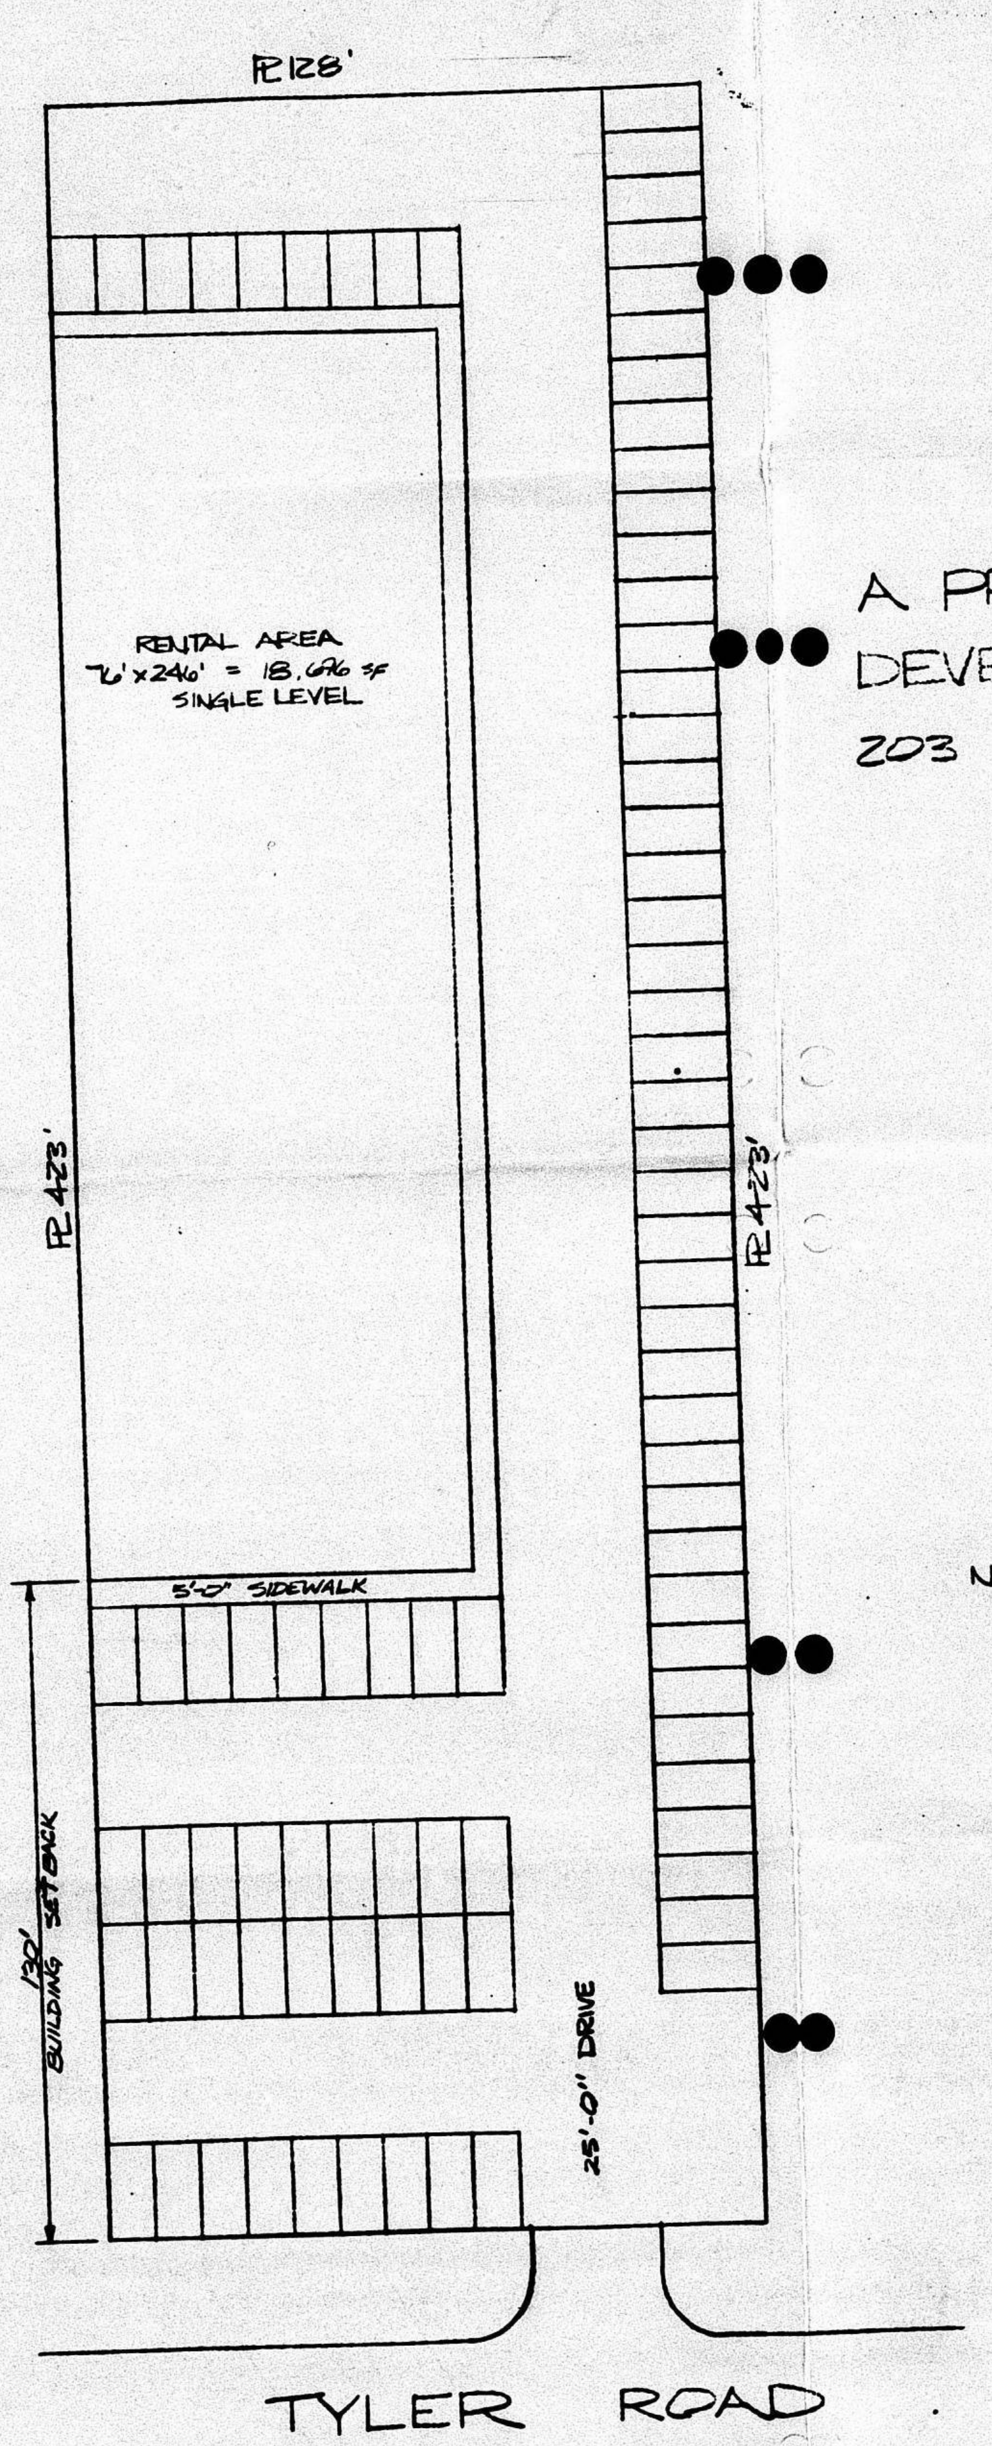

A PROPOSED COMMERIAL
DEVELOPMENT LOCATED AT
203 SOUTH TYLER WICHITA, KS.

SITE PLAN

SCALE 1"=30'-0"

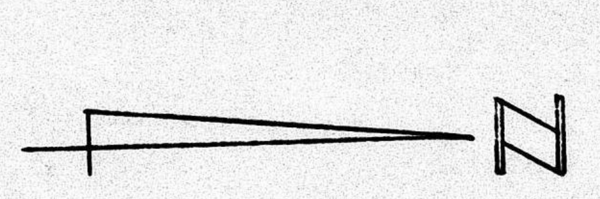

NOTES:

PARKING REQ'D - 79 CARS
PARKING SHOWN - 87 CARS

BZA - 7-78