
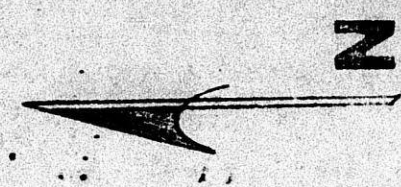


TRAFFIC ENGINEERING DIVISION APPROVED
 DATE: 12/16/71
 BY: [Signature]

1) Parking barriers shall be installed at all locations that are adjacent to public property (so that vehicles will not obstruct public property) and have a minimum length of 6 feet and a minimum cross section of 4" x 4".
 2) Stall lines shall be painted and 4" or greater in width.
 3) Proper ingress and egress signs shall be installed on private property at the entrances and exits of the parking facility.

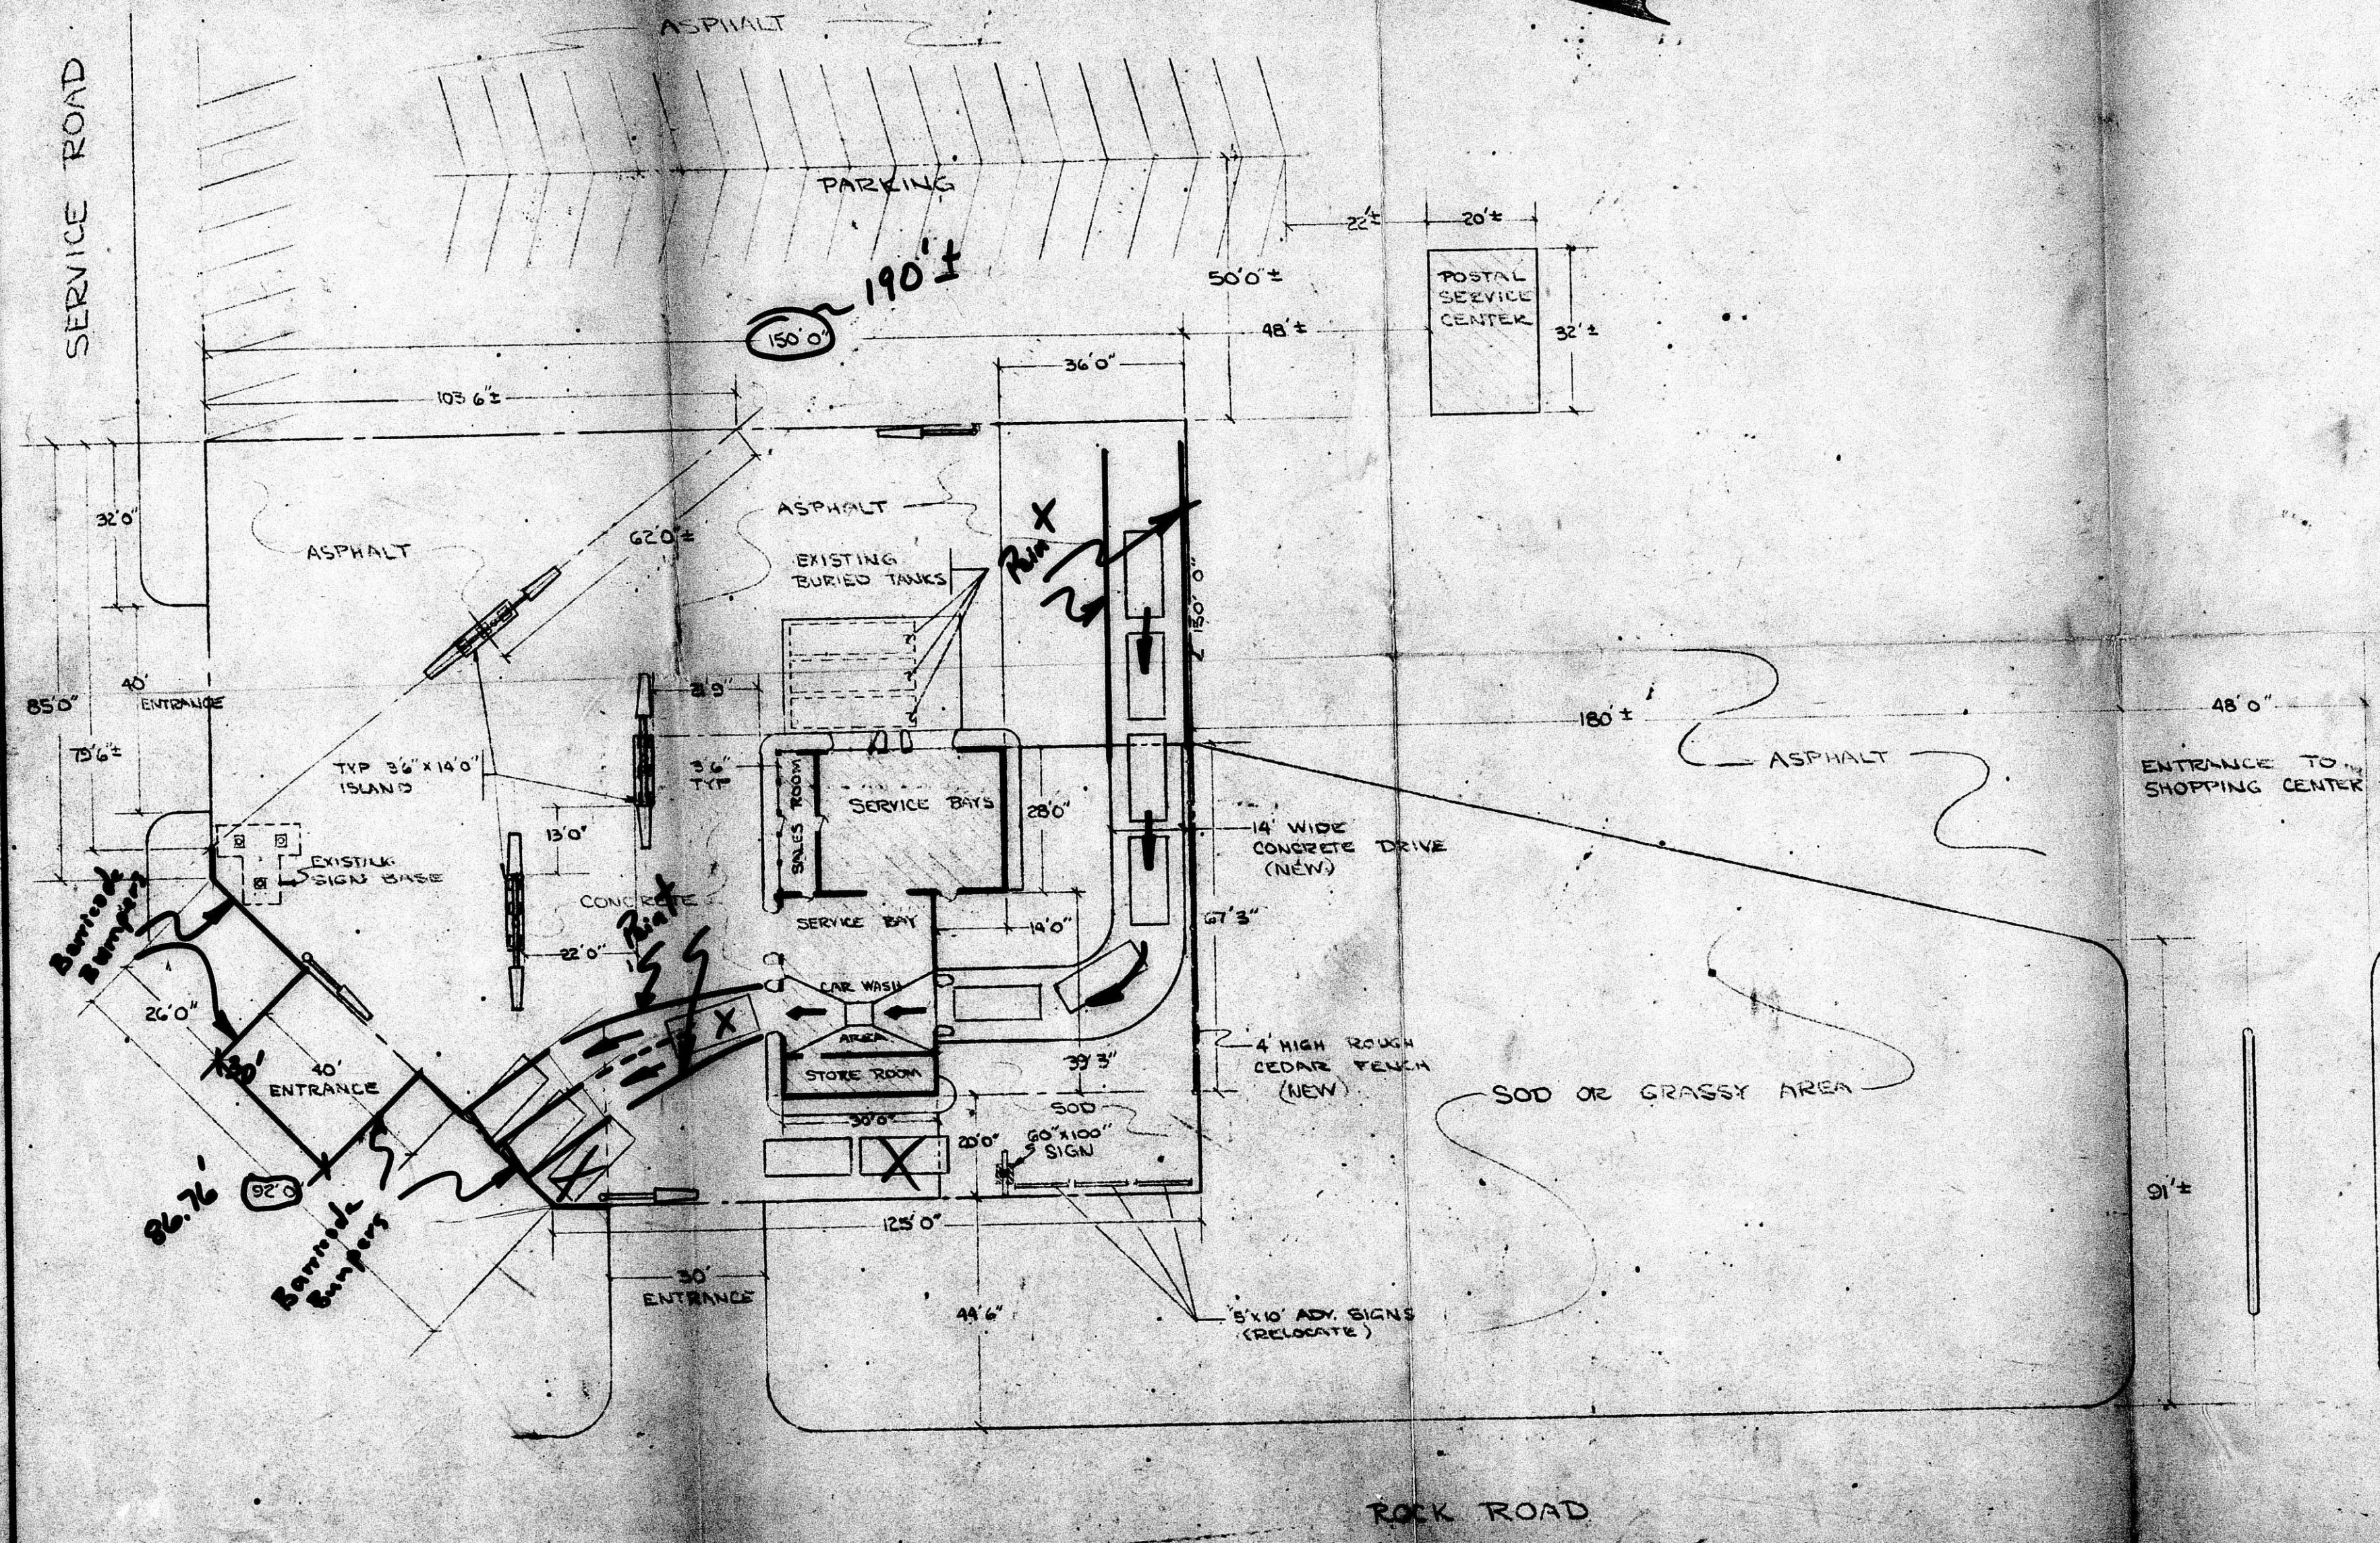

DATE	REVISION	BY


BZA 12-71

PROPOSED REVISION	
CITY WICHITA, KANS.	12-71
STREET KAWOCC & ROCK RD.	12-71
STANDARD OIL	
DIVISION OF AMERICAN OIL COMPANY	
KANSAS CITY REGION	
REVIEWED BY	DATE
APPROVAL	
DESIGN	
MARKETING	
SALES	
DATE	

FILMED FROM THE BEST AVAILABLE COPY

TRAFFIC ENGINEERING DIVISION APPROVED
 Date: *9/2/71*
 (A) Parking barriers shall be installed at all locations that are adjacent to public property (so that vehicles will not obstruct public property) and have a minimum length of 6 feet and a minimum cross section of 4" x 4".
 (B) Stall lines shall be painted and 4" or greater in width.
 (C) Proper ingress and egress signs shall be installed on private property at the entrances and exits of the parking facility.

DATE	REVISION	BY

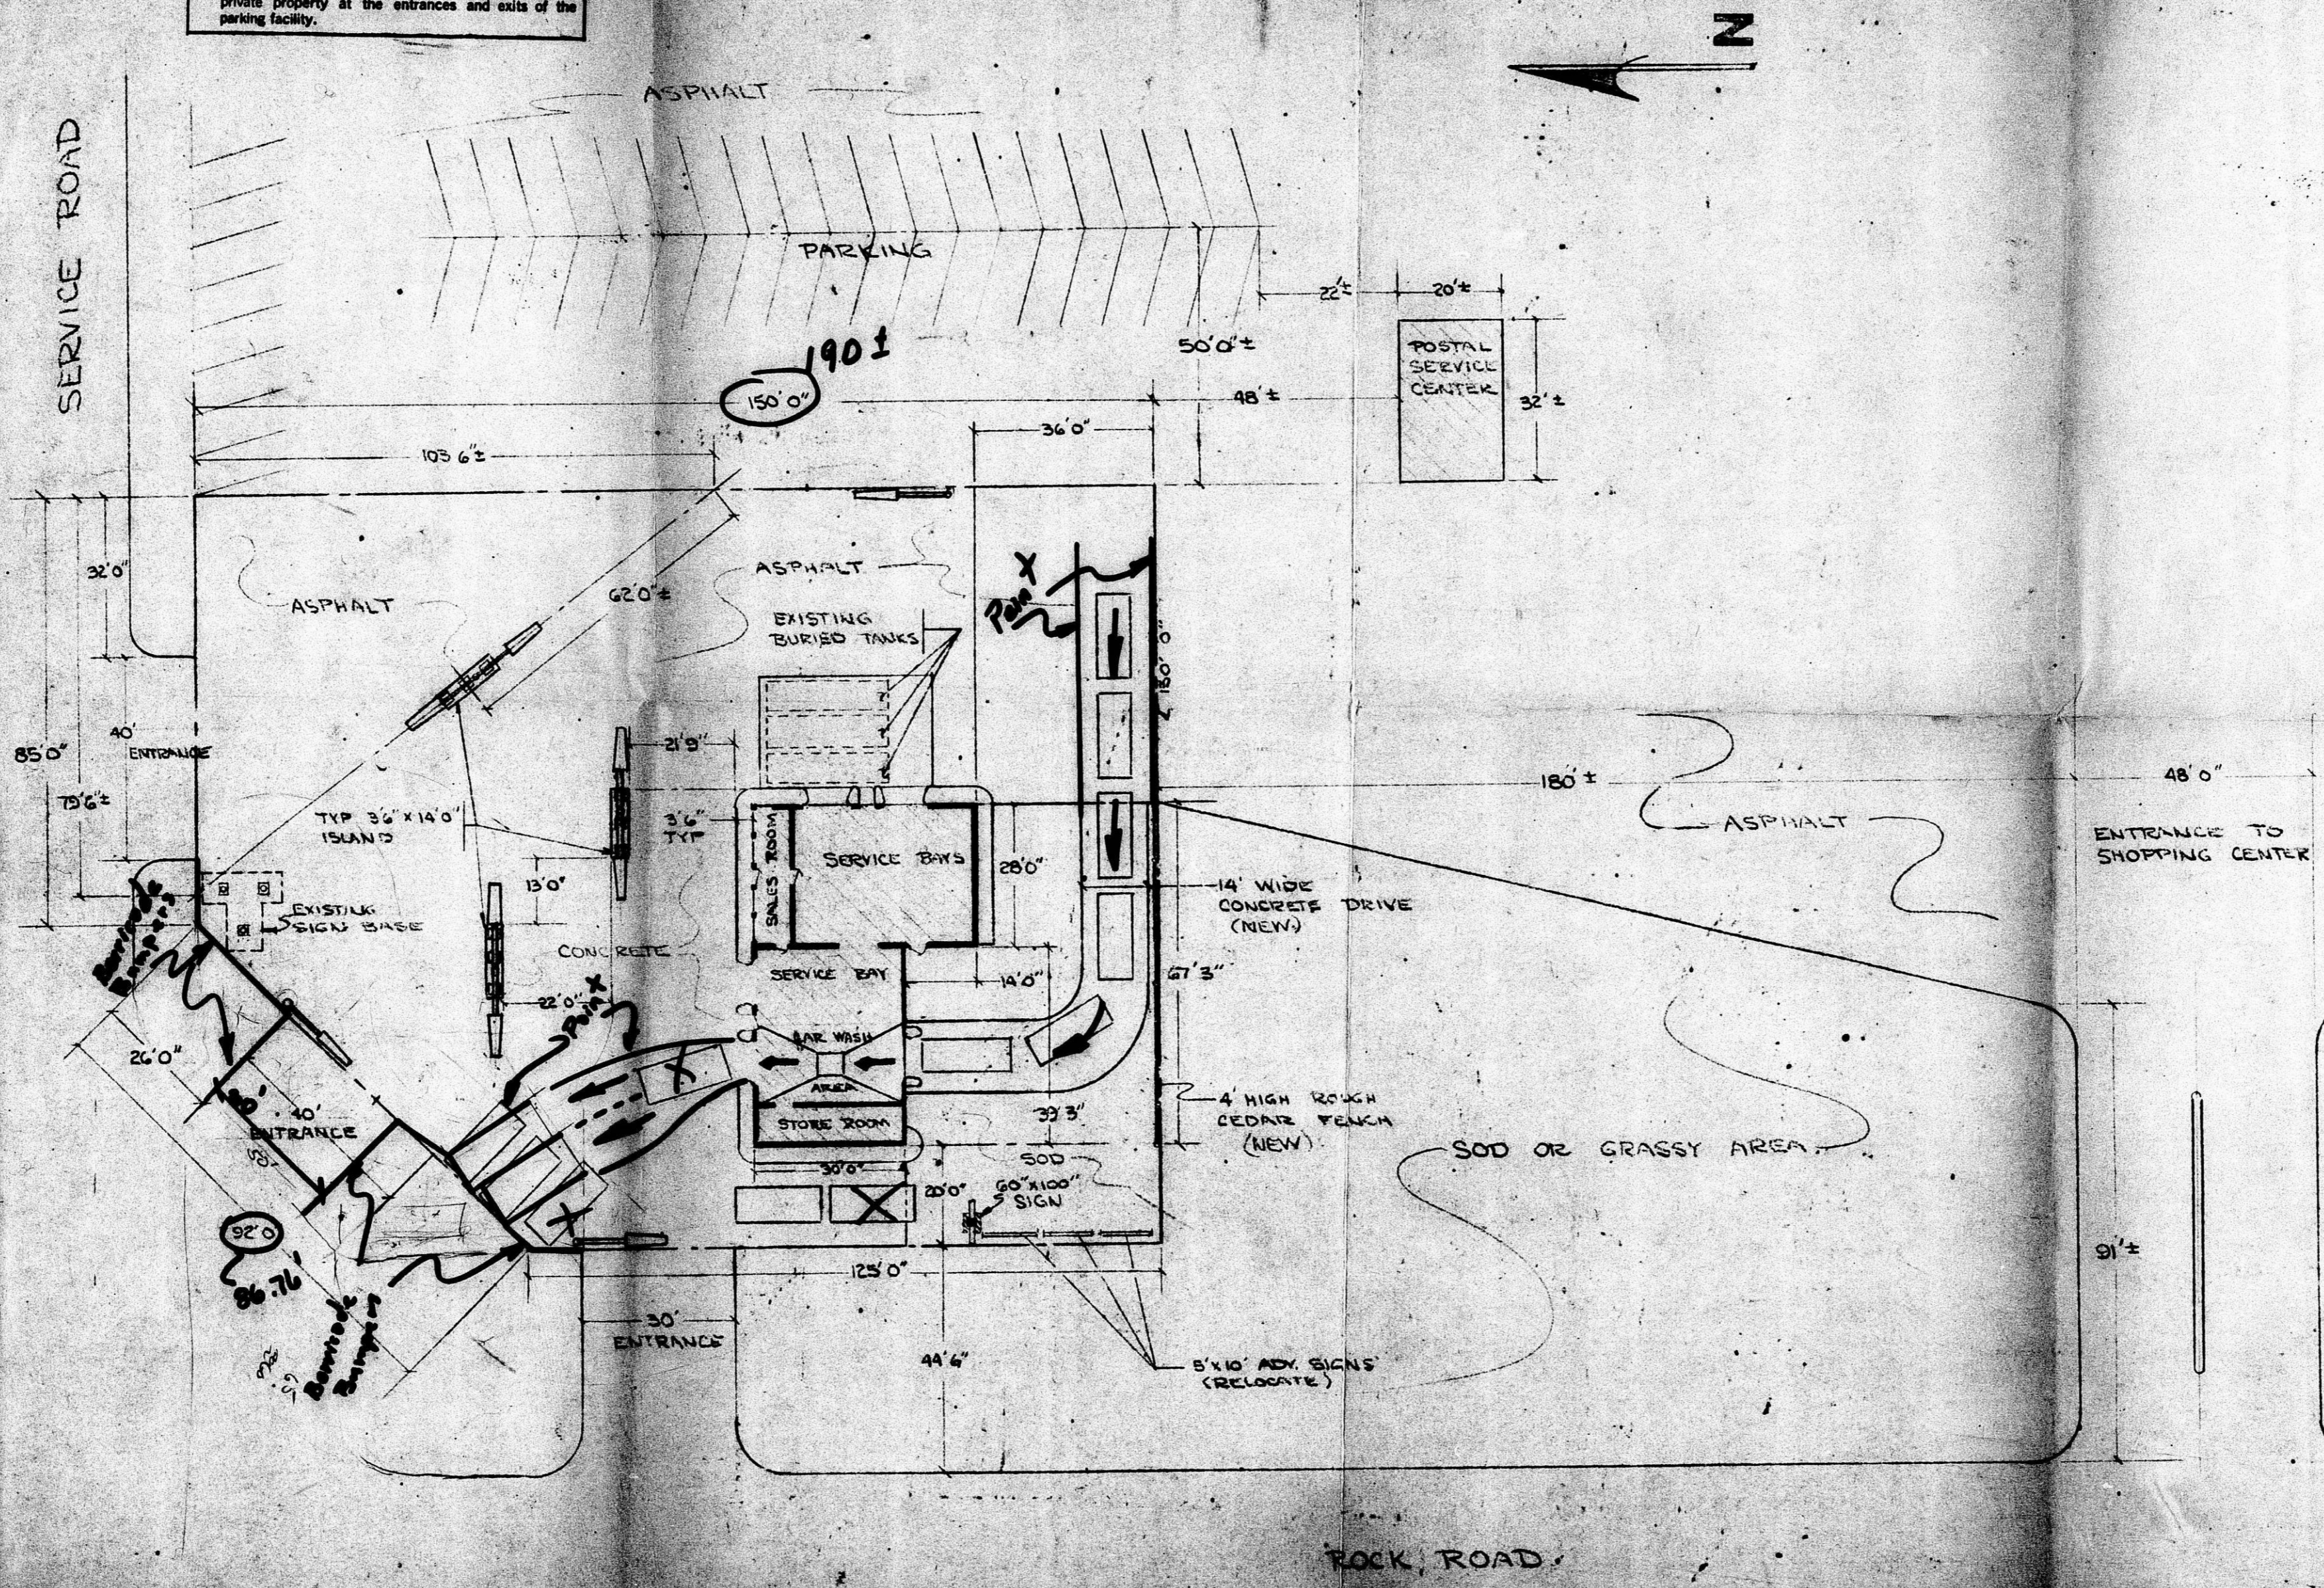

BZA 12-71

PROPOSED REVISION	
CITY WICHITA, KANS.	FILE NO.
STREET KEY LOC. # 2000, Bldg. 2	NO. 12
STANDARD OIL	
DIVISION OF AMERICAN OIL COMPANY	
KANSAS CITY OFFICE	
REVIEWED BY	DATE
REGIONAL ENGINEER	
REAL ESTATE MGR.	
MARKETING MANAGER	
OPERATIONS MANAGER	
GENERAL MANAGER	
SCALE 1/8" = 1'-0"	CHECKED BY
DATE 9-1-71	AREA ENGR.
DRAWN BY J.L.A.	DATE

FILMED FROM THE BEST AVAILABLE COPY