LOT SPLIT

LOTS 3, 4, 5, 6 & 7, BK B BROADMOOR ADDITION TO WICHITA, SEDGWICK COUNTY, KANSAS.

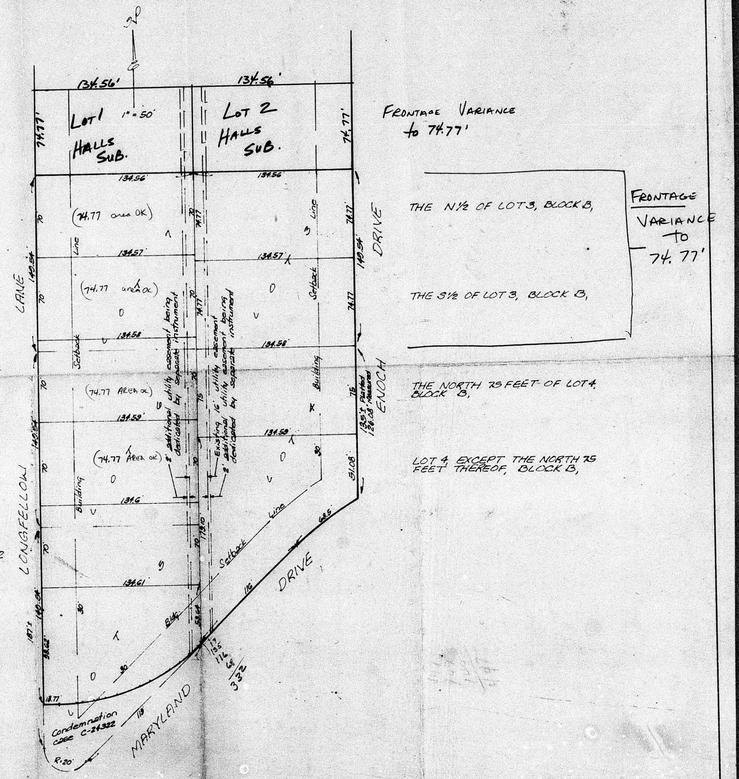
N
1" = 50'
134.56'
134.56'
Lot 1
Halls Sub.
Lot 2
Halls Sub.
74.77'
74.77'
134.56
134.56
(74.77 area OK)
134.57
134.57
(74.77 area OK)
134.54
134.54
(74.77 area OK)
134.50
134.50
(74.77 area OK)
134.6
134.61
Setback
Building
Setback
Building
Setback
Building
Setback
Building
Condemnation Case C-24322
LANE
LONGFELLOW
MARYLAND
DRIVE
ENOCH
DRIVE
140.84
140.84
140.84