


BZA 12-88

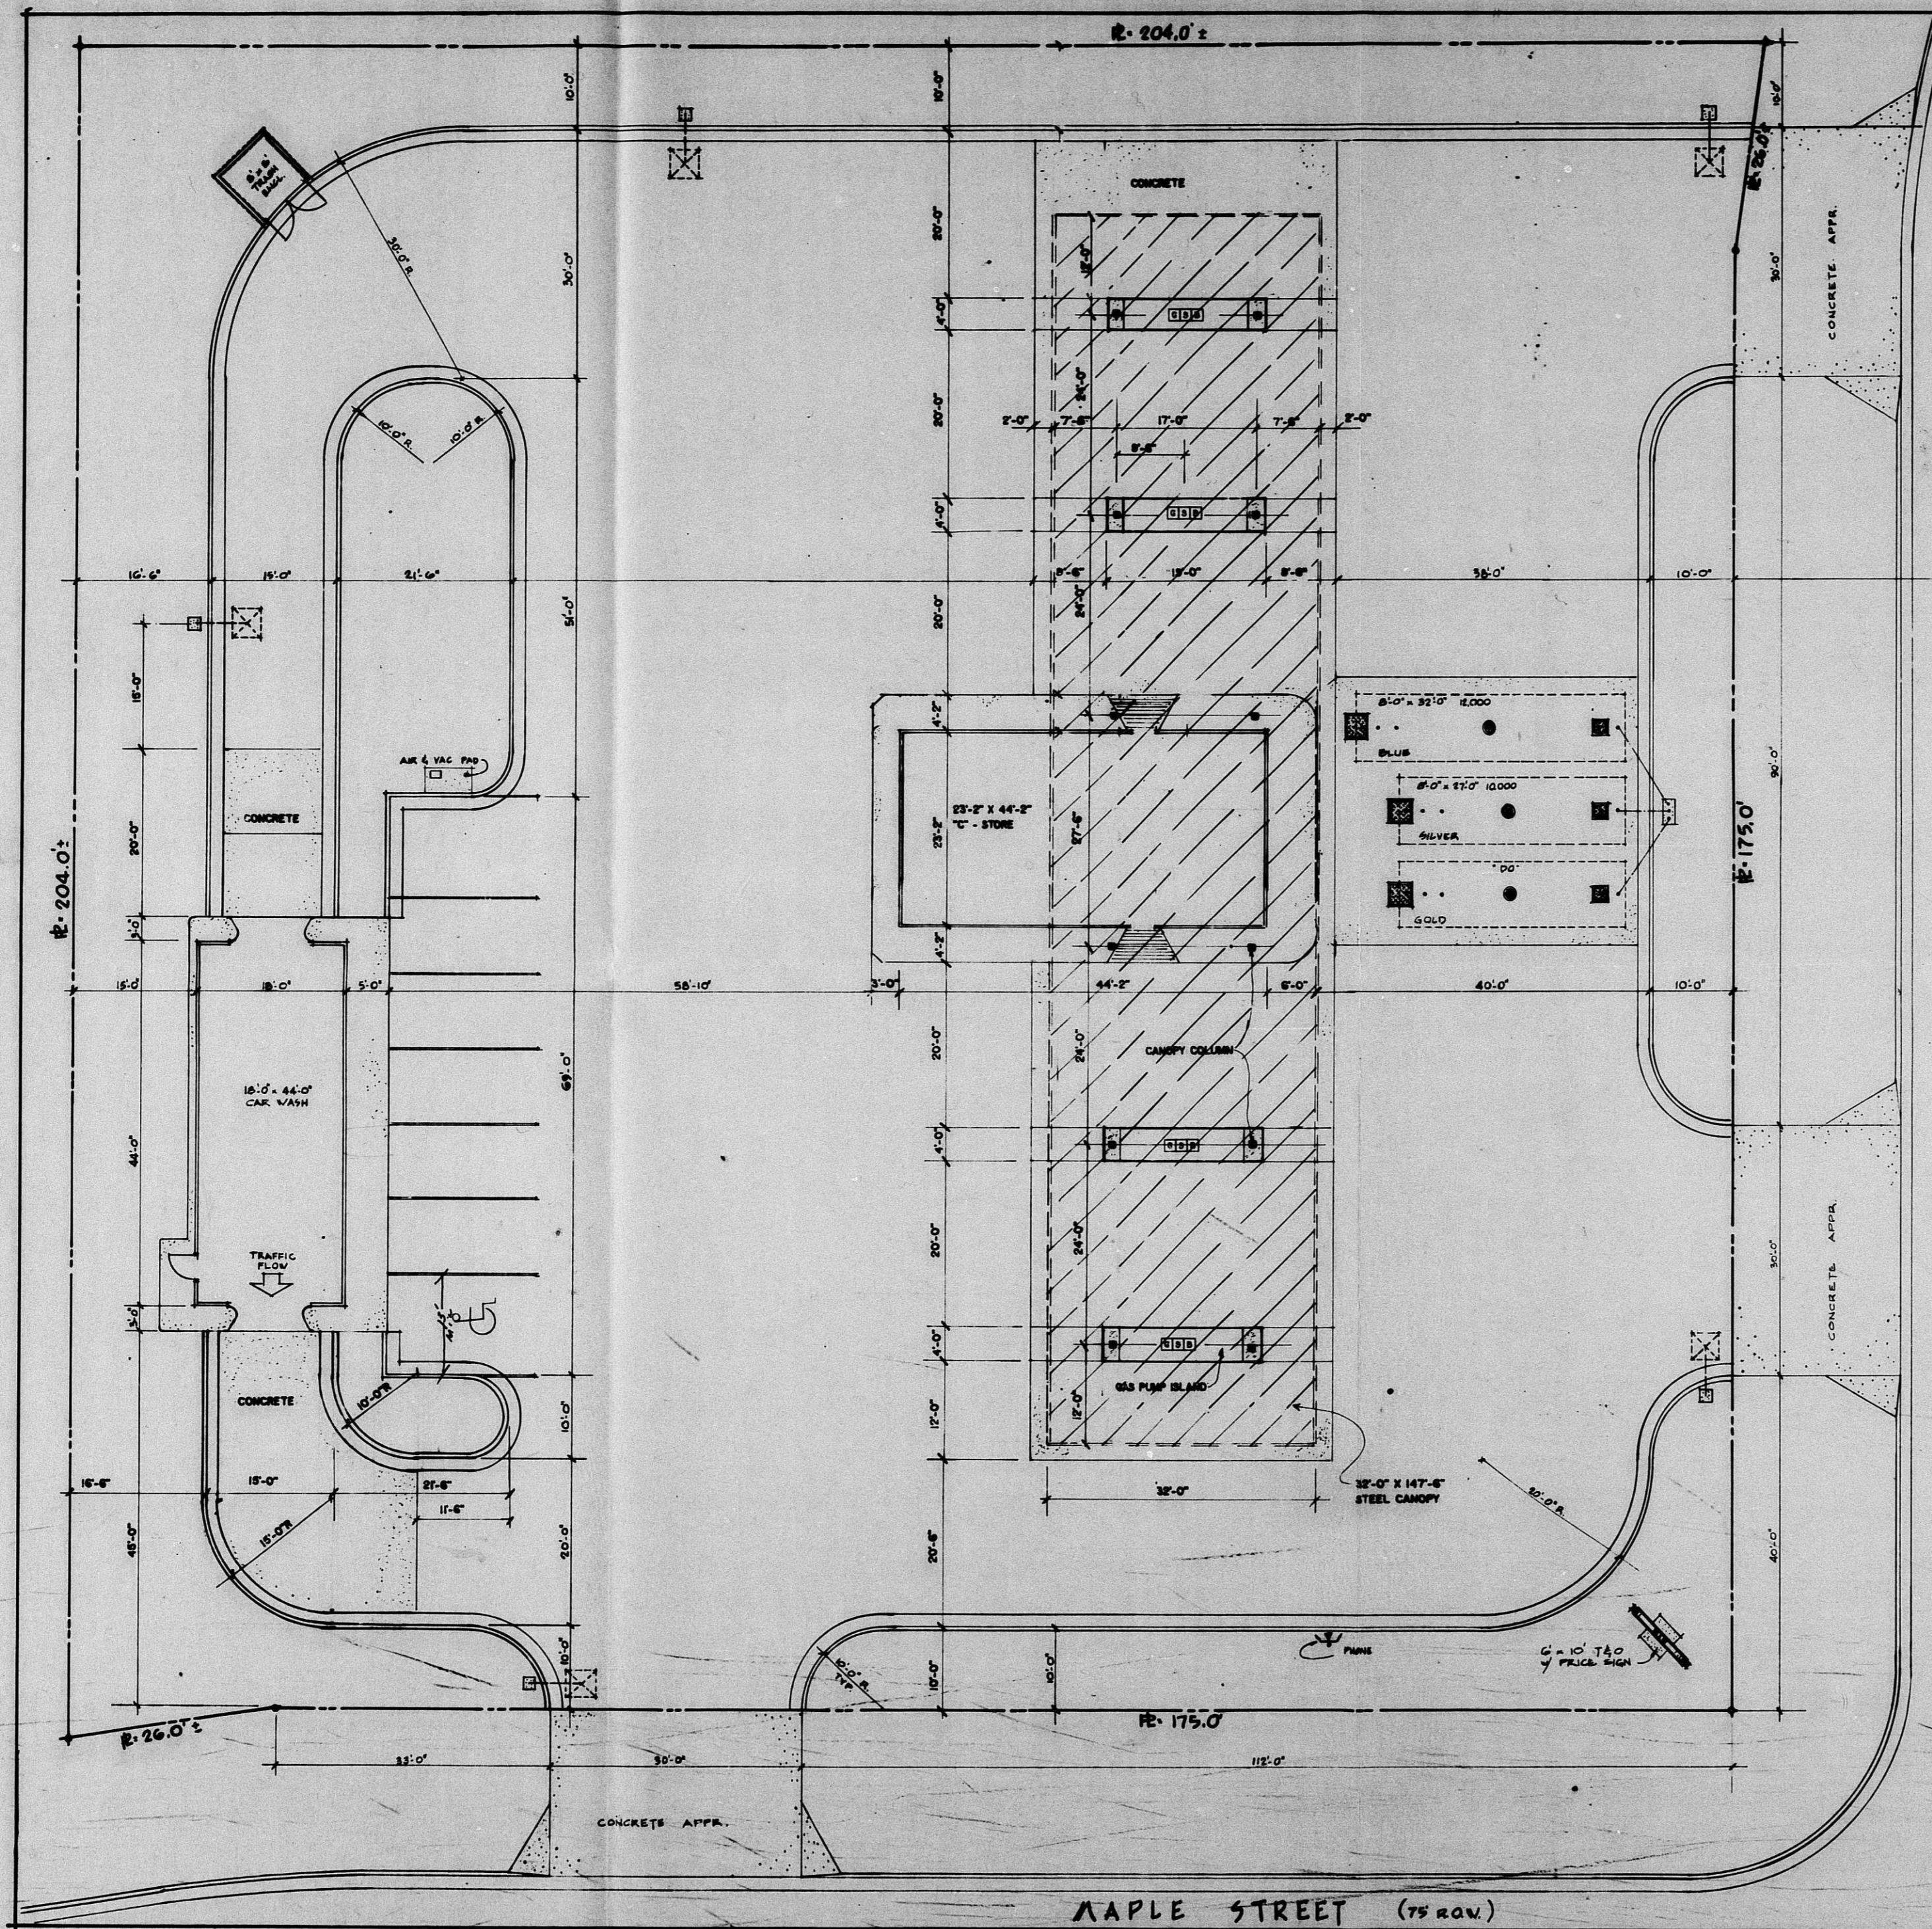

*Proposed Plan
Ok for BZA
At 10:30 AM
2-3-88*

□ GOLD, SILVER, BLUE GAS PUMPS

BZA 12-88

YOUNESS & ASSOCIATES CONSULTING ENGINEERS		1850 WEST 85th STREET LENEXA, KANSAS 66214 (913) 492-9584	
2-24-88		SERVICE STATION SITE PLAN MAPLE ST. & MAIZE ST. WICHITA, KANSAS	
1	INCREASE CANOPY TO 32' MOOREY C.W. EXT.	RYL	Scale 1" = 10'-0"
Date	No.	Revisions	By
Ammons Oil Company		Checked By	YOUNESS
Marketing - Design Engineering		Approved	DATE
200 East Randolph Drive		FEBRUARY 9, 1988	
Chicago, Illinois 60601		DRAWING C-1	
Do Not Scale - Use Dimensions Only			

MAPD COPY 101