


KANSAS MASONIC HOME

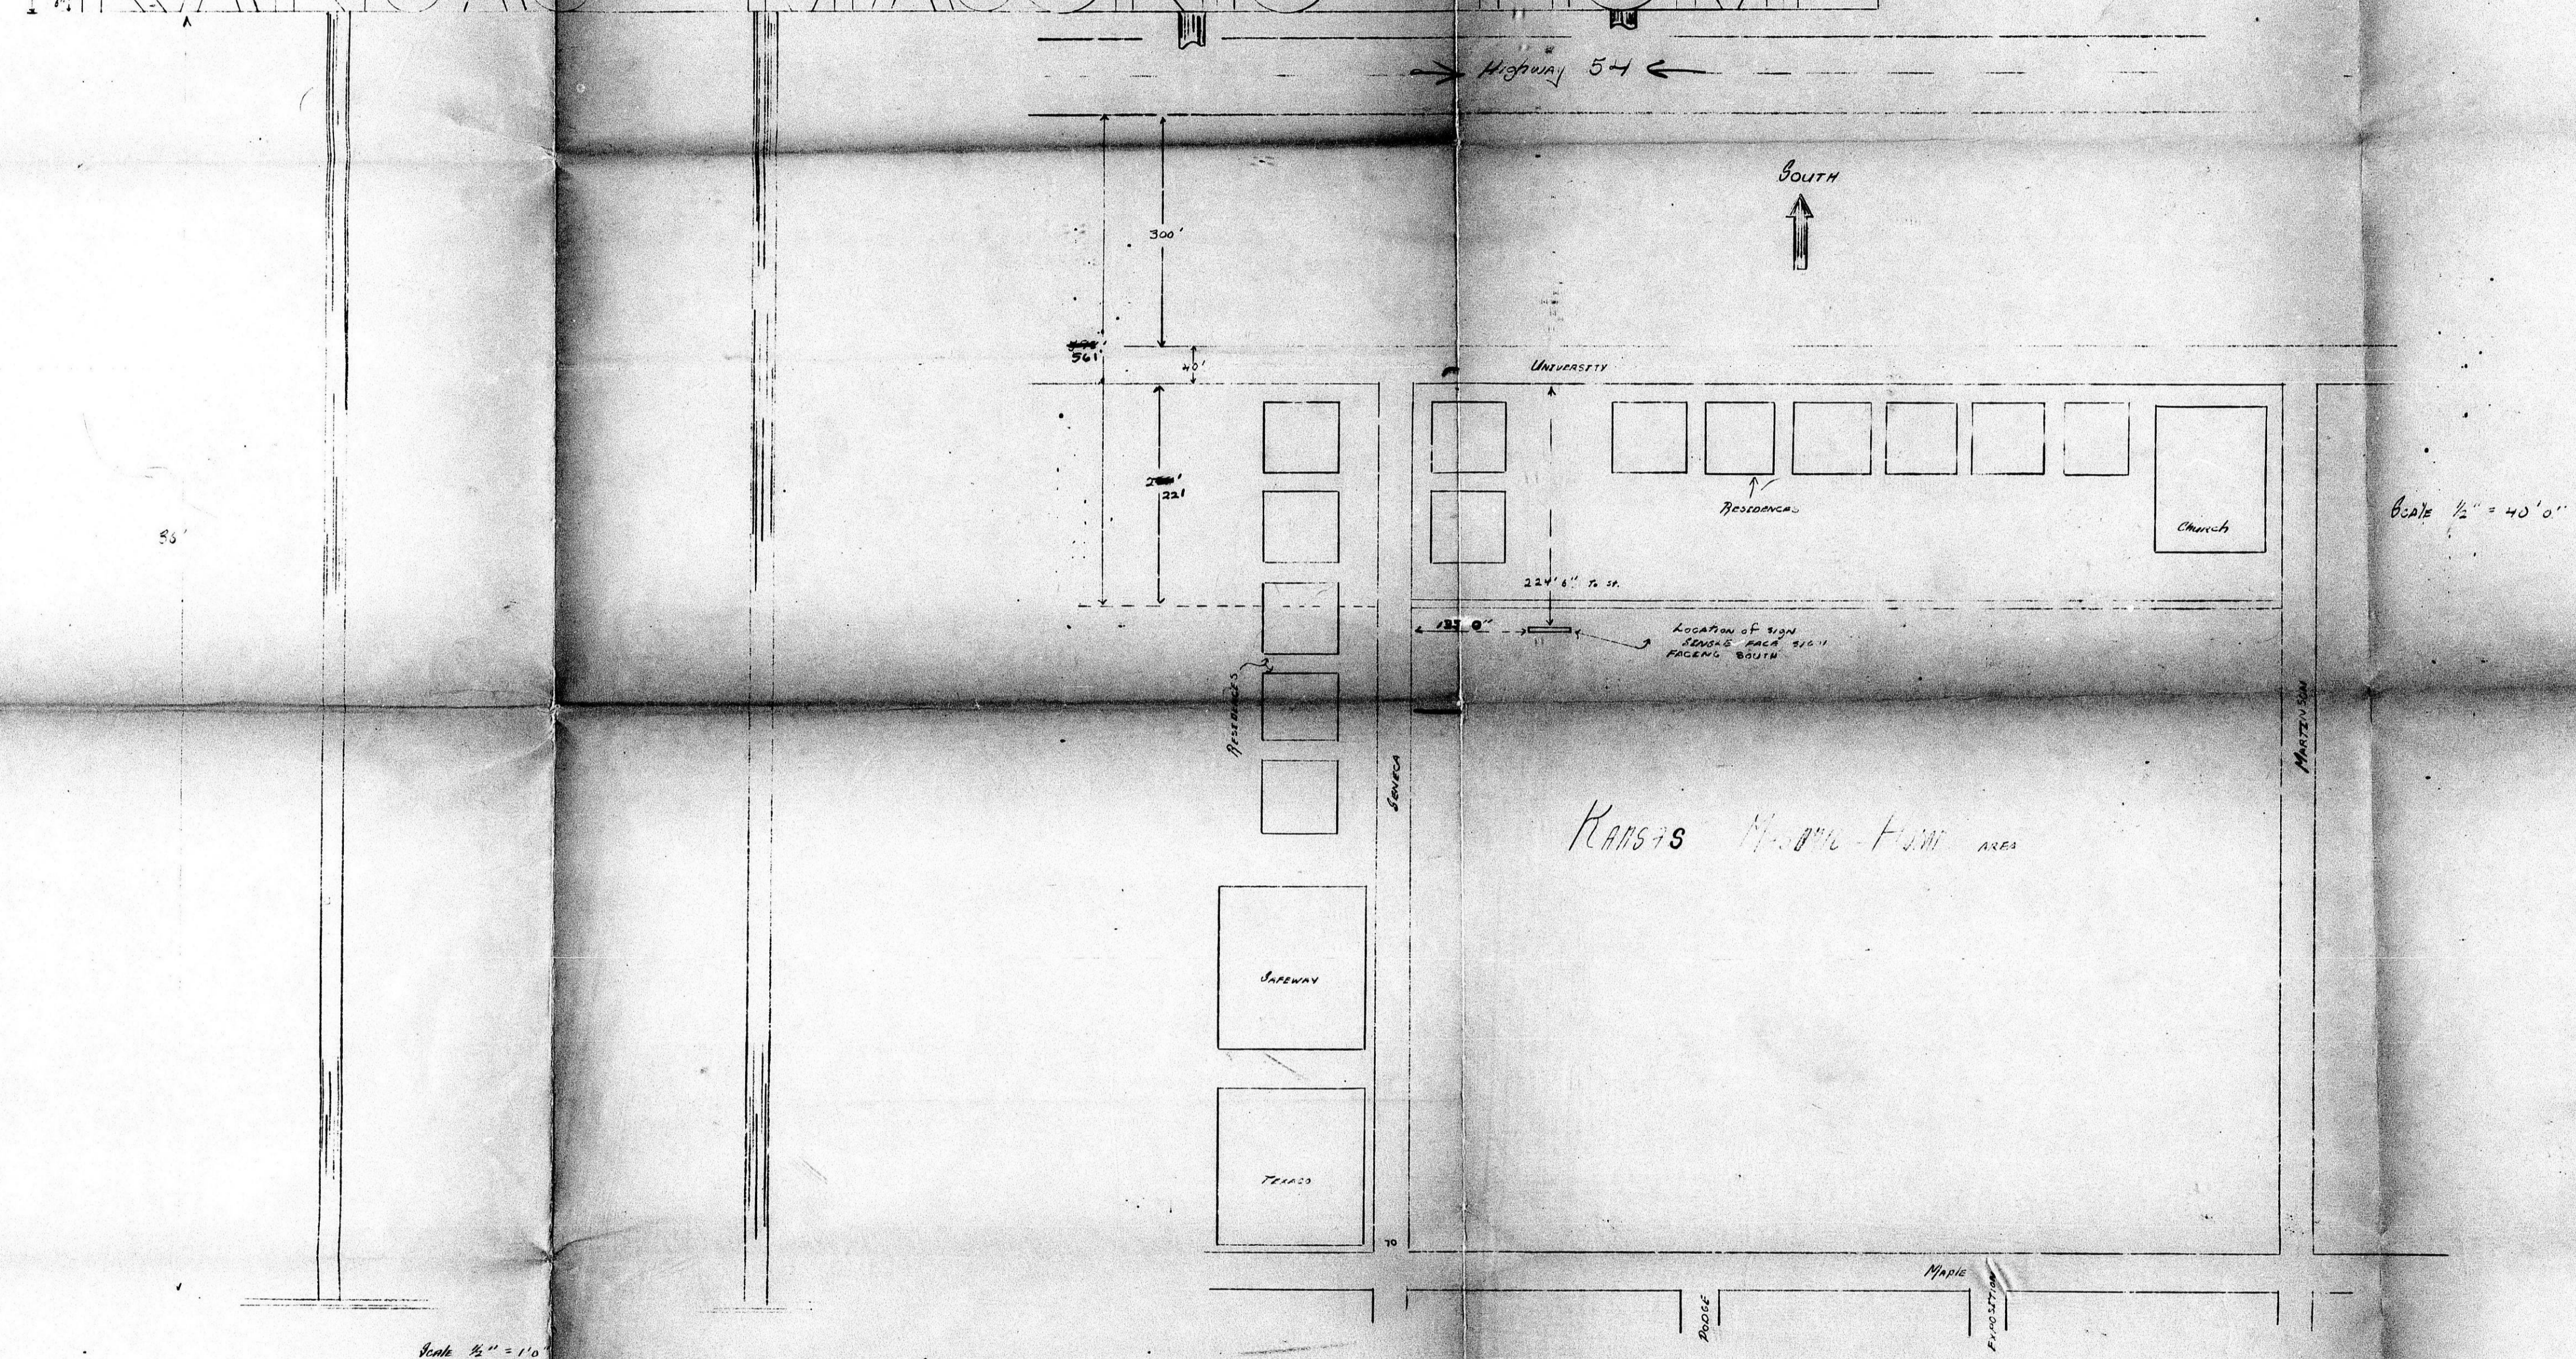

Scale 1/2" = 40' 0"

Scale 1/2" = 10'

Charles Federal News Co. # 17281

BZA13-17

BZA13-17