
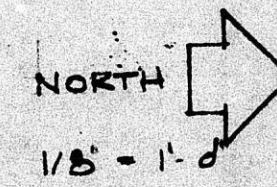


BZA17-78

MATHEWSON STREET

SECOND STREET - ONE WAY

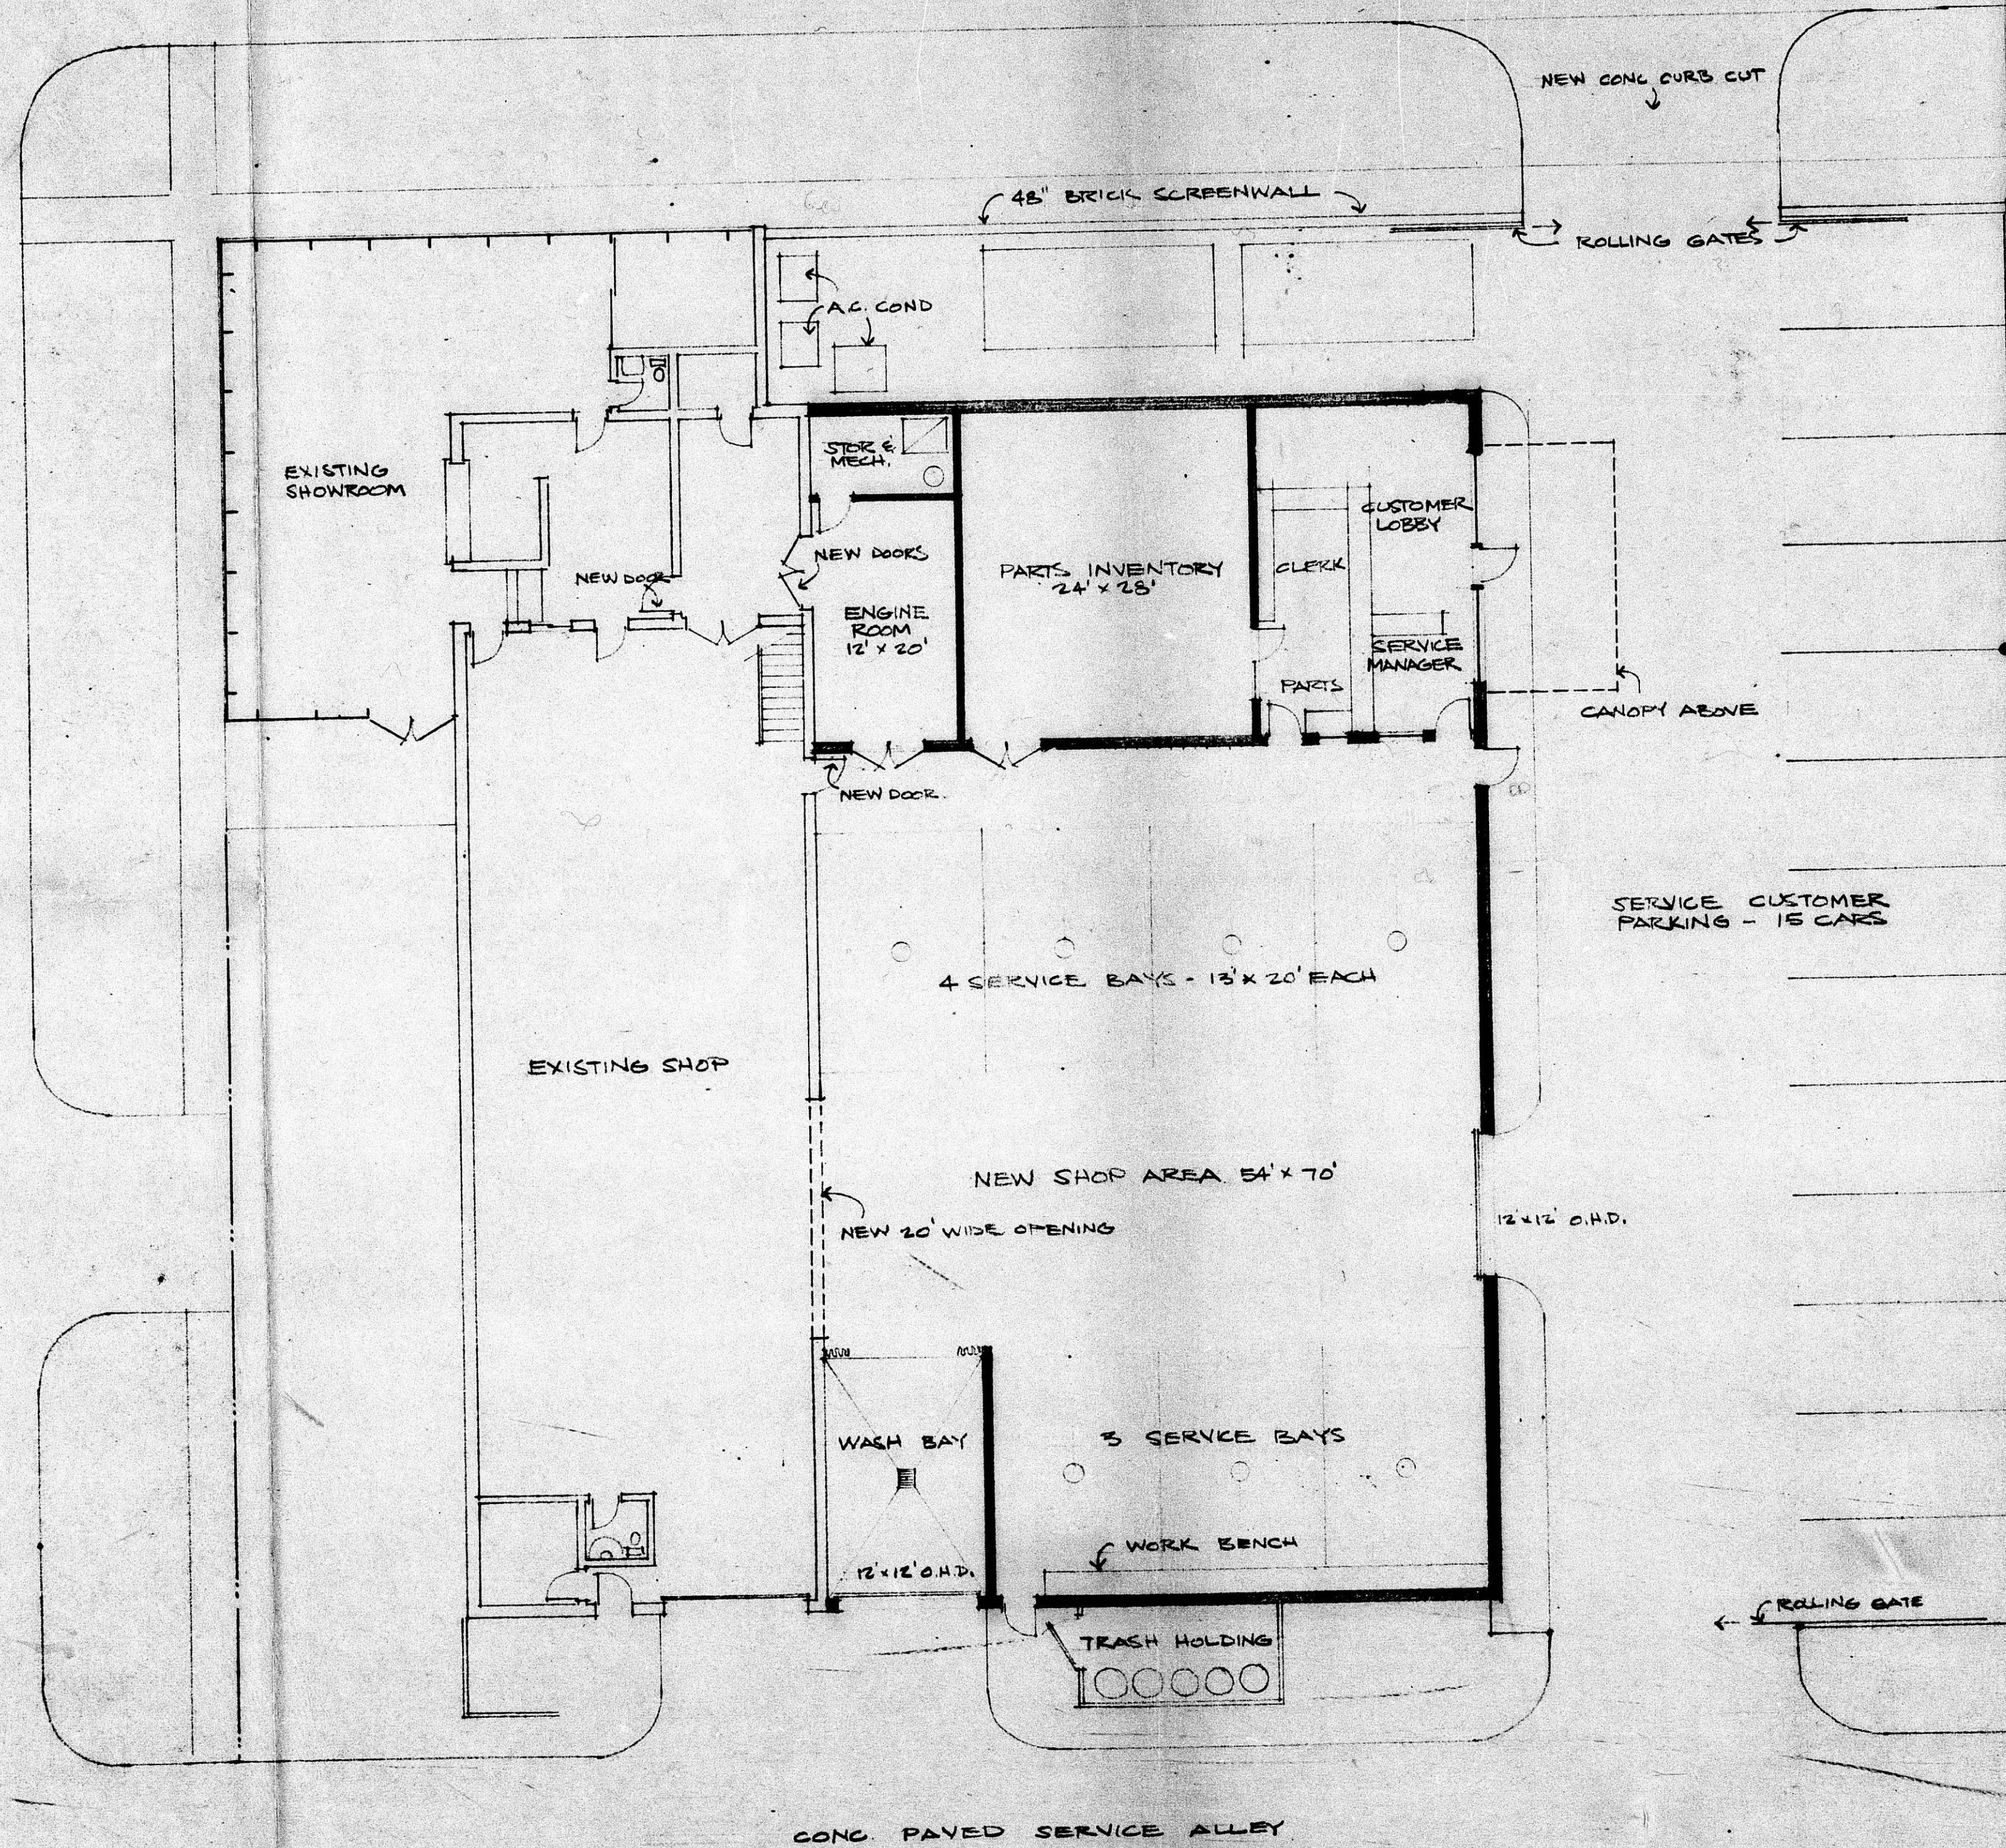

BUILDING AREA (NEW)
- 5656 SQ. FT.

DAVID HANES, ARCHITECT
3208 66th Douglas, Wichita, Kansas 67208 phone 36 684 0880



SERVICE FACILITIES EXPANSION FOR
EUROPEAN CAR COMPANY - WICHITA

18 MARCH 78

BZA 17-78

MATHEWSON STREET

SECOND STREET - ONE WAY

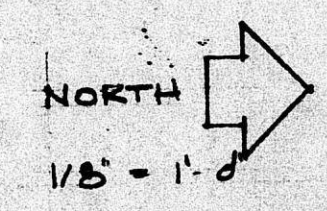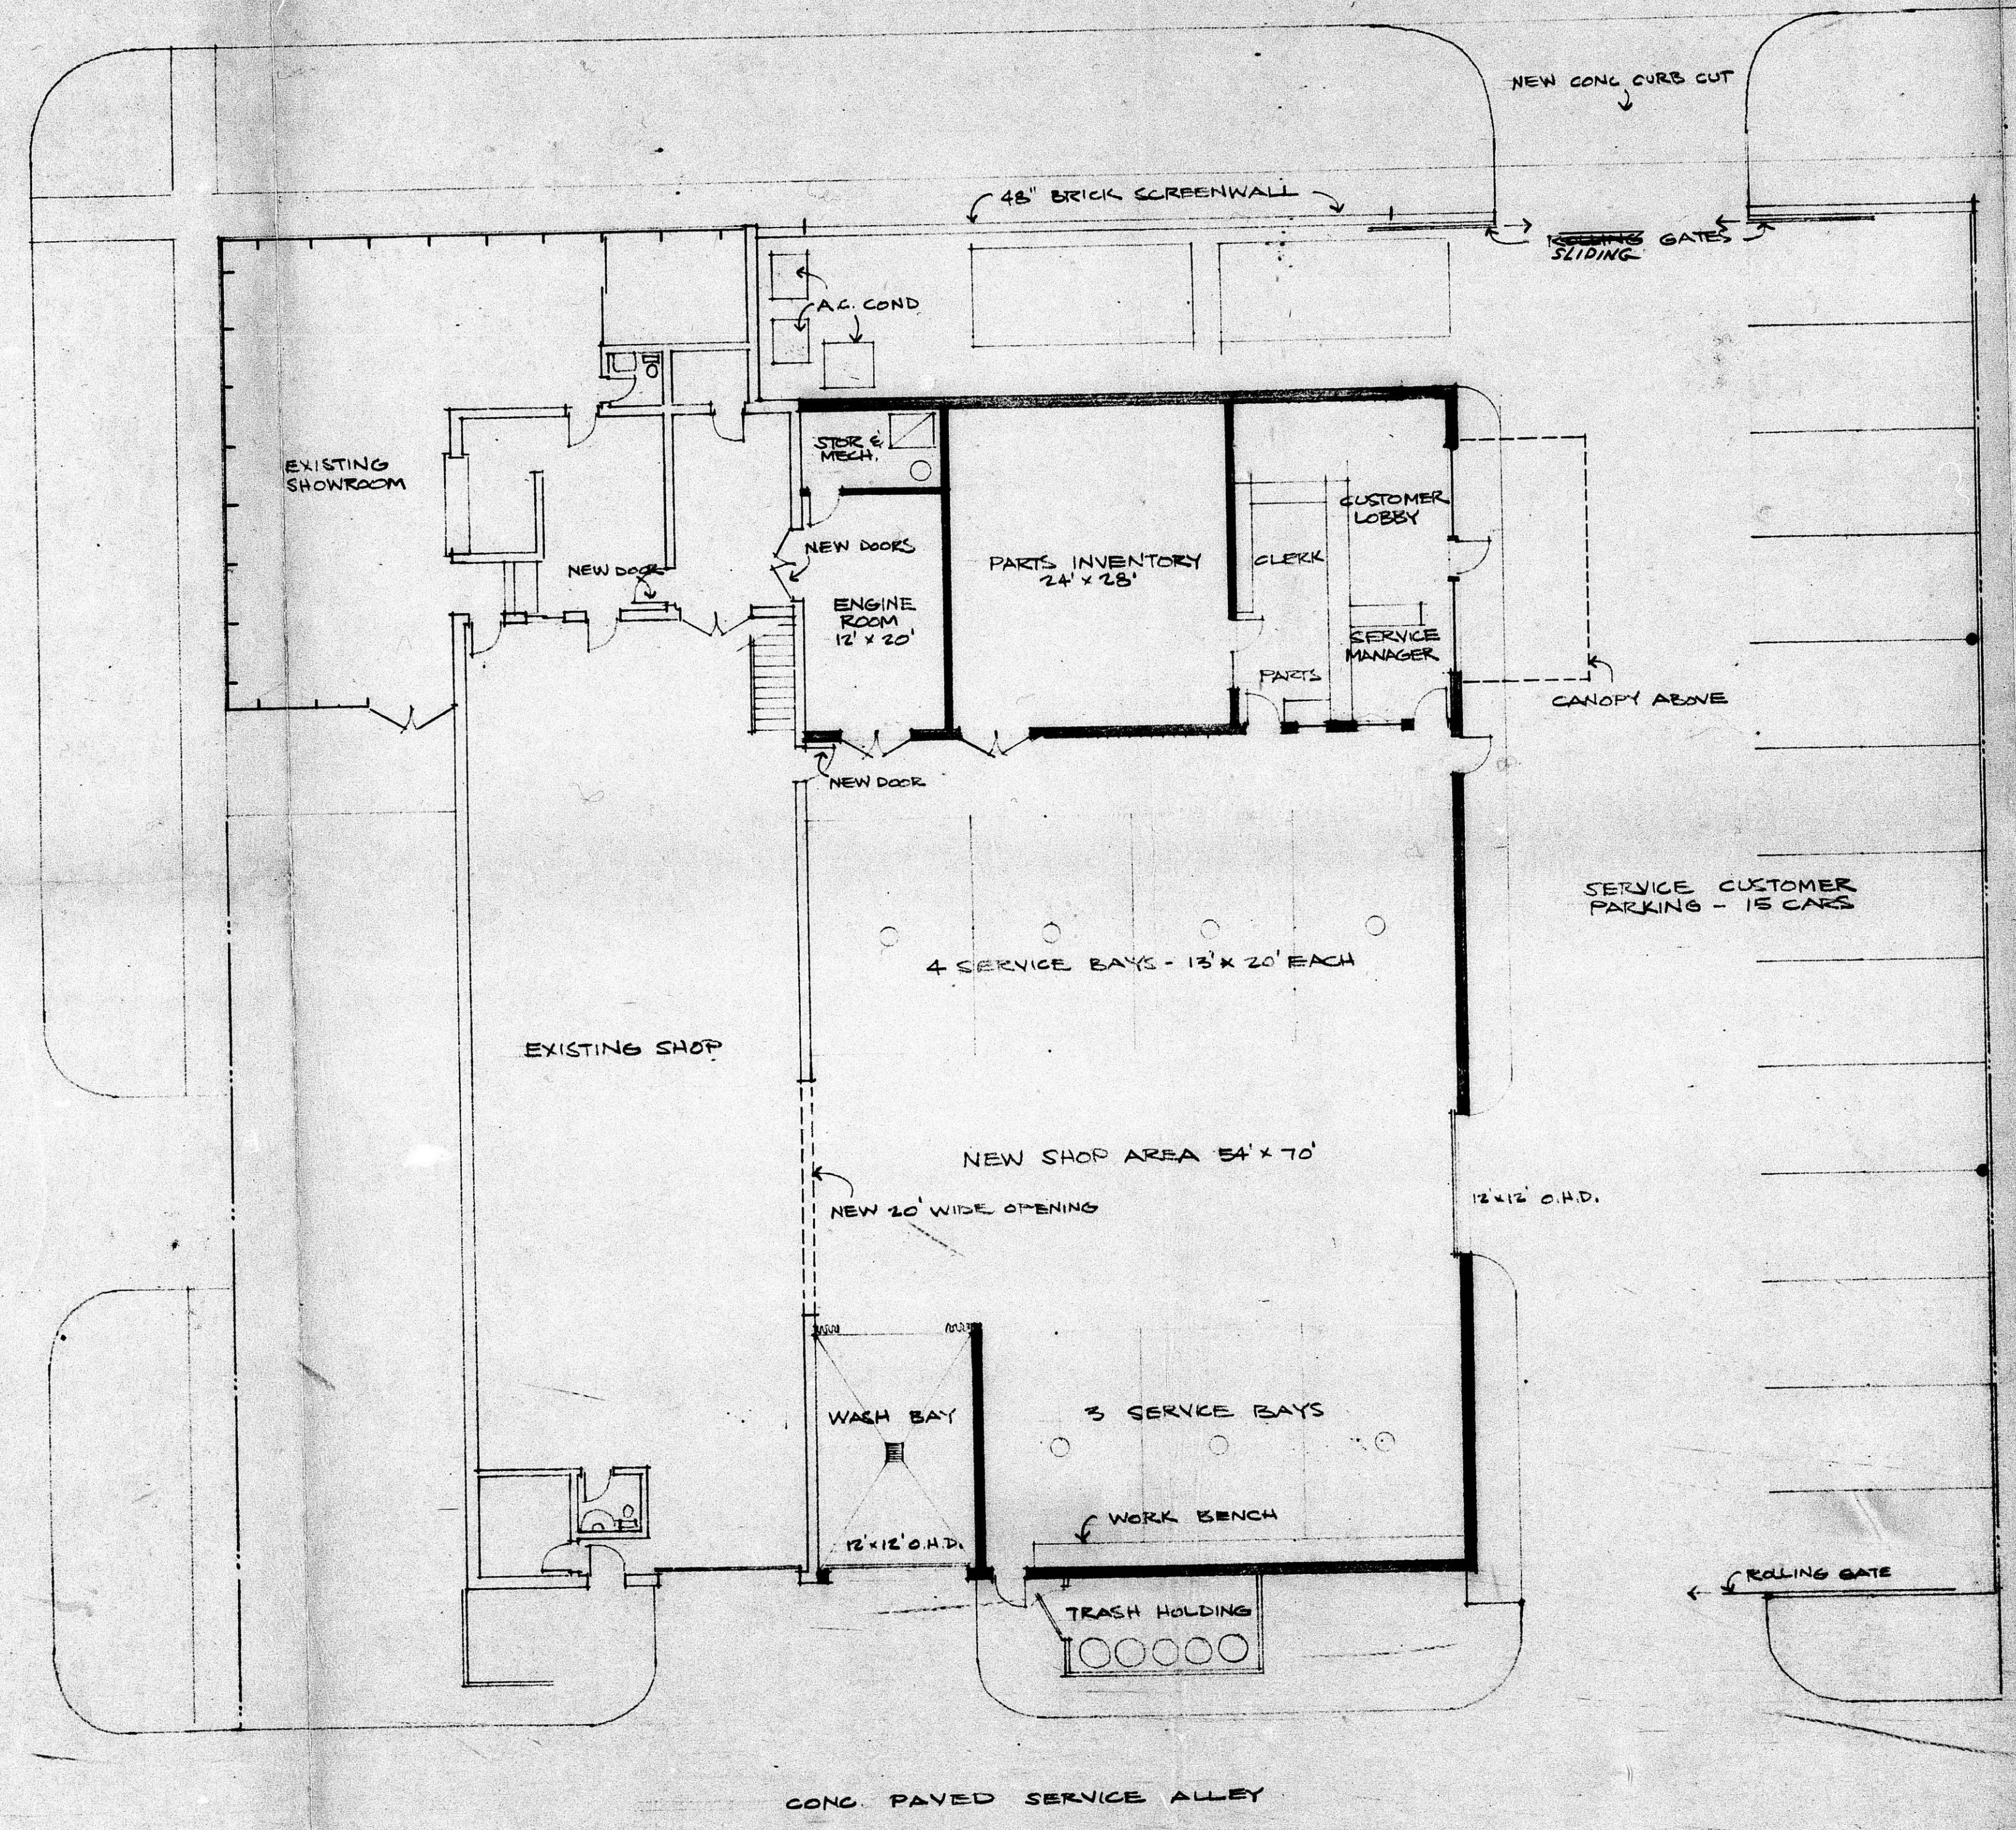

BUILDING AREA (NEW)
5656 SQ. FT.

DAVID HANES, ARCHITECT
3208 east douglas, wichita, kansas 67208 phone 36 684 0880

SERVICE FACILITIES EXPANSION FOR
EUROPEAN CAR COMPANY - WICHITA

16MARCH78