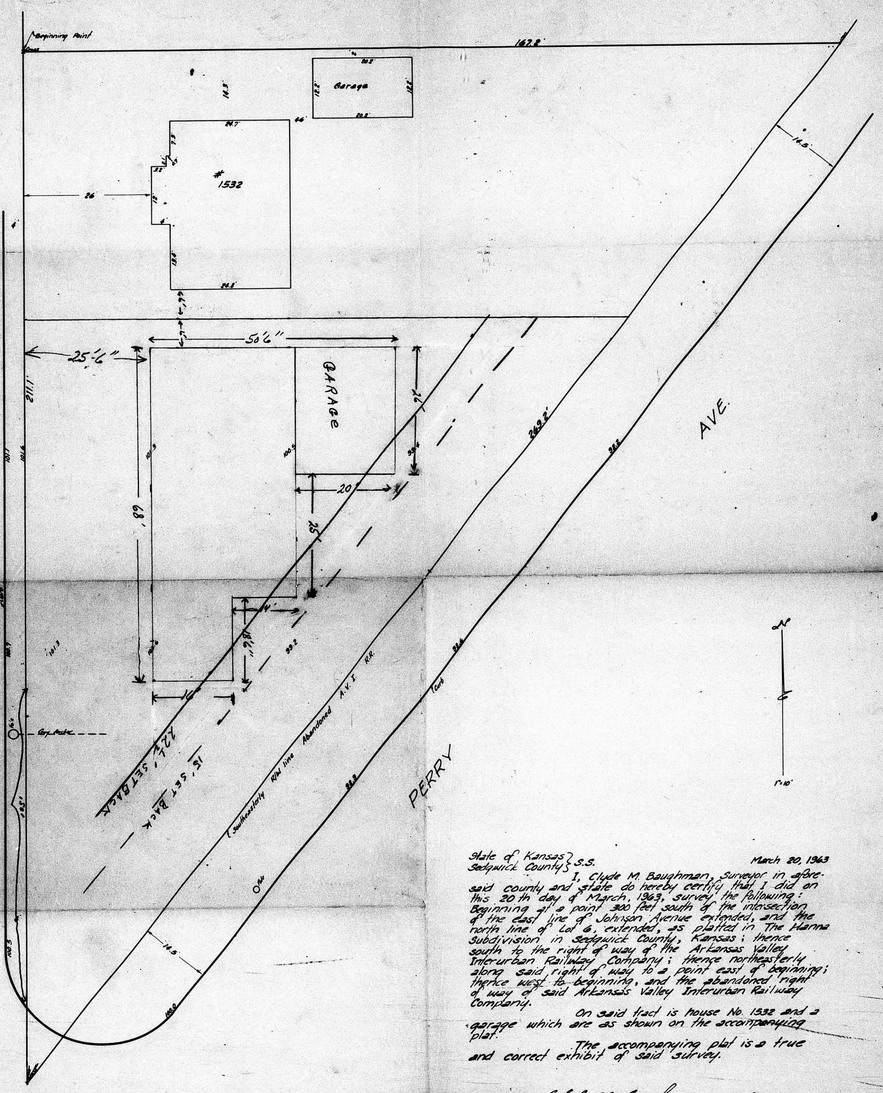

State of Kansas } S.S.
Sedgwick County }

March 20, 1963

I, Clyde M. Baughman, surveyor in aforesaid county and state do hereby certify that I did on this 20th day of March, 1963, survey the following: Beginning at a point 300 feet south of the intersection of the east line of Johnson Avenue extended, and the north line of Lot 6, extended, as platted in The Manna Subdivision in Sedgwick County, Kansas; thence south to the right of way of the Arkansas Valley Interurban Railway Company; thence northeasterly along said right of way to a point east of beginning; thence west to beginning, and the abandoned right of way of said Arkansas Valley Interurban Railway Company.

On said tract is house No. 1532 and a garage which are as shown on the accompanying plat.

The accompanying plat is a true and correct exhibit of said survey.

Clyde M. Baughman Surveyor

19-63

Clyde M. Baughman Co. 3-20-63

19-63

FILMED FROM THE BEST AVAILABLE COPY

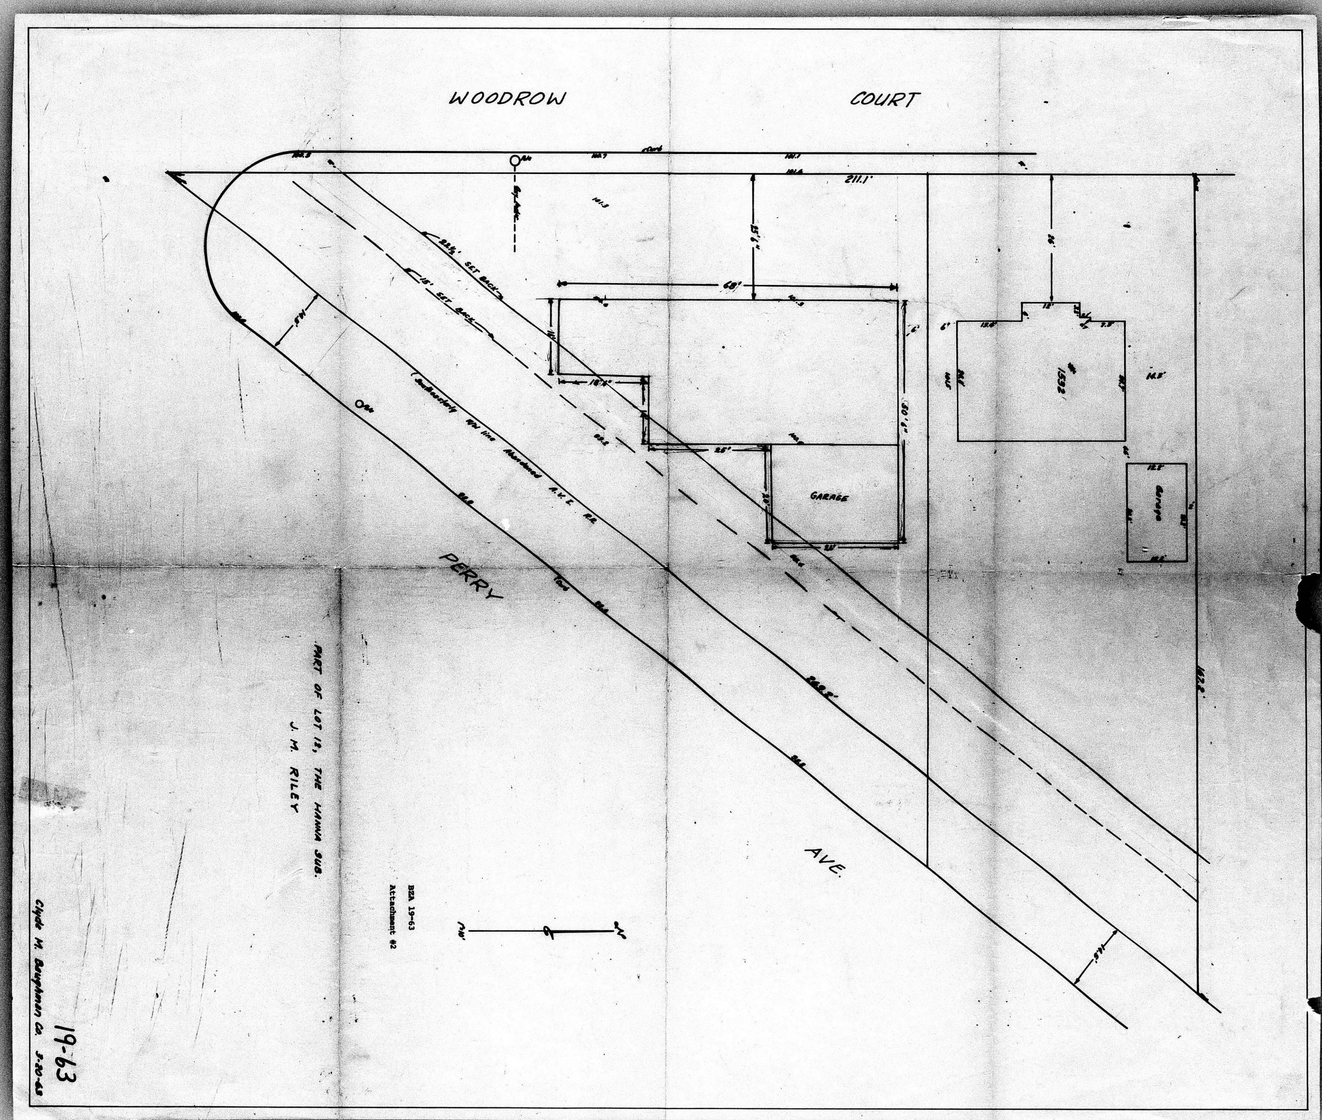

19-63

FILMED FROM THE BEST AVAILABLE COPY