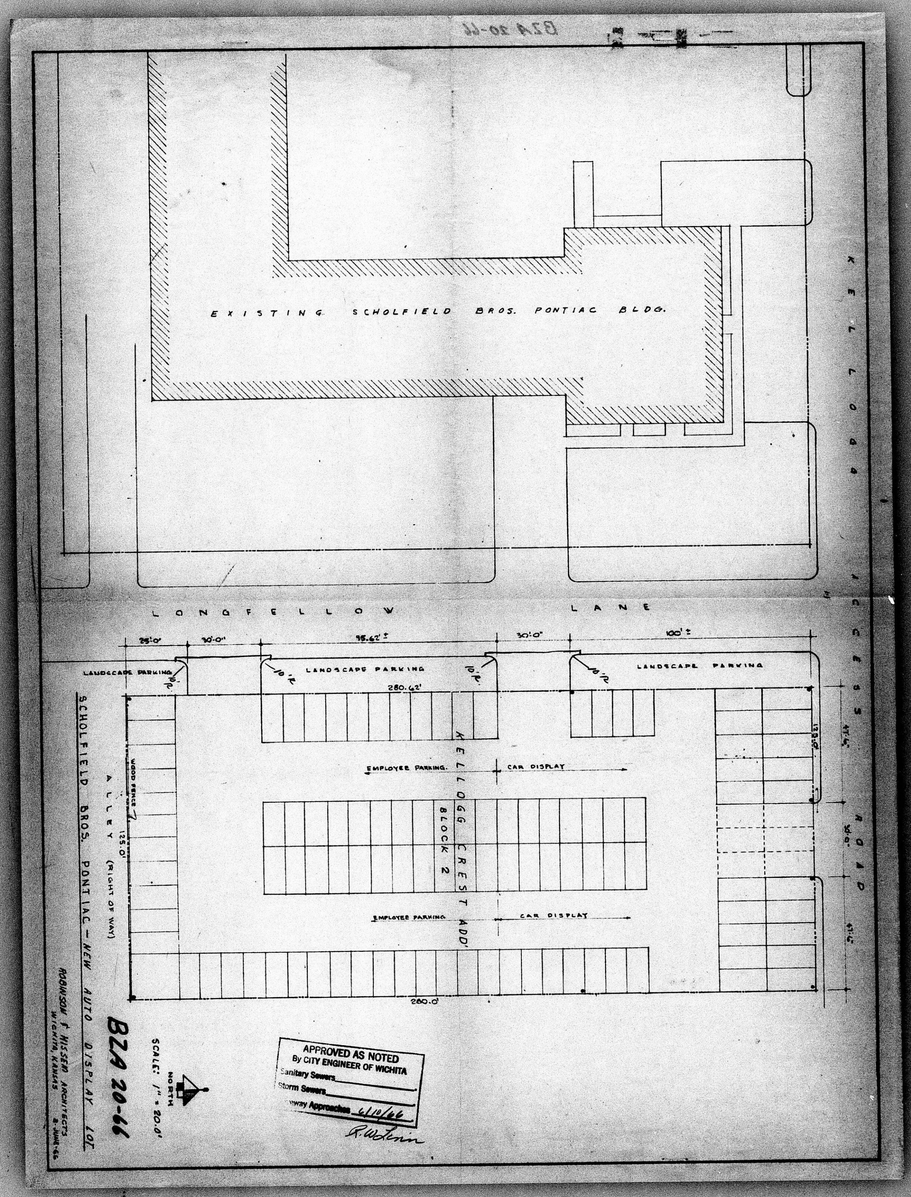

BZA 20-66

SCHOLFIELD BROS. PONTIAC — NEW AUTO DISPLAY LOT

WICHITA, KANSAS

FILMED FROM THE BEST AVAILABLE COPY....