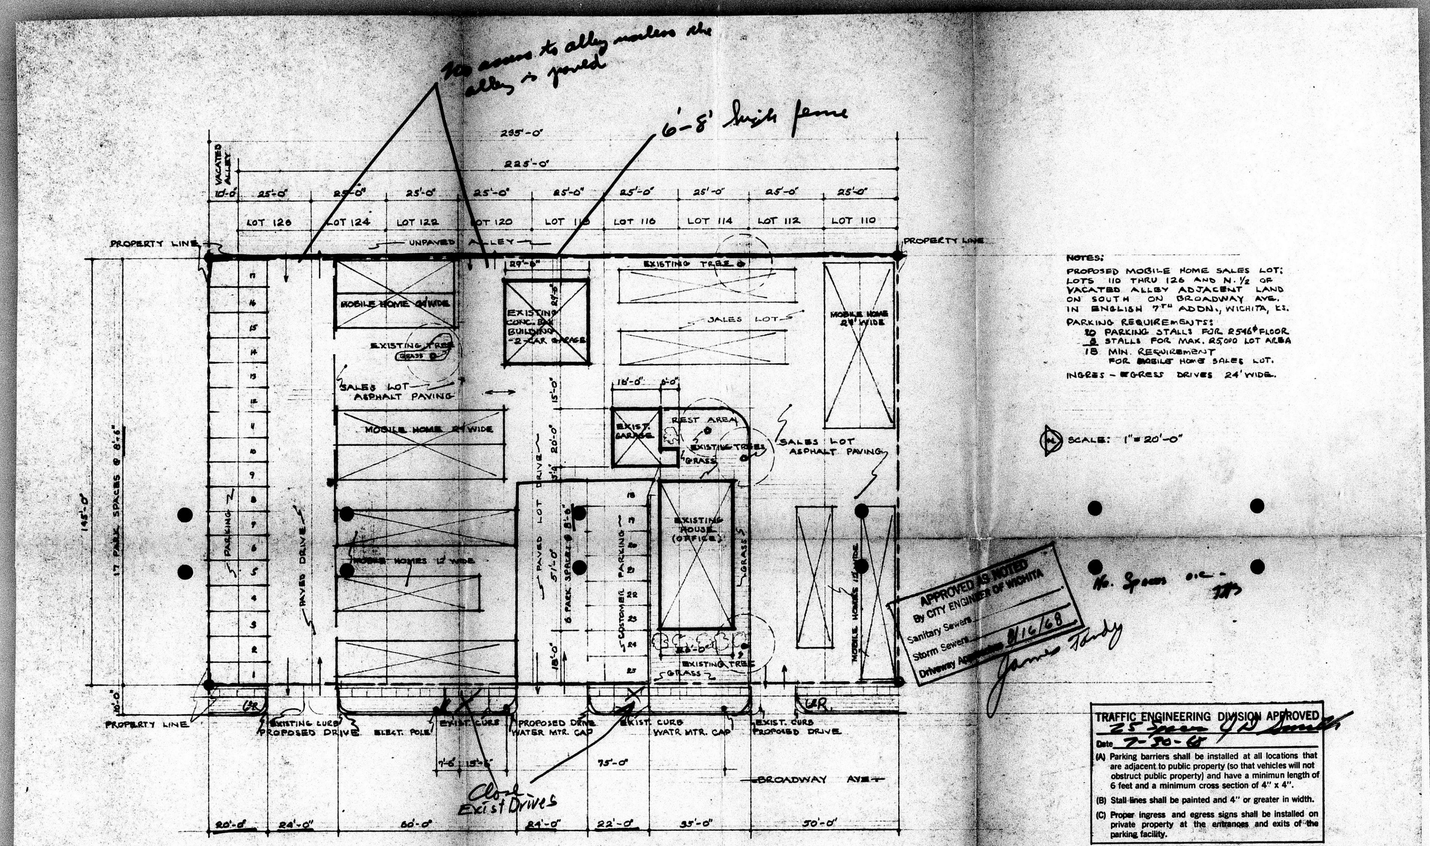


NOTES:

PROPOSED MOBILE HOME SALES LOT: LOTS 110 THRU 126 AND N. 1/2 OF VACATED ALLEY ADJACENT LAND ON SOUTH ON BROADWAY AVE. IN ENGLISH 7TH ADDN., WICHITA, KS.

PARKING REQUIREMENTS:
20 PARKING STALLS FOR 2546# FLOOR
8 STALLS FOR MAX. 25000 LOT AREA
18 MIN. REQUIREMENT FOR MOBILE HOME SALES LOT.

INGRES - EGRESS DRIVES 24' WIDE.

SCALE: 1" = 20'-0"

No. Spaces o.k. - JHS

APPROVED AS NOTED
By CITY ENGINEER OF WICHITA
Sanitary Sewers
Storm Sewers
Driveway Approaches 8/16/68
James Tandy

TRAFFIC ENGINEERING DIVISION APPROVED
25 Spaces J D Smith
Date 7-30-68

(A) Parking barriers shall be installed at all locations that are adjacent to public property (so that vehicles will not obstruct public property) and have a minimun length of 6 feet and a minimum cross section of 4" x 4".

(B) Stall lines shall be painted and 4" or greater in width.

(C) Proper ingress and egress signs shall be installed on private property at the entrances and exits of the parking facility.

PROPOSED MOBILE HOME SALES LOT
FOR MR. & MRS. EARL HENDERSON
1649 S. BROADWAY, WICHITA, KANSAS

BZA 20-68

FILMED FROM THE BEST AVAILABLE COPY




NOTES:

PROPOSED MOBILE HOME SALES LOT: LOTS 110 THRU 126 AND N. 1/2 OF VACATED ALLEY ADJACENT LAND ON SOUTH ON BROADWAY AVE. IN ENGLISH 7TH ADDN., WICHITA, KS.

PARKING REQUIREMENTS:
20 PARKING STALLS FOR 2546# FLOOR
8 STALLS FOR MAX. 8500 LOT AREA
18 MIN REQUIREMENT FOR MOBILE HOME SALES LOT.

INGRESS - EGRESS DRIVES 24' WIDE.

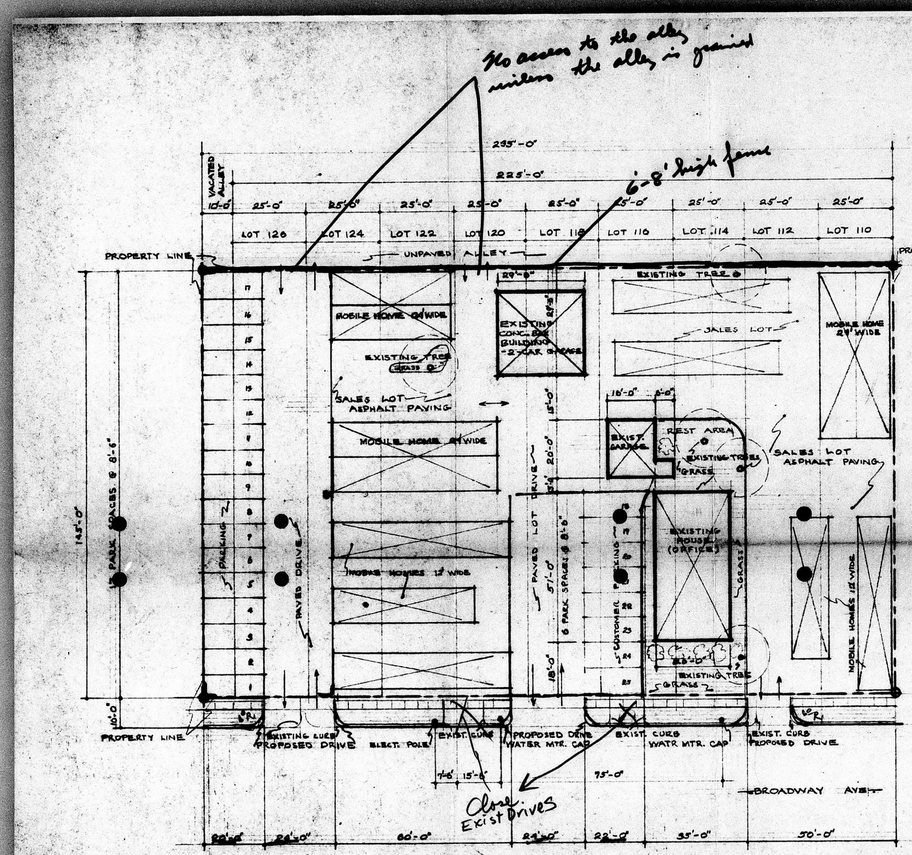SCALE: 1" = 20'-0"

APPROVED AS NOTED
By CITY ENGINEER OF WICHITA

APPROVED AS NOTED
By CITY ENGINEER OF WICHITA

TRAFFIC ENGINEERING DIVISION APPROVED
Date 7-20-68

(A) Parking barriers shall be installed at all locations that are adjacent to public property (so that vehicles will not obstruct public property) and have a minimum length of 6 feet and a minimum cross section of 4" x 4".

(B) Stall lines shall be painted and 4" or greater in width.

(C) Proper ingress and egress signs shall be installed on private property at the entrances and exits of the parking facility.

PROPOSED MOBILE HOME SALES LOT
FOR MR. & MRS. EARL HENDERSON
1945 S. BROADWAY, WICHITA, KANSAS

BZA 20-68

FILMED FROM THE BEST AVAILABLE COPY