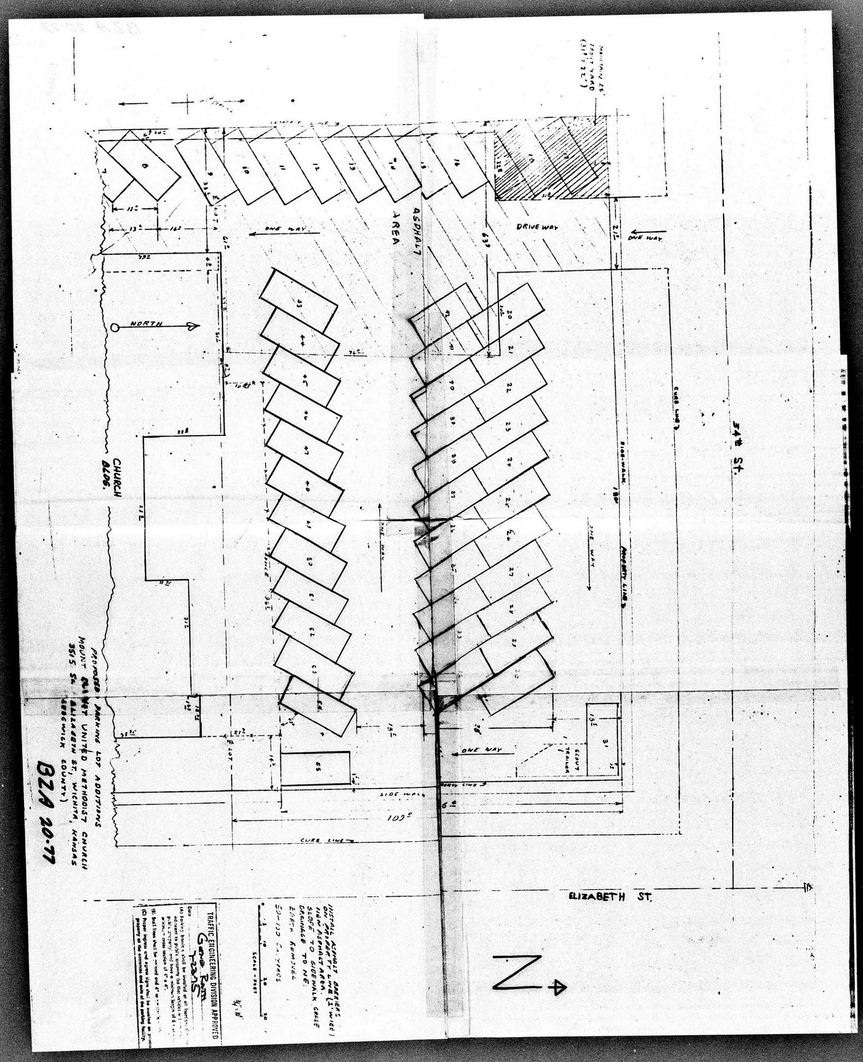

FILMED FROM THE BEST AVAILABLE COPY.....

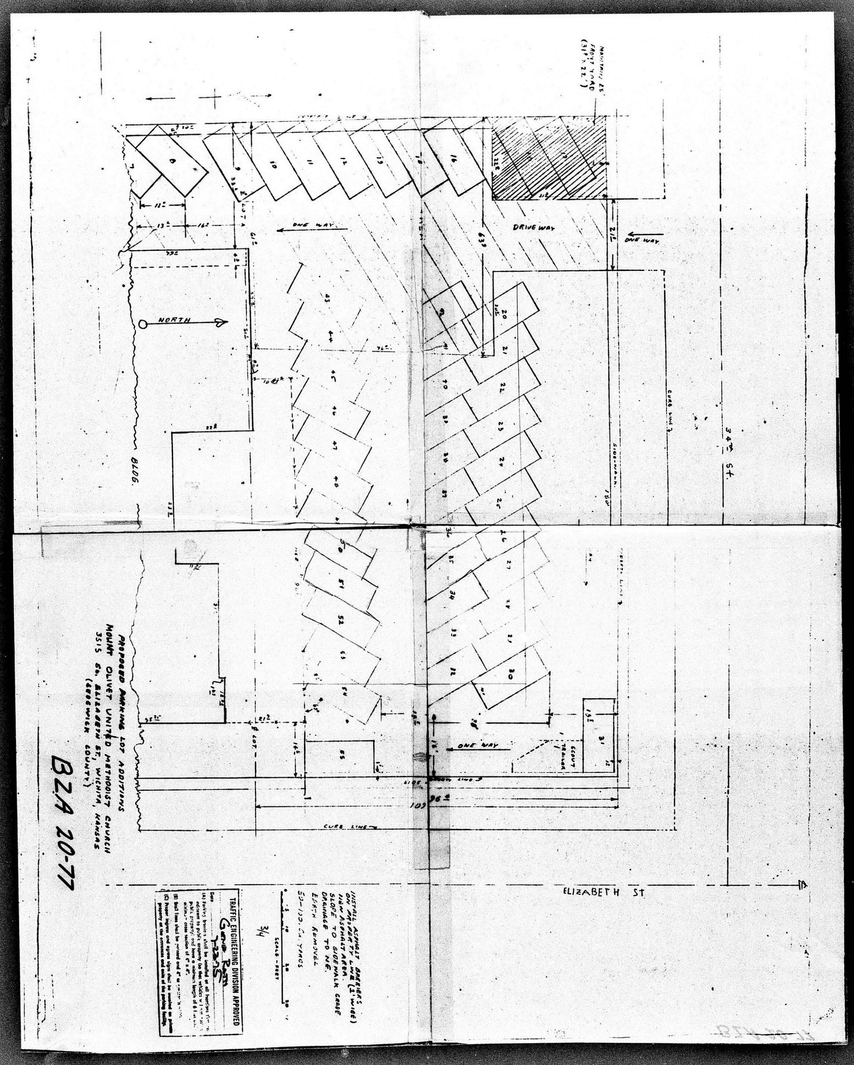

PREPARED PARKING LOT ADDITIONS
MOUNT OLIVET UNITED METHODIST CHURCH
3515 ST. ELIZABETH ST. WICHITA, KANSAS
(SEDGWICK COUNTY)

BZA 20-77

FILMED FROM THE BEST AVAILABLE COPY