SCALE - 1 INCH = 10 FEET
LOCATION - 3158 S. SENECA

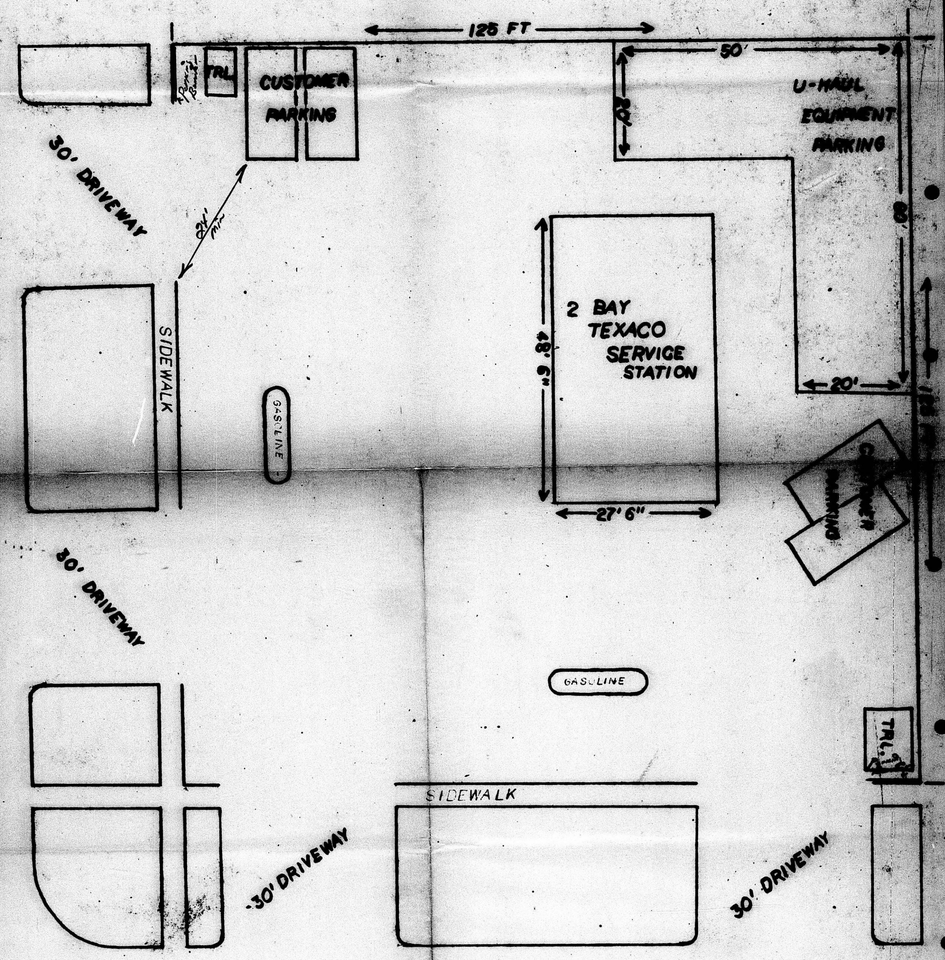

TRAFFIC ENGINEERING DIVISION APPROVED
Date 8-25-69

(1) Parking barriers shall be installed at all locations that are adjacent to public property (so that vehicles will not obstruct public property) and have a minimum length of 6 feet and a minimum cross section of 4" x 4".

(2) Stall lines shall be painted and 4" or greater in width.

(3) Proper ingress and egress signs shall be installed on private property at the entrances and exits of the parking facility.

BZA 21-69