

**LEGAL DESCRIPTION:**  
 LOT 1, WEST AND CENTER FIRST ADDITION  
 SOUTH 1/2 OF LOT 171, ALL OF LOT 172 AND  
 SOUTH 1/2 OF LOT 173, ALL OF LOT 164 AND  
 NORTH 7/8 OF LOT 171, INDIANNA SUBDIVISION.

REF: DEK CASE 21-70.

**TRAFFIC ENGINEERING DIVISION APPROVED**  
 Date: 11/15/72  
 By: [Signature]  
 1. Parking barriers shall be installed at all locations that are adjacent to public property (so that vehicles will not obstruct public property) and have a minimum length of 6 feet and a minimum cross section of 4" x 4".  
 2. Lines shall be painted and 4" or greater in width.  
 3. Ingress and egress signs shall be installed on the property at the entrances and exits of the building facility.

*Handwritten:*  
 Zone 2 Void  
 See letter to RA 2/28/72  
 11/27/72

ESTIMATED EMPLOYEE PARKING  
 - 1000 100' x 20'  
 - PHASE 5

1.000 APPROXIMATE  
 NORMAL PARKING


PARKING		
PHASE 5	100	20
PHASE 5	100	20
TOTAL	200	40

NORTH  
 1" = 20'

**SITE PLAN**  
 SCALE: 1" = 20'

PARKING LAYOUT  
 STATE FARM INSURANCE



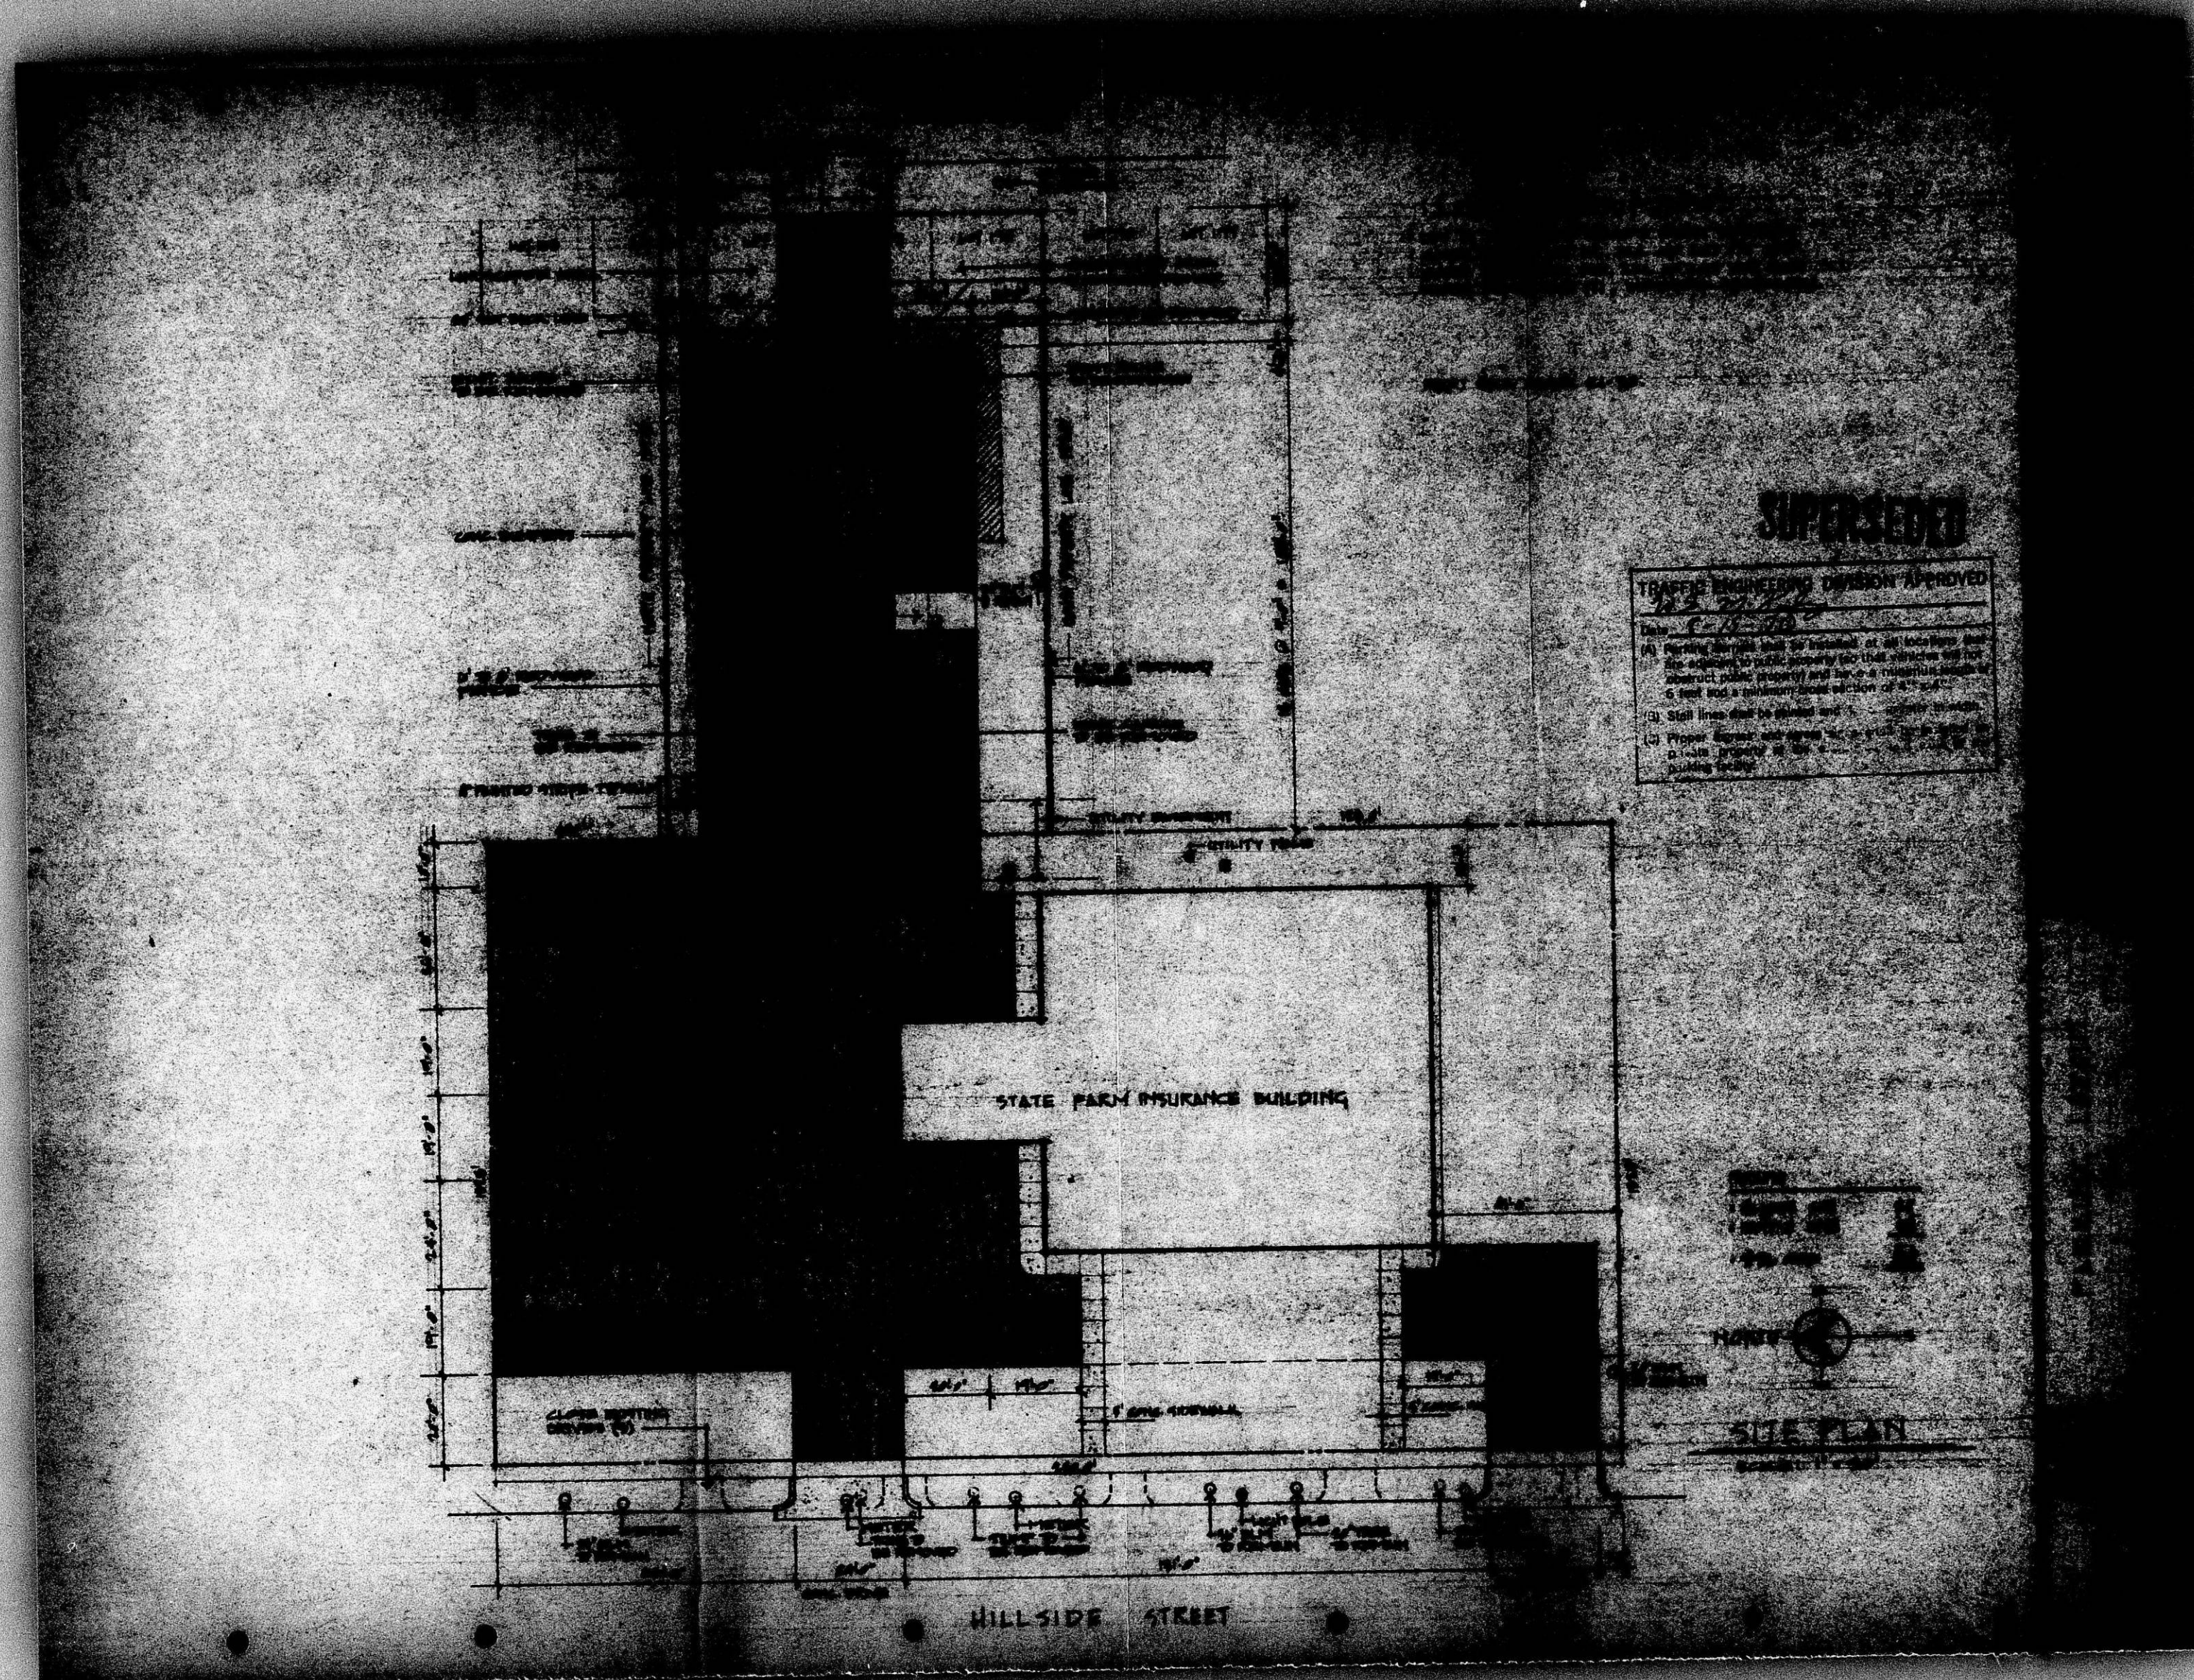

FILMED FROM THE BEST  
AVAILABLE COPY.....

