


APPROVED AS NOTED
 By CITY ENGINEER OF WICHITA
 Sanitary Sewers
 Storm Sewers 12/20/71
 Driveway Approaches
James J. Jody

TRAFFIC ENGINEERING DIVISION APPROVED
John S. [Signature]
 Date: 12/20/71
 (A) Parking barriers shall be installed at all locations that are adjacent to public property (so that vehicles will not obstruct public property) and have a minimum length of 6 feet and a minimum cross-section of 4" x 4".
 (B) Stalk signs shall be painted and 4" or greater in width.
 (C) Police lights and signs shall be installed on private property at the entrance and exit of the parking facility.

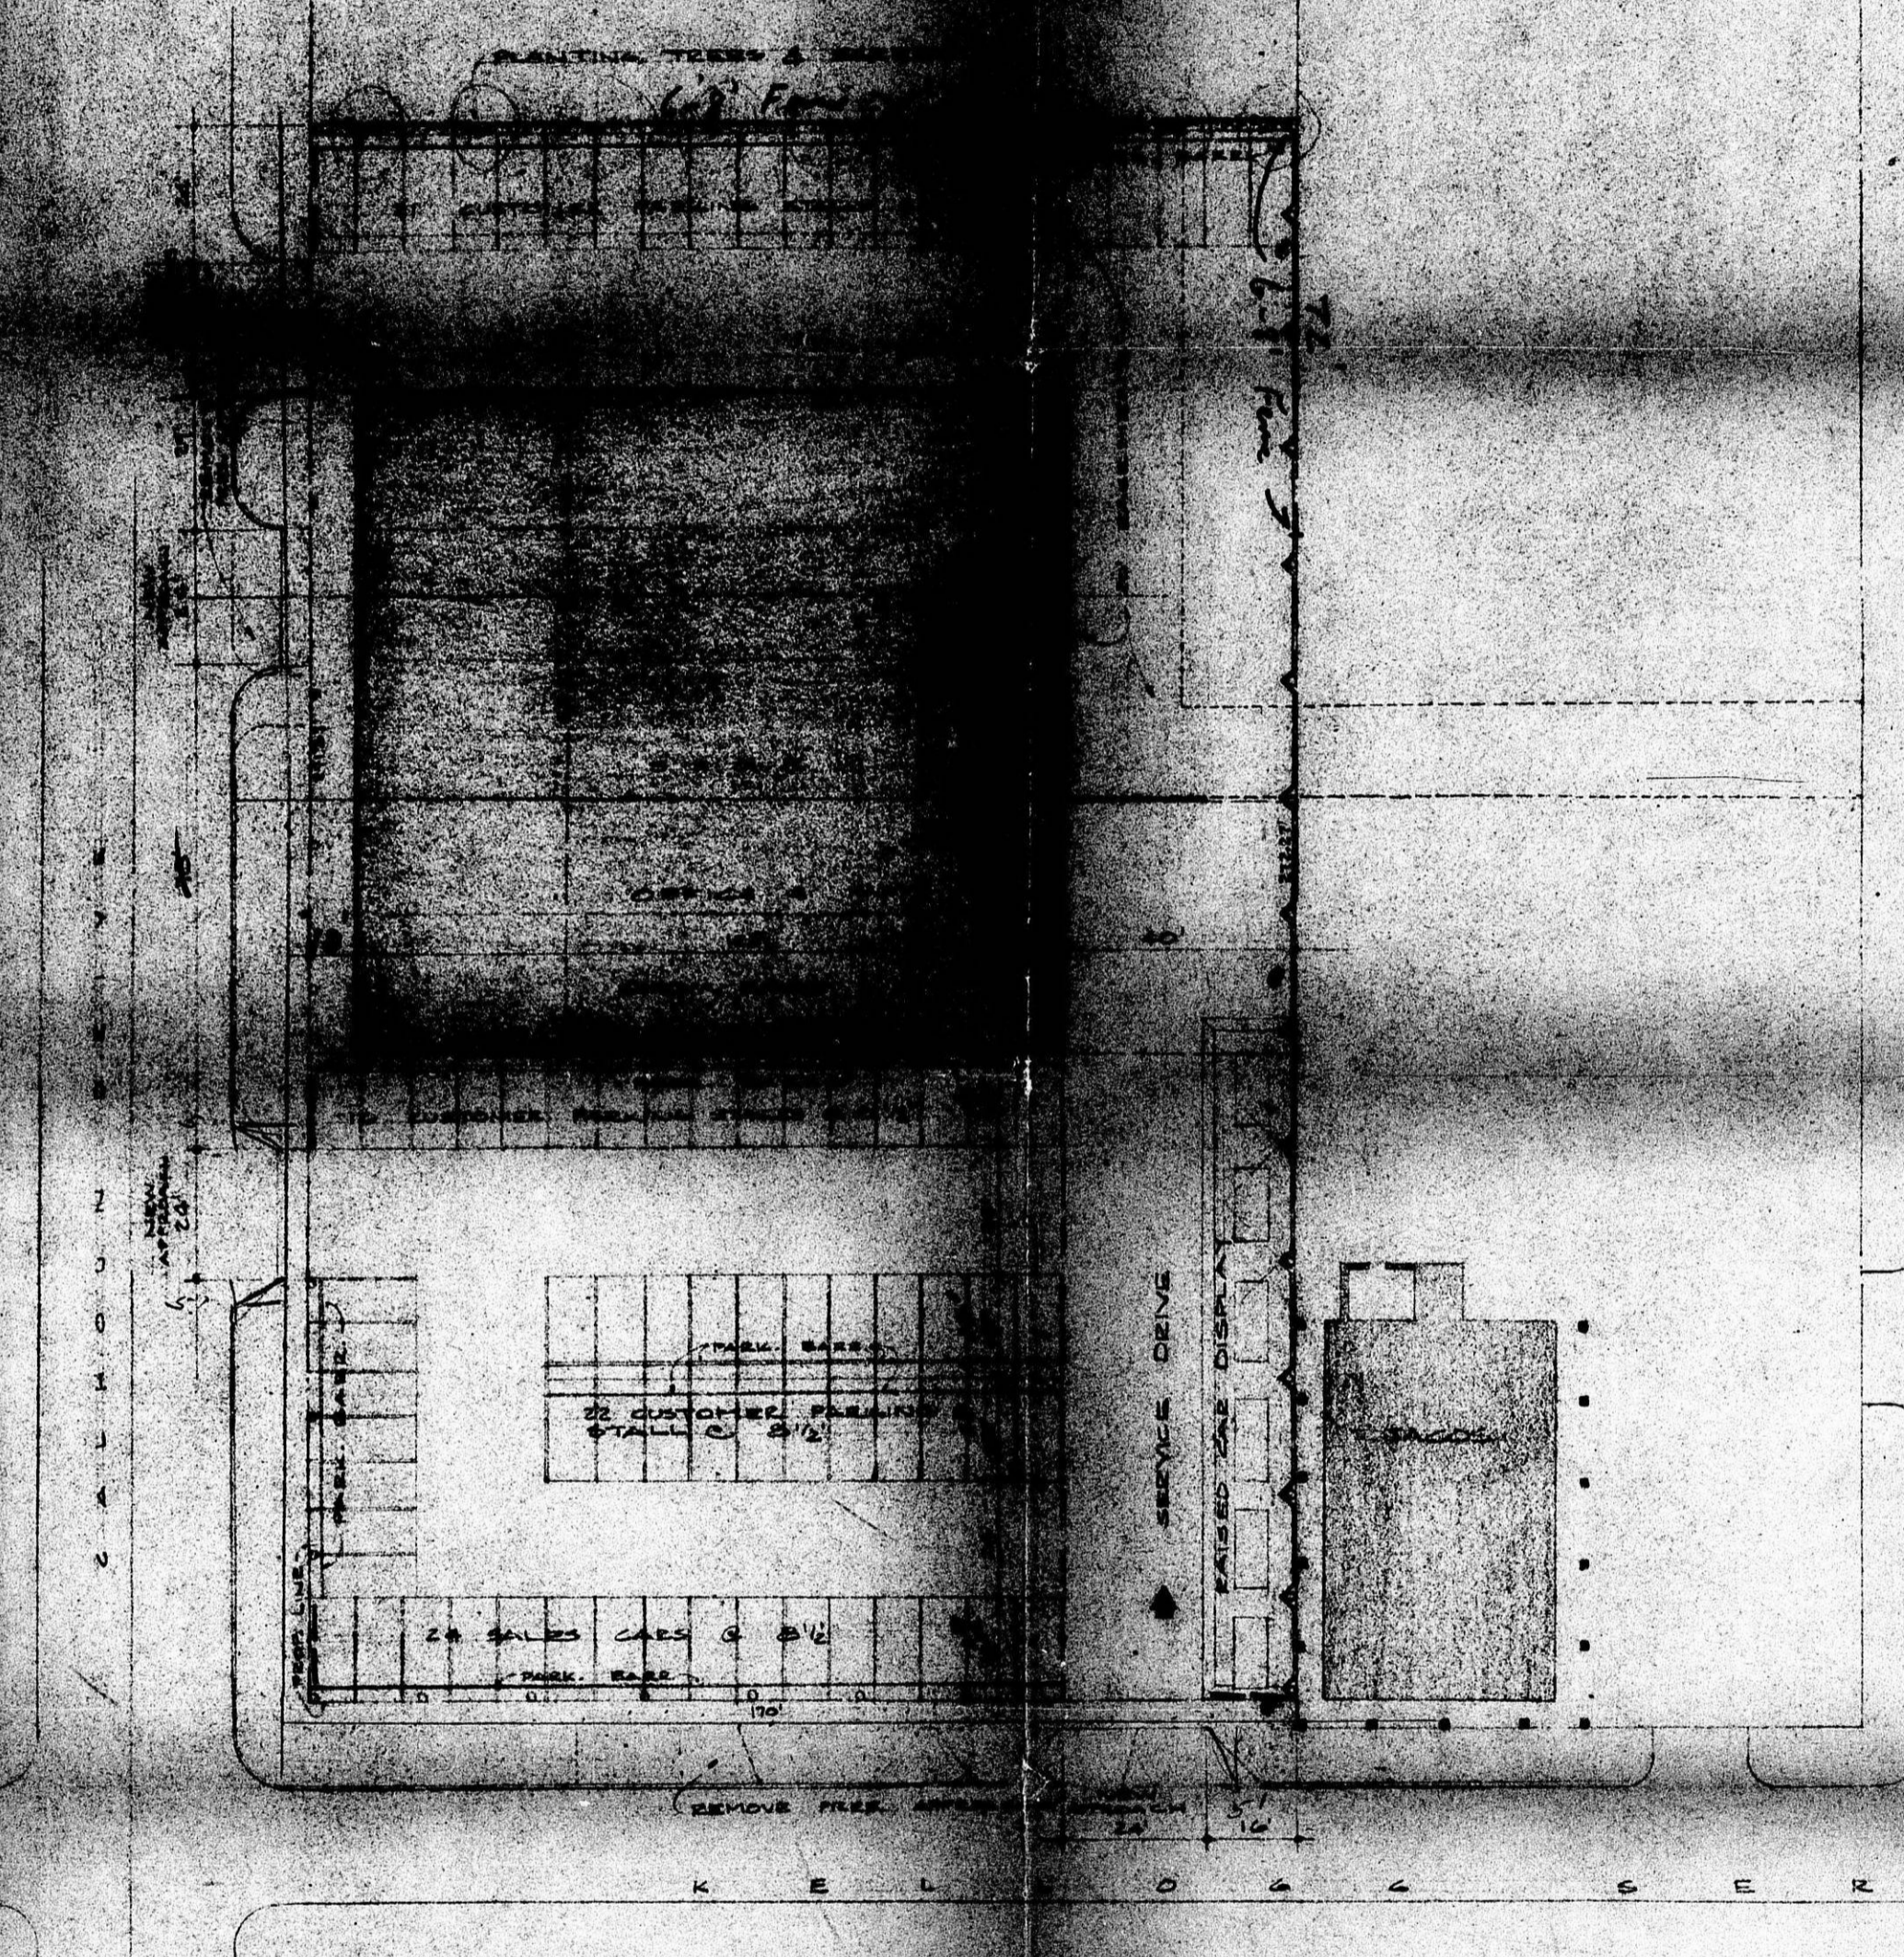

BZA 21-71

ALAN M. [Signature] ARCHITECT
 CENTURY PLAZA - BLDG. 1000

EDDY'S TOYOTA OF WICHITA, INC.

OVERALL PLOT PLAN - BLDG. 1
 REV. 02/21/71 - DEC. 20/71

FILMED FROM THE BEST
 AVAILABLE COPY