

NOTES:
ENTRANCES ARE LOCATED IN CONFORMANCE WITH CITY OF WICHITA APPROVED PLANS ON FILE AT CENTRAL INSPECTION DEPT.
NO CITY SIDEWALKS EXIST ON THE EAST SIDE OF ROCK ROAD AS OF 6-24-74.

K.A.B.E. CO. EBM'T. AFFIDAVIT - SEE BOOK 72, PAGE 1480
ELECT. EBM'T'S. AS PER AFFIDAVIT - EXHIBIT 'A' (NOT LOCATED BY SURVEY)

LEGAL DESCRIPTION -
LOT 1, CONQUISTADOR ADDITION TO THE CITY OF WICHITA, SEDWICK COUNTY, KANSAS

I HEREBY CERTIFY THAT THIS SURVEY WAS CONDUCTED BY ME OR UNDER MY DIRECT SUPERVISION ON VARIOUS DATES THROUGH JUNE 25, 1974 AND THIS DRAWING IS A TRUE AND CORRECT EXHIBIT THEREOF.

JOHN J. HALL
REGISTERED SURVEYOR
LS-341
KANSAS
L.S. # 54

SURVEY OF -
CONQUISTADOR APARTMENTS

CONQUISTADOR APARTMENTS PARTNERSHIP
301 NORTH MICHIGAN AVENUE
CHICAGO, ILLINOIS 60601

BZA 23-74

OFFICE COPY
DO NOT REMOVE


OFFICE COPY
DO NOT REMOVE

REVISED	7-6-74	TLR
REVISED	6-14-74	RJH
REVISED	6-24-74	JH
REVISED	7-8-74	JH
REVISED	7-18-74	GM

DATE REVISION	6-4-74	JH
PROJECT	CONQUISTADOR 2	
LOCATION	WICHITA, KANSAS	
DRAWN BY	MM	1770
CHECKED BY	JH	1770
DATE	7-17-74	
SHEET NO.	2	2

HALL & ASSOCIATES
LAND SURVEYORS
TELEPHONE 318-885-2304
WICHITA, KANSAS 67207

FILED FROM THE BEST AVAILABLE COPY

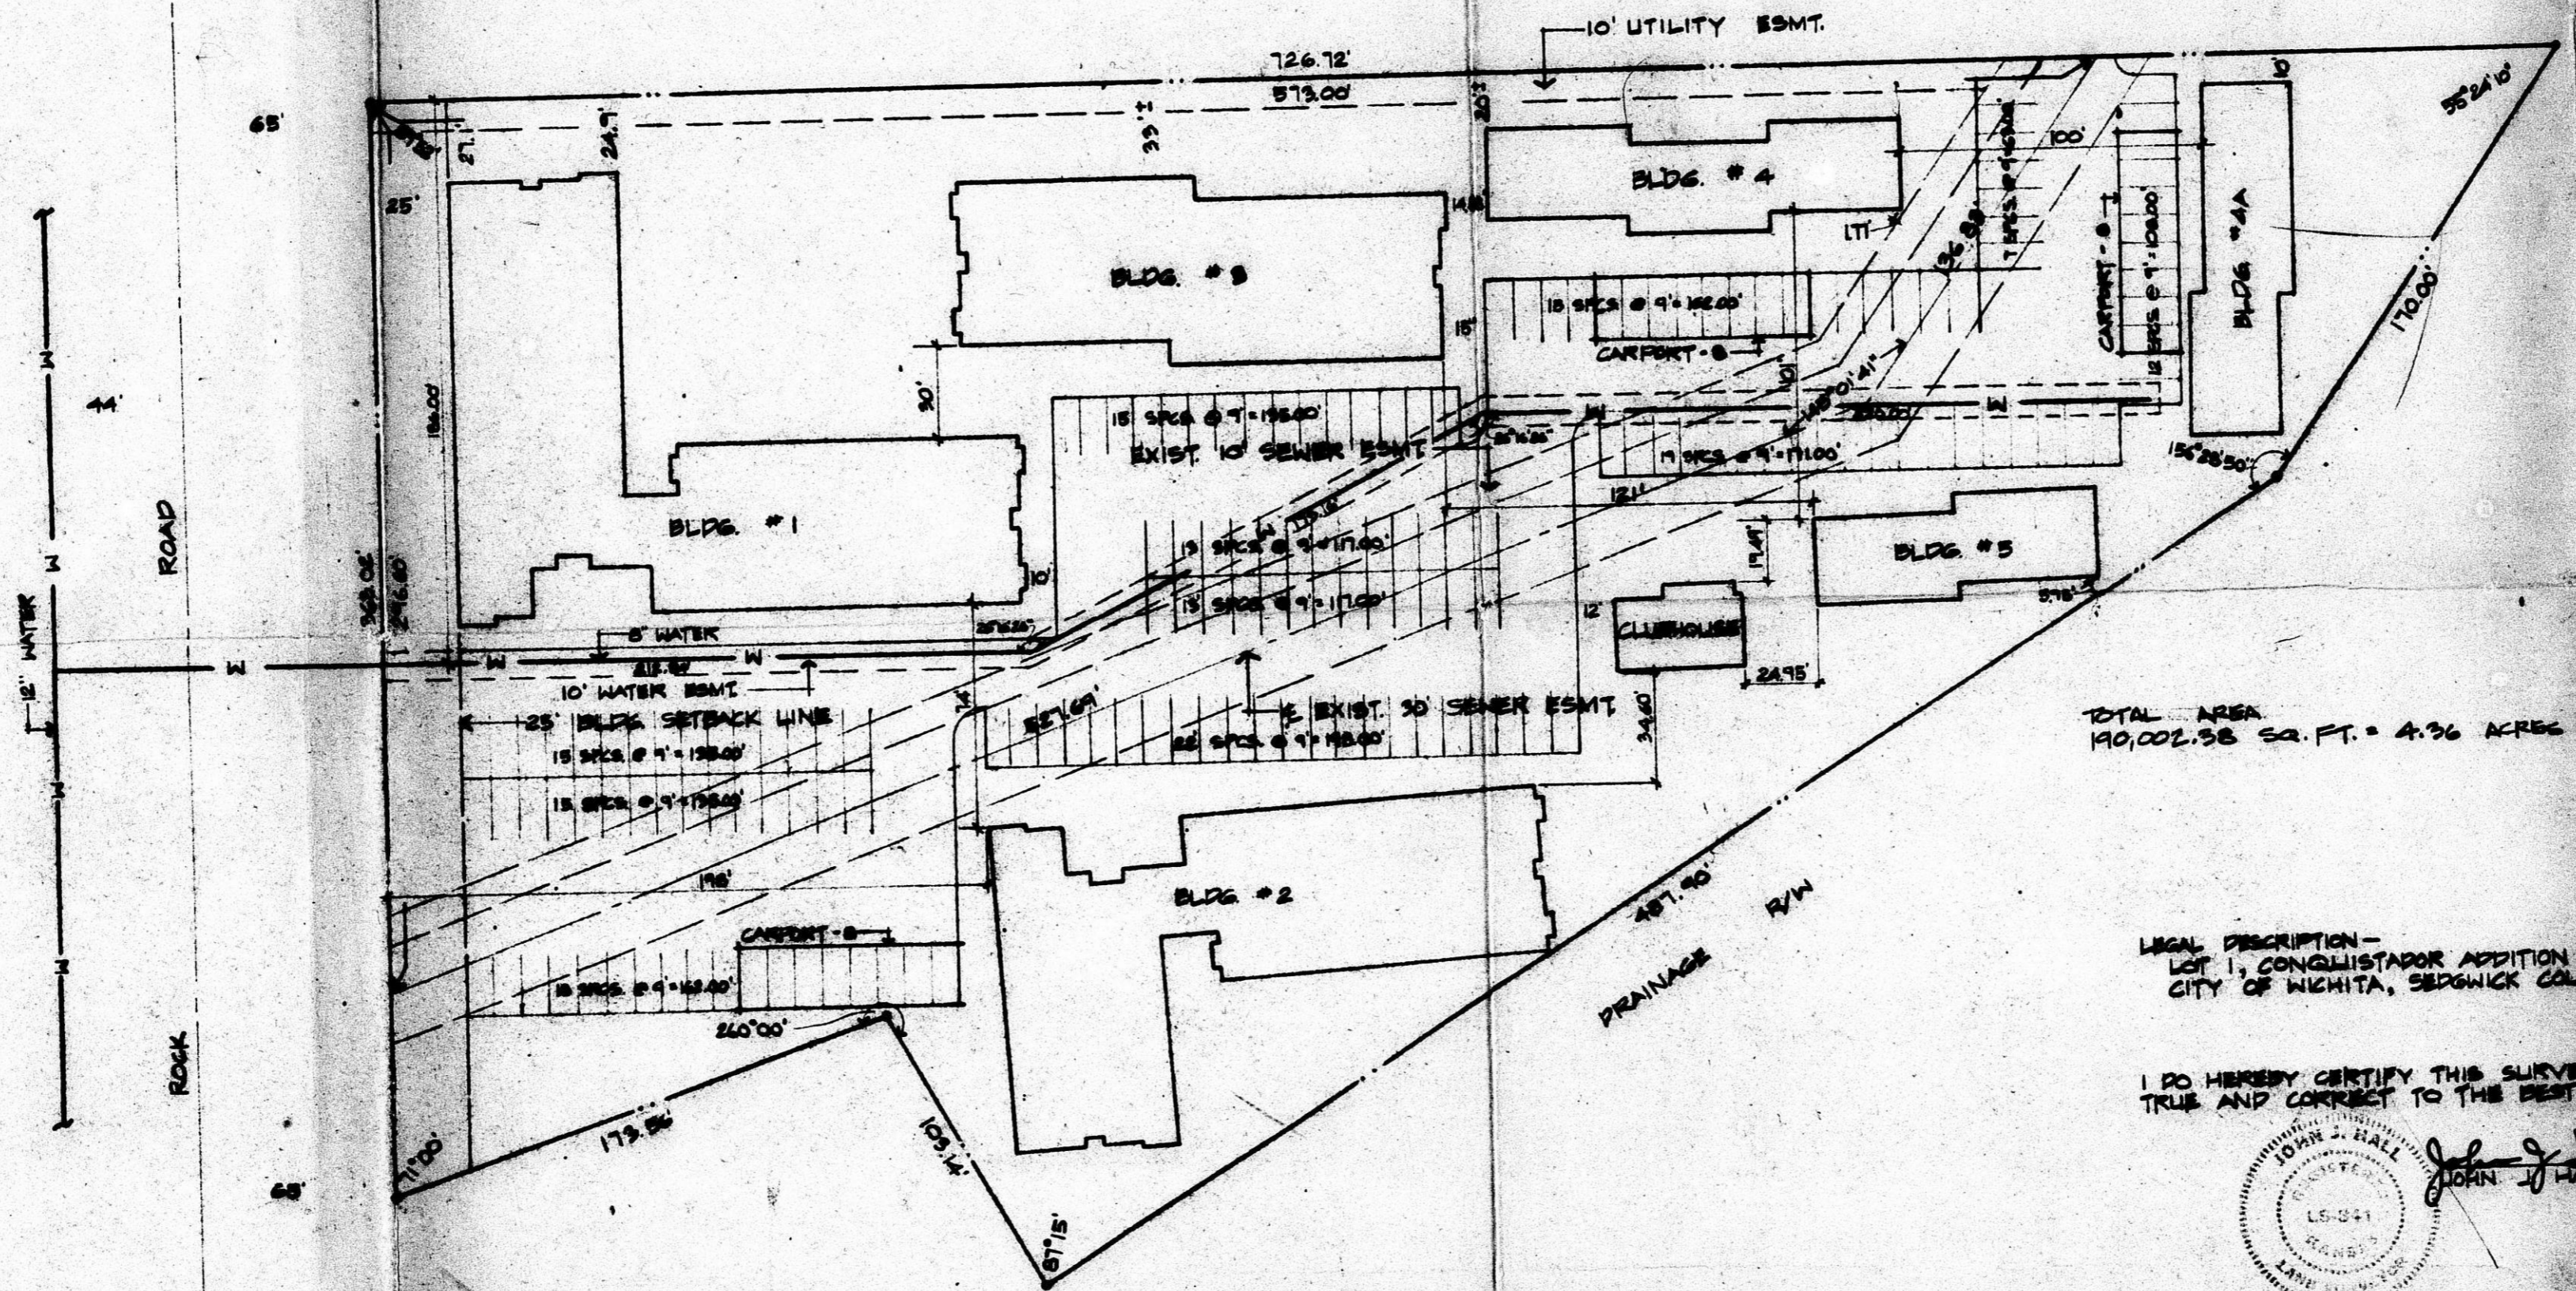

TOTAL AREA
190,002.98 SQ. FT. = 4.36 ACRES ±

LEGAL DESCRIPTION -
LOT 1, CONQUISTADOR ADDITION TO THE
CITY OF WICHITA, SEDGWICK COUNTY, KANSAS.

I DO HEREBY CERTIFY THIS SURVEY TO BE
TRUE AND CORRECT TO THE BEST OF MY KNOWLEDGE.

JOHN J. HALL
L.S. # 541

SURVEY OF -
CONQUISTADOR APARTMENTS

CONQUISTADOR APARTMENTS PARTNERSHIP
301 NORTH MICHIGAN AVENUE
CHICAGO, ILLINOIS 60601

BZA 23-74

HALL & ASSOCIATES
LAND SURVEYOR
TELEPHONE 316-888-2304

DATE RECEIVED	6-4-76	J.M.
PROJECT	CONQUISTADOR I	
LOCATION	WICHITA, KANSAS	
BY		
DATE	7-76	
BY	J.M.	
DATE	7-76	

FILED FROM THE BEST
AVAILABLE COPY