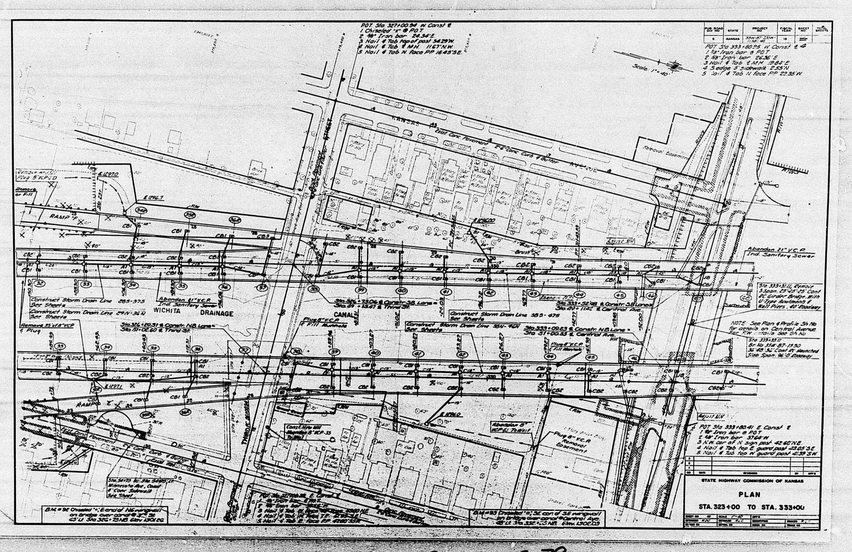

BZA 23-79

FILMED FROM THE BEST AVAILABLE COPY

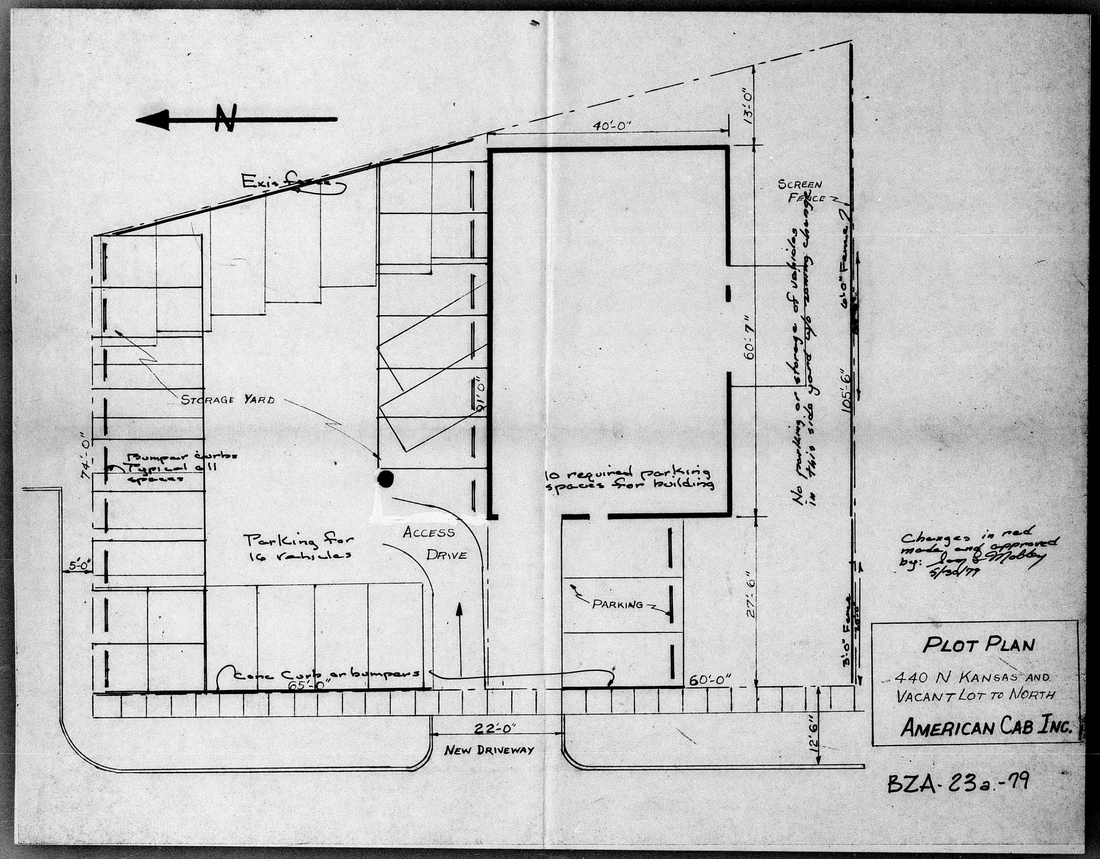

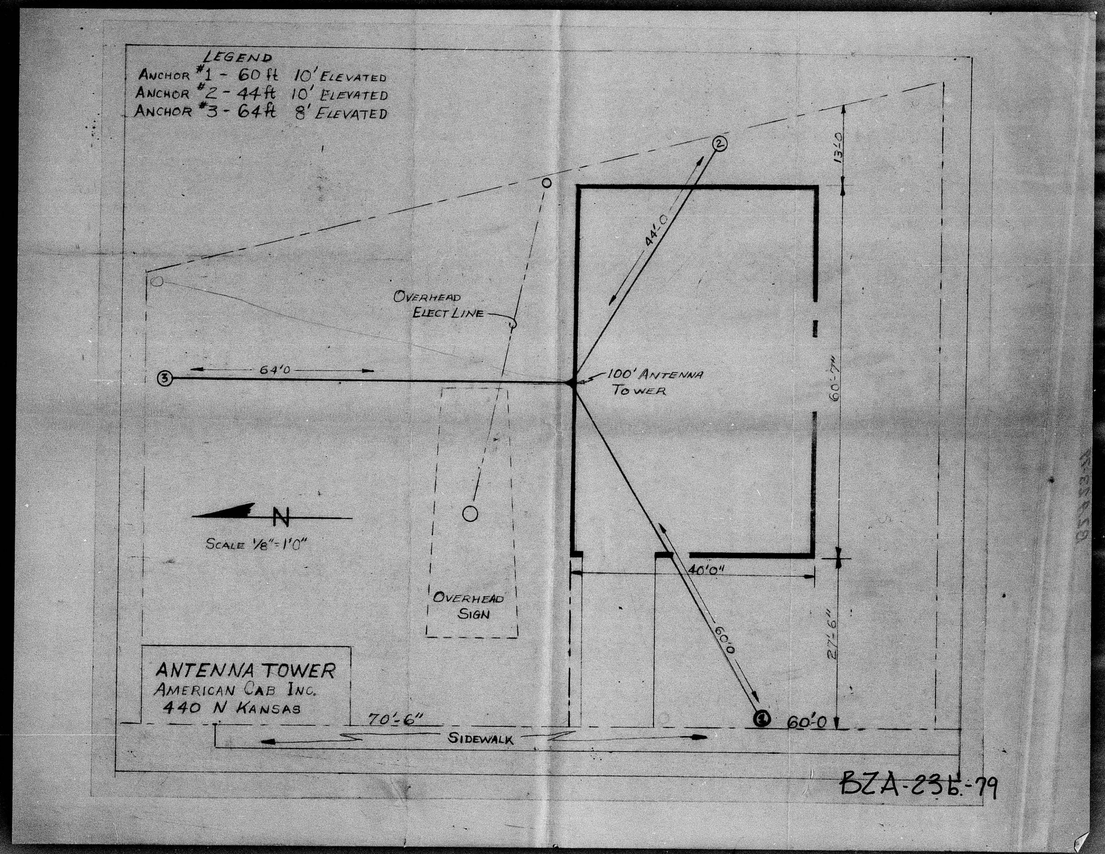

FILMED FROM THE BEST AVAILABLE COPY