Map No. E-10=B
Sec. 17
Twp. 27S
Range 2E

Z-
SCZ-
CU- 97
Filed 1-5-67

APPLICATION DATA: From _____ to _____

1. Applicant: Bouse & Clark Construction Co., Inc.
   Address 1624 United Founders Towers, Okla. City, Oklahoma
2. Agent: Paul M. Buchanan
   Address 830 First National Bank Bldg. Phone AM 4-1376
3. General Location: On the north side of Central in an area east of Longford Lane Address _____
4. Proposed Use: Establishment of a nursing home in "R-1"

AREA DATA:

1. Acres: 2.06 (300 ft. by 300 ft.)
2. Adjoining Zoning: E AA S R-1 W AA N R-1
3. Land Use: East Vacant South Single family
   West Vacant North Vacant
4. Sketch Plan Land Use is for: Residential
5. Present Land Use is for: Vacant
6. Area XXXXX(is not) platted.
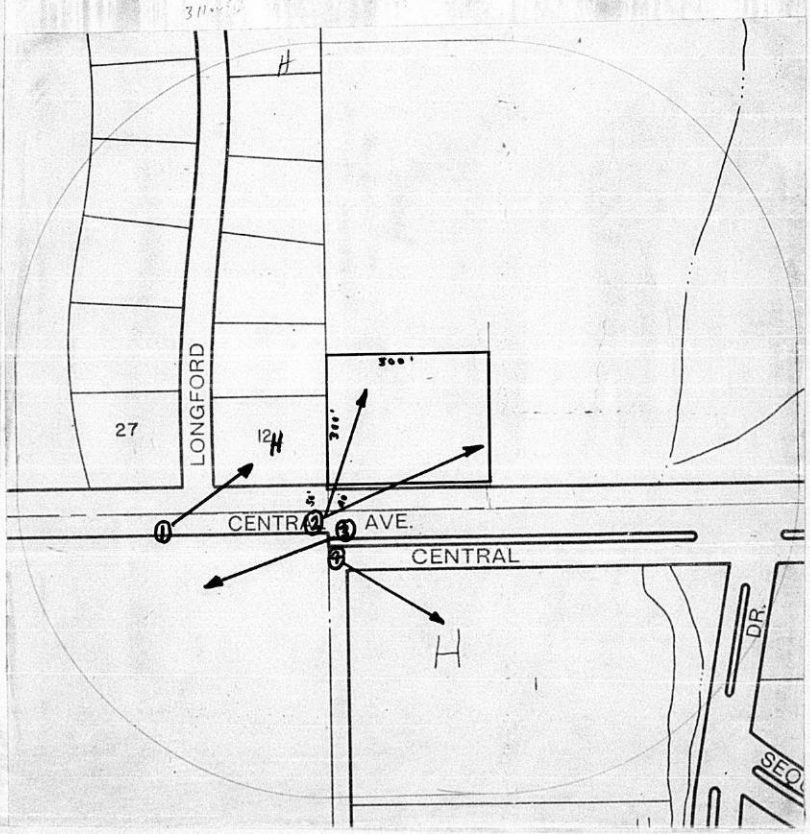
PHOTO DATA:
Taken by _____ Date _____ Time _____