

ACTION

S/S COMMITTEE <sup>DATE</sup> No hearing necessary  
M.A.P.C. No hearing necessary,  
Requirements of above case 2-12-70  
B.C.C. ~~RECEIVED~~ accepted 11-24-70

*Accepted*

D-0461 - Ray D. Huston dedicates street right-of-way on east side of Oliver in area between Douglas and First Streets

DEDICATION REPORT AND PROGRESS

MAP No. 5847  
 SEC. No. 24  
 TWP. No. 27 S  
 RANGE 1E

CASE No. D - 0461

I. OFFER TO DEDICATE: street right-of-way  
 GENERALLY LOCATED: On the east side of Oliver in an area between Douglas and First Streets

LEGALLY DESCRIBED AS:


The west 10 feet of Lots 5, 7, and 9, Block 8, East Boulevard Addition, Wichita, Sedgwick County, Kansas.

DEDICATED BY: Ray D. Huston, et. al.

AGENT: Roscoe Williams  
 ADDRESS: 150 North Oliver PHONE 682-3581  
 PURPOSE OF DEDICATION:

*Requirement of associated zone case 2-1212, "B" to "BB".*

II. SKETCH.

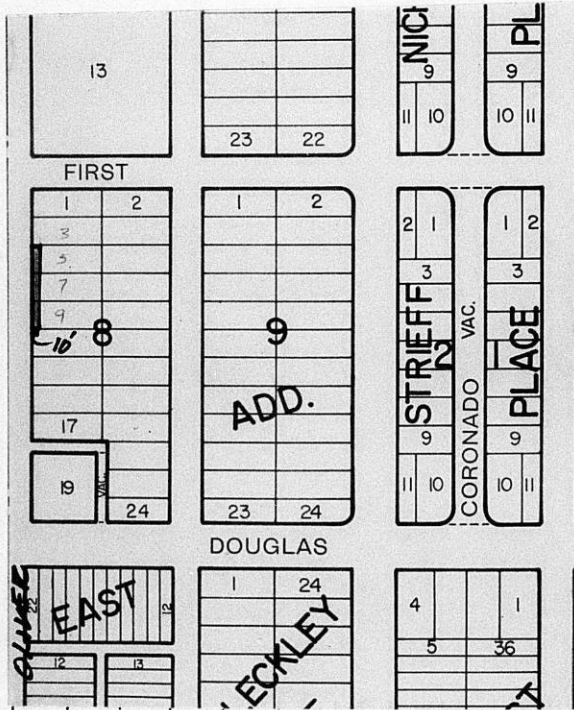

III. FILED 11-18-70 B.C.C. ACTION 11-24-70  
 POSTED TO ATLAS 11-23-70 PLACED ON RECORD accepted  
 S/D COMM. ACTION n/a CITY CLERKS No. \_\_\_\_\_  
 M.A.P.C. ACTION n/a

DEDICATION

KNOW ALL MEN BY THESE PRESENTS:

That for and in consideration of the sum of One Dollar (\$1.00) and other good and valuable considerations, the receipt of which is hereby acknowledged, the undersigned, Ray D. Huston, ~~Miriam E. Huston,~~ Thelma

Julia Emery, and Lester B. Kappelman  
and Contract Purchaser  
being the owners/ of the following described real estate in Sedgwick County, Kansas, to wit:

The West ten (10) feet of Lots 5, 7 and 9, Block 8, East Boulevard Addition, Wichita, Sedgwick County, Kansas.

do hereby dedicate the above described real estate to the public for street right-of-way purposes.

Executed this 17<sup>th</sup> day of November 19 70.

Ray D. Huston  
Ray D. Huston

Julia Emery  
Julia Emery

Thelma Huston  
Thelma Huston

Lester B. Kappelman  
Lester B. Kappelman


STATE OF KANSAS )  
SEDGWICK COUNTY ) ss

BE IT REMEMBERED, that on this 17<sup>th</sup> day of November,

came Ray D. Huston, ~~Miriam E. Huston,~~ Julia Emery, and Lester B. Kappelman  
Thelma

to me personally known to be the same persons who executed the foregoing instrument and duly acknowledged the execution of the same.

IN WITNESS WHEREOF, I have hereunto subscribed my name and affixed my official seal, the day and year last above written.

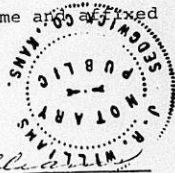

J.R. Williams  
J.R. Notary Public Williams

My Commission Expires: 9/17/72

Submitted to the Wichita-Sedgwick County Metropolitan Area Planning Commission and the Board of Commissioners of the City of Wichita, Kansas, and approved by said Board of Commissioners of the City of Wichita, Kansas,  
this \_\_\_\_\_,  
\_\_\_\_\_  
City Clerk