




APPROVED PARKING PLAN

DR 74-34

OFFICE COPY  
DO NOT REMOVE

Note Grading Contractor Volume I, Stockpile 1,000 Cu.Yds. in this area as directed by the Architect for arena floor cover.

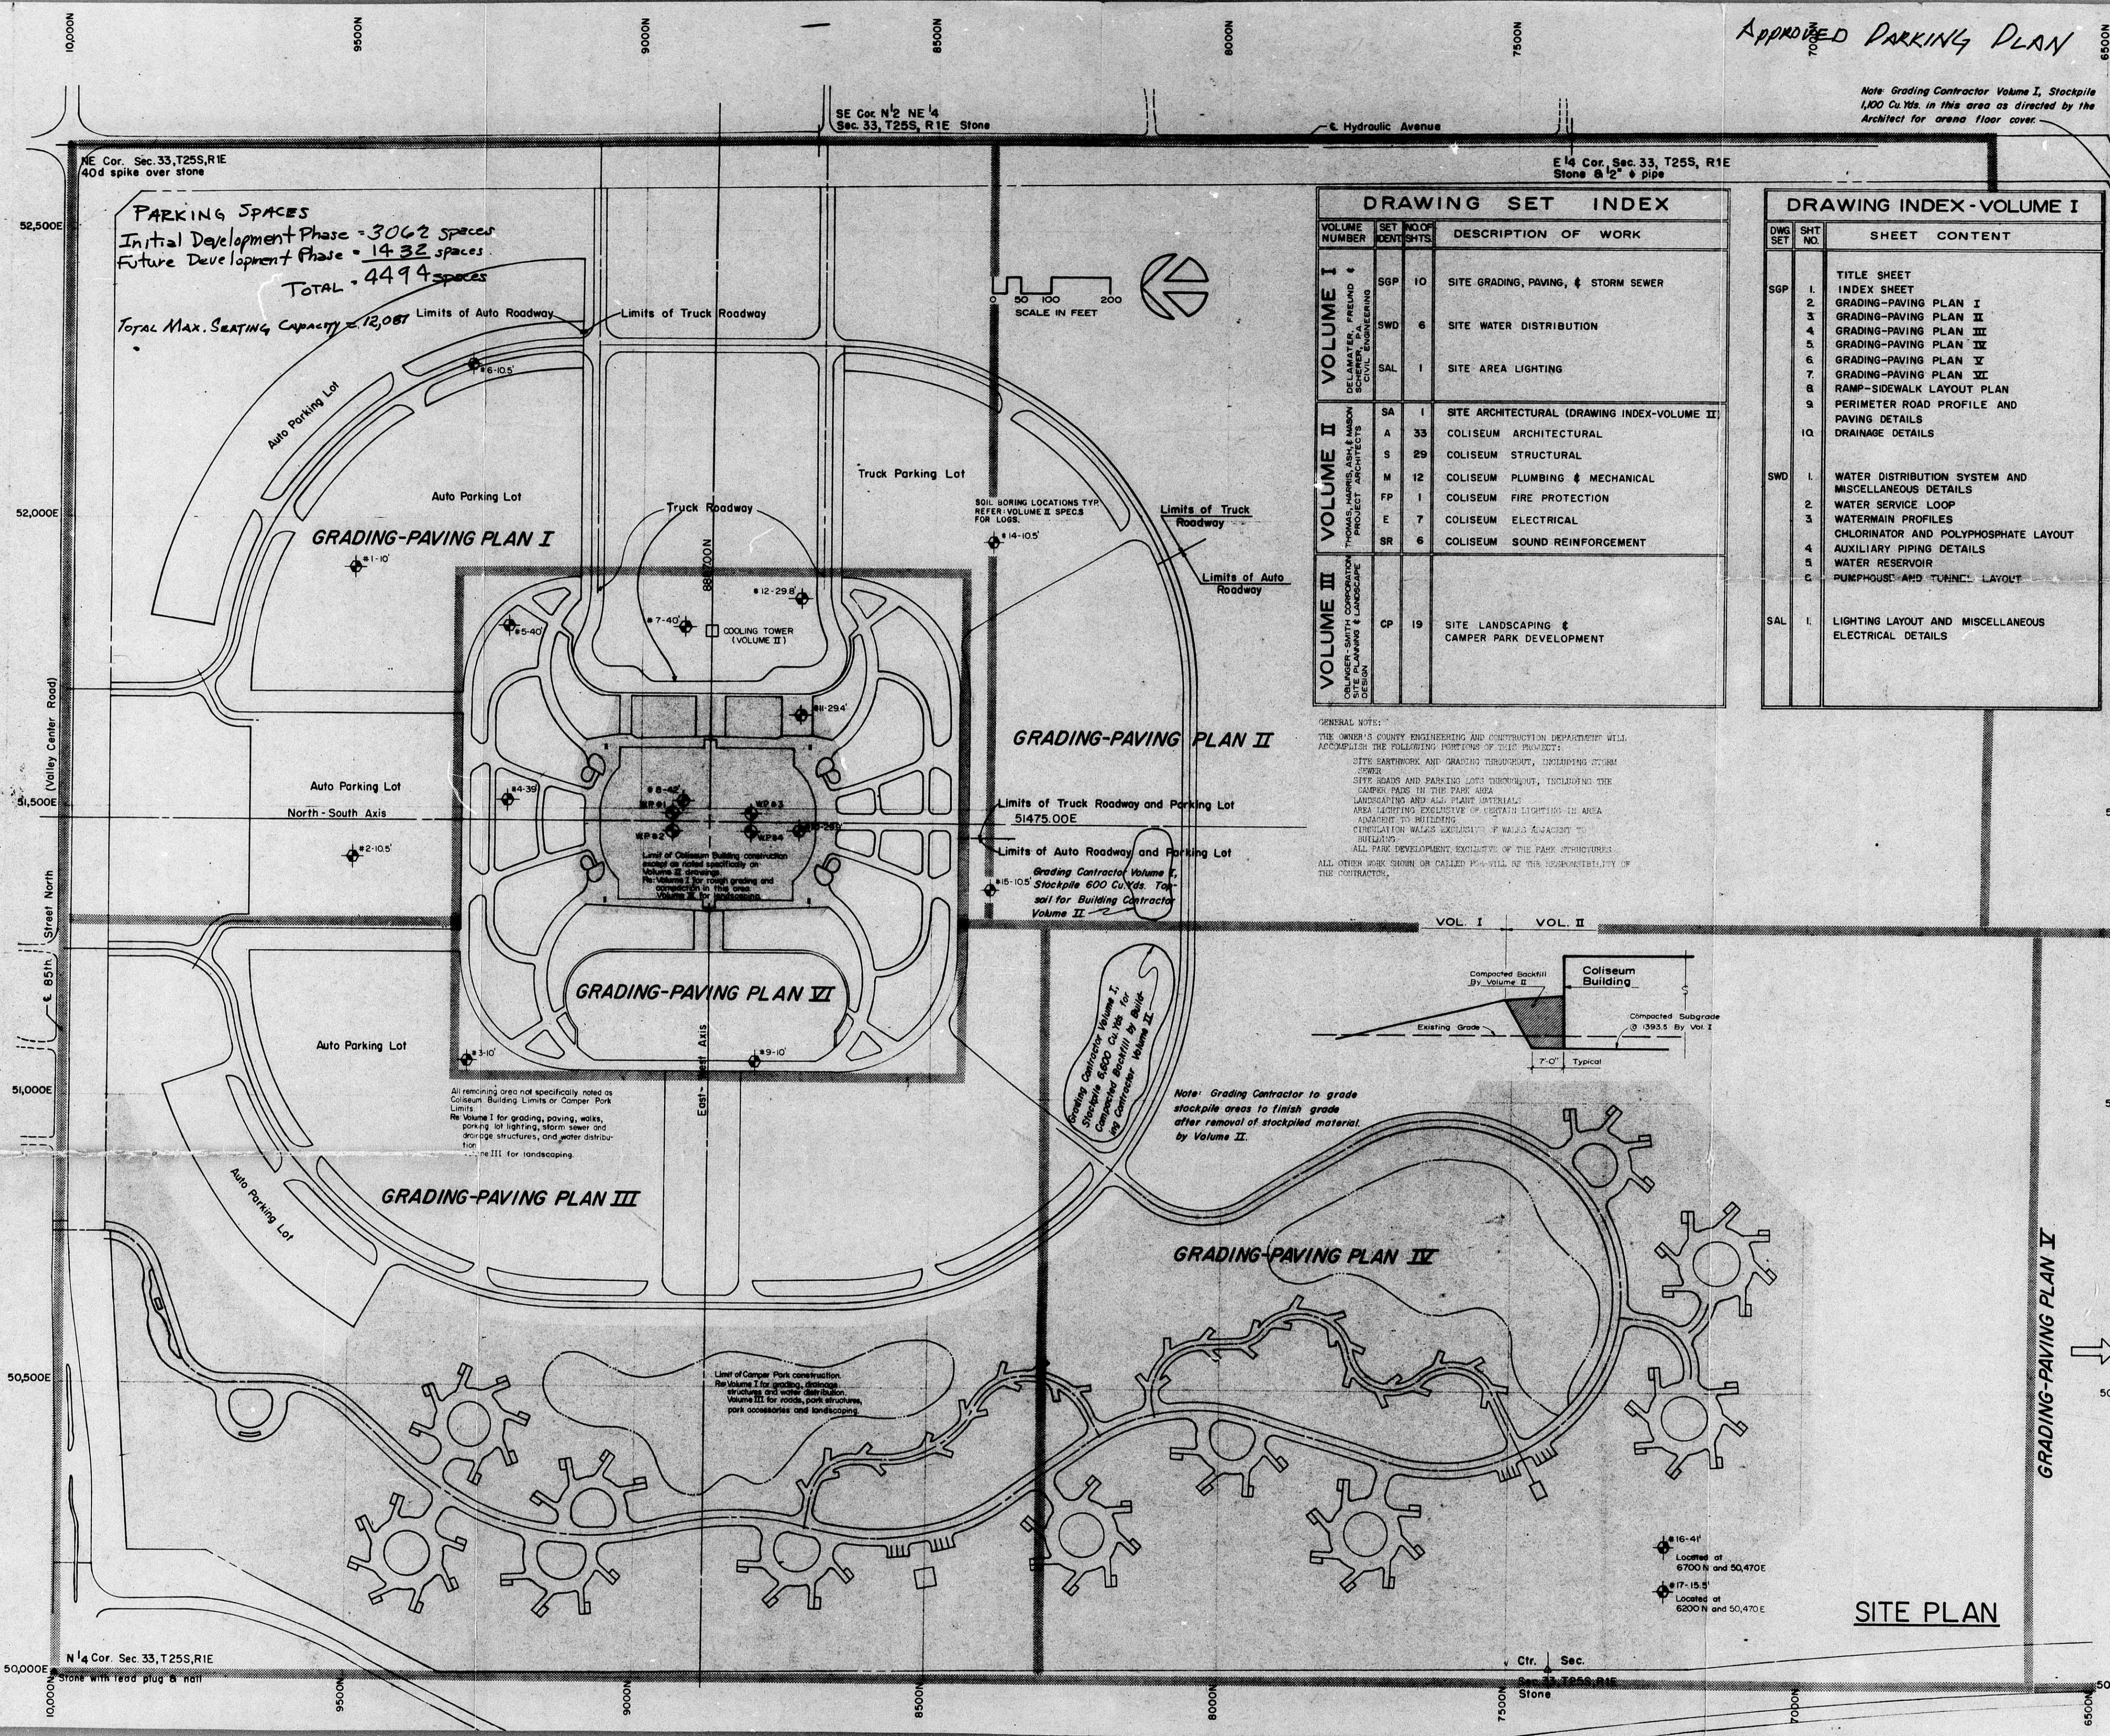


**PARKING SPACES**  
 Initial Development Phase = 3062 spaces  
 Future Development Phase = 1432 spaces  
**TOTAL = 4494 spaces**  
 Total Max. Seating Capacity = 12,087

DRAWING SET INDEX			
VOLUME NUMBER	SET NO. OF SHEETS	DESCRIPTION OF WORK	
VOLUME I	SGP 10	SITE GRADING, PAVING, & STORM SEWER	
	SWD 6	SITE WATER DISTRIBUTION	
	SAL 1	SITE AREA LIGHTING	
VOLUME II	SA 1	SITE ARCHITECTURAL (DRAWING INDEX-VOLUME II)	
	A 33	COLISEUM ARCHITECTURAL	
	S 29	COLISEUM STRUCTURAL	
	M 12	COLISEUM PLUMBING & MECHANICAL	
	FP 1	COLISEUM FIRE PROTECTION	
	E 7	COLISEUM ELECTRICAL	
VOLUME III	CP 19	SITE LANDSCAPING & CAMPER PARK DEVELOPMENT	

DRAWING INDEX - VOLUME I		
DWG SET	SHT NO.	SHEET CONTENT
SGP	1	TITLE SHEET
	2	INDEX SHEET
	3	GRADING-PAVING PLAN I
	4	GRADING-PAVING PLAN II
	5	GRADING-PAVING PLAN III
	6	GRADING-PAVING PLAN IV
	7	GRADING-PAVING PLAN V
	8	RAMP-SIDEWALK LAYOUT PLAN
	9	PERIMETER ROAD PROFILE AND PAVING DETAILS
	10	DRAINAGE DETAILS
SWD	1	WATER DISTRIBUTION SYSTEM AND MISCELLANEOUS DETAILS
	2	WATER SERVICE LOOP
	3	WATERMAIN PROFILES
	4	CHLORINATOR AND POLYPHOSPHATE LAYOUT
	5	AUXILIARY PIPING DETAILS
	6	WATER RESERVOIR
SAL	1	PUMPHOUSE AND TUNNEL LAYOUT
SAL	1	LIGHTING LAYOUT AND MISCELLANEOUS ELECTRICAL DETAILS

GENERAL NOTE:  
 THE OWNER'S COUNTY ENGINEERING AND CONSTRUCTION DEPARTMENT WILL ACCOMPLISH THE FOLLOWING PORTIONS OF THIS PROJECT:  
 CIRCULATION WALKS EXCLUSIVE OF WALKS ADJACENT TO BUILDING  
 ALL PARK DEVELOPMENT EXCLUSIVE OF THE PARK STRUCTURES  
 ALL OTHER WORK SHOWN OR CALLED FOR WILL BE THE RESPONSIBILITY OF THE CONTRACTOR.

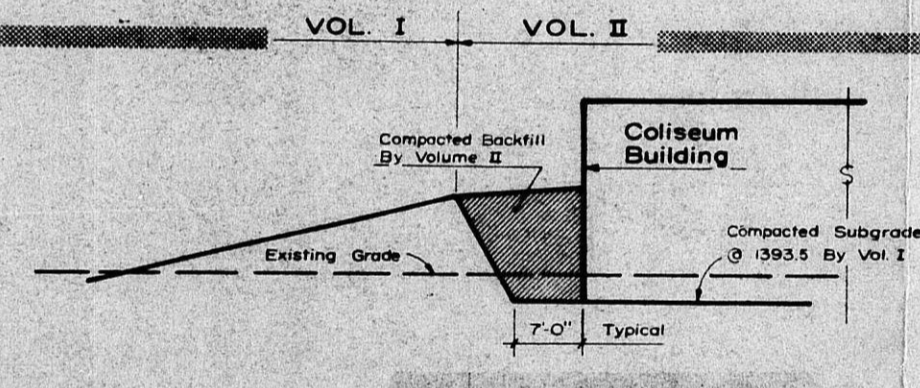

oblinger-smith corporation  
 CONSULTANTS IN PLANNING  
 625 First National Bank Building  
 Wichita, Kansas 67202

DELMATER, FREUND & SCHREER, P.A.  
 ENGINEERS & ARCHITECTS  
 WICHITA, KANSAS  
 276-A-1

KANSAS COLISEUM  
 SEDGWICK COUNTY, KANSAS  
 BOARD OF COUNTY COMMISSIONERS  
 ECONOMIC DEVELOPMENT ADMINISTRATION  
 PROJECT NO. 05-1-01384  
 UNITED STATES DEPARTMENT OF COMMERCE

INDEX SHEET

SGP I  
**VOL. I**  
 of 10

FILMED FROM THE BEST AVAILABLE COPY