


APPROVED 8/12/23 BY [Signature]

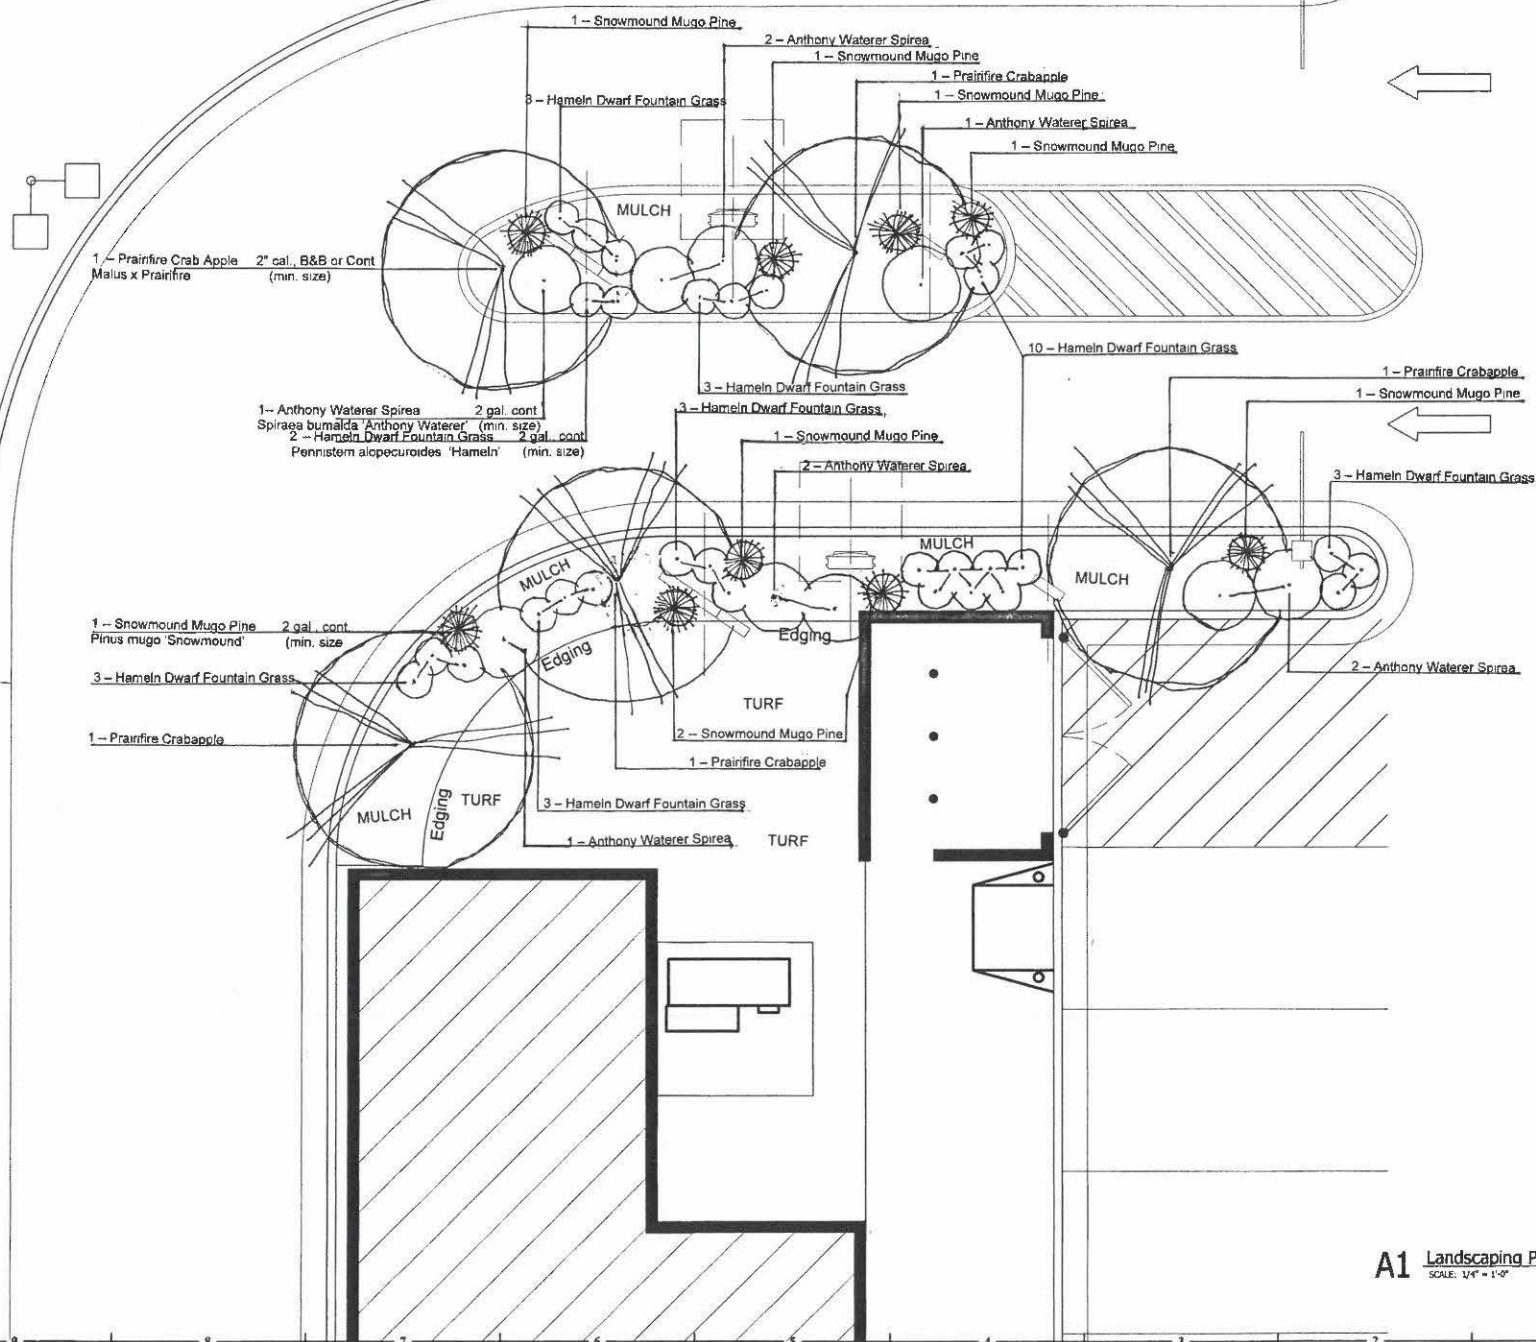

NOTE TREES/SHRUBS NEED WATERING, UNTIL ESTABLISHED FIRST YEAR MINIMUM!

P: 913.307.3700 • F: 913.307.3710 www.hoeternysocial.com

LANDSCAPING PLAN