



Wichita-Sedgwick County Metropolitan Area Planning Department

September 25, 2023

Terry Irwin
2231 Forest View
Wichita, KS 67223

Re: BZA2023-00051: Administrative Adjustment in the County to permit an accessory structure (pole barn) in front of the principal structure on property less than five acres, zoned SF-20 Single-Family Residential, and located on the west side of North Forest View Street, within one-block north of West 21st Street North (2231 Forest View).

Legal Description: Lots 10 and 11, Block 2, Forest View Addition, Sedgwick County, Kansas.

Dear Applicant:

We have reviewed your request for a Zoning Adjustment to permit an accessory structure (pole barn, approximately 40 feet X 40 feet) in front of the principal structure on 1.45 acres. The accessory structure will be setback behind the 30-foot platted front building setback, approximately 40 feet from the front property line (east).

Sec. V-I.2.n of the Unified Zoning Code allows a Zoning Adjustment that would permit an accessory structure to be placed in front of the principal structure on less than five acres of land, when the conditions required by Sec. V-I.6 of the Code are met. We find that permitting an accessory structure in front of the principal structure on the subject property meets the four conditions required by Sec. V-I.6 of the Unified Zoning Code as set out below:

- 1) Impact on safety and convenience of vehicular and pedestrian circulation: This request is to allow a new pole barn to be placed in front of a primary structure on a private lot as shown on the attached site plan. Public vehicular and pedestrian circulation will not be affected, and the structure will not interfere with traffic circulation patterns as it will be placed behind the 30-foot platted building setback line, approximately 40 feet from the front property line.
- 2) Impact on existing uses in surrounding areas: It is not anticipated that there will not be any negative impact on the existing uses in surrounding areas as a result of the structure being placed in front of the house as it will be approximately 40 feet from the front property line.
- 3) Compatibility with existing or permitted uses on abutting sites: Placing an accessory structure in front of a principal structure is within allowable adjustments and should not detract from the existing or permitted uses on abutting sites, which are single family residences with detached accessory structures.
- 4) Effect on public health, safety or welfare: There will be no encroachment into public utility easements or right-of-way. There will be no negative impact on the public health, safety or welfare, nor will properties or improvements in the vicinity be materially injured.

Our signatures below indicate that a Zoning Adjustment to permit an accessory structure to be placed in front of the principal structure on less than five acres of land for the aforementioned property is hereby GRANTED, subject to the following conditions:

- 1) The permitting of an accessory structure in front of the principal structure shall apply only to the proposed pole barn illustrated on the approved site plan. All other structures or additions on the subject property shall conform to the development standards of the Unified Zoning Code unless a separate Zoning Adjustment or Variance is granted.
- 2) If the Zoning Administrator finds that there is a violation of any of the conditions of the Zoning Adjustment, the Zoning Administrator, in addition to enforcing the other remedies set forth in the Unified Zoning Code, may, with the concurrence of the Planning Director, declare that the Zoning Adjustment is null and void.

The "Development Application" sign should now be removed from the property.




Scott Wadle, Director
Metropolitan Area Planning Department



J.R. COX JR.

Chris Labrum, Director
Metropolitan Area Building and Construction
Department

cc: MABCD
David Dennis, BoCC District 3

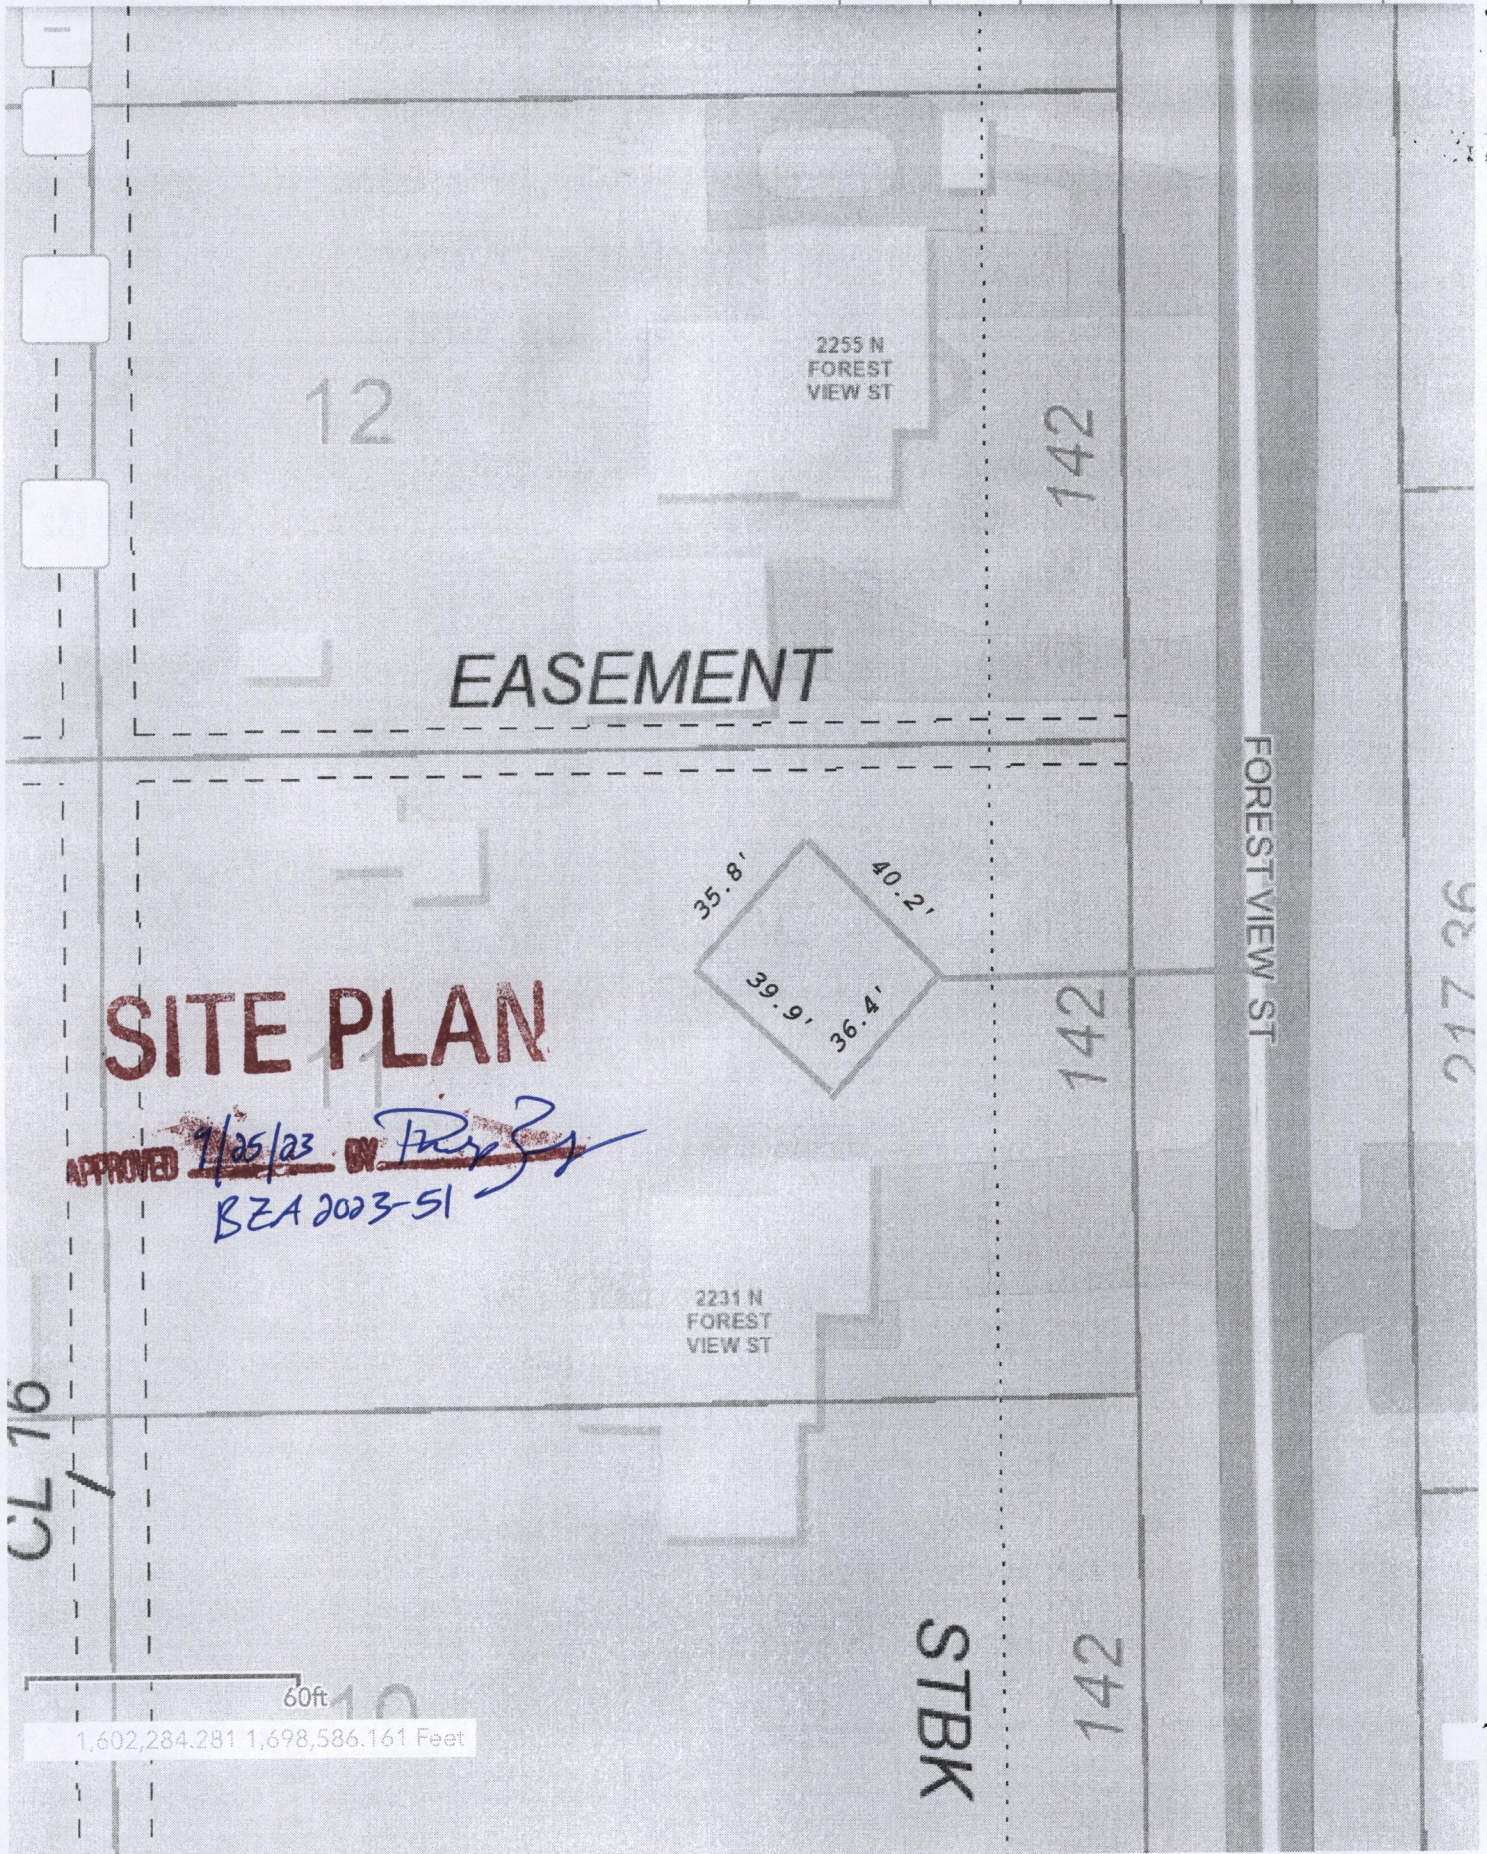

SITE PLAN

APPROVED 1/25/23 BY [Signature]
 BZA 2023-51

CL 16

2231 N FOREST VIEW ST

2255 N FOREST VIEW ST

FOREST VIEW ST

142

142

142

STBK

60ft

1,602,284.281 1,698,586.161 Feet