




BAUGHMAN COMPANY

315 Ellis St.
Wichita, KS 67211
316-262-7271
BaughmanCo.com

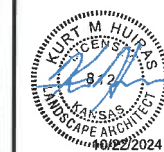

ALL STATES EXTERIORS
LOT 1, BLK. A, WESTPORT 3RD ADD.
WICHITA, KS

REVISION: DATE:
CITY COMMENTS
Landscape 10/22/2024

PROJECT NUMBER:
22-08-E282
DESIGN: TJW DRAWN: KMH
DATE: 12/09/2022

SITE LANDSCAPE PLAN

L1.0

LANDSCAPE PLAN


APPROVED 12/30/24
PO#167
Supercedes plan
Approved 8/15/23

LEGEND

Existing Utilities				Proposed Utilities			

TREES	QTY	BOTANICAL NAME	COMMON NAME	CONT.
	3	GLEDTISIA TRIACANTHOS INERMIS 'SHADEMASTER'	SHADEMASTER HONEY LOCUST	10 GAL
	9	JUNIPERUS SCOPULORUM 'MOONGLOW'	MOONGLOW JUNIPER	5' TALL MIN.
	1	MALUS X 'JFS-KWS'	ROYAL RAINDROPS® CRABAPPLE	B & B
	2	QUERCUS SHUMARDII 'QSFTC'	PANACHE® SHUMARD OAK	2" CALIPER MIN.
	7	ULMUS PARVIFOLIA 'ALLEE'	ALLEE® LACEBARK ELM	2" CALIPER MIN.
	6	ZELKOVA SERRATA 'MUSASHINO'	MUSASHINO JAPANESE ZELKOVA	B & B
SHRUBS	QTY	BOTANICAL NAME	COMMON NAME	CONT.
	45	JUNIPERUS X 'GREY OWL'	GREY OWL JUNIPER	5 GAL
	33	SPIRAEA JAPONICA 'ANTHONY WATERER'	ANTHONY WATERER JAPANESE SPIREA	5 GAL

NOTE: ALL AREAS NOT COVERED BY PAVEMENT, LANDSCAPE BEDS, AND BUILDING HAVE BEEN ESTABLISHED WITH THE APPROPRIATE TURF

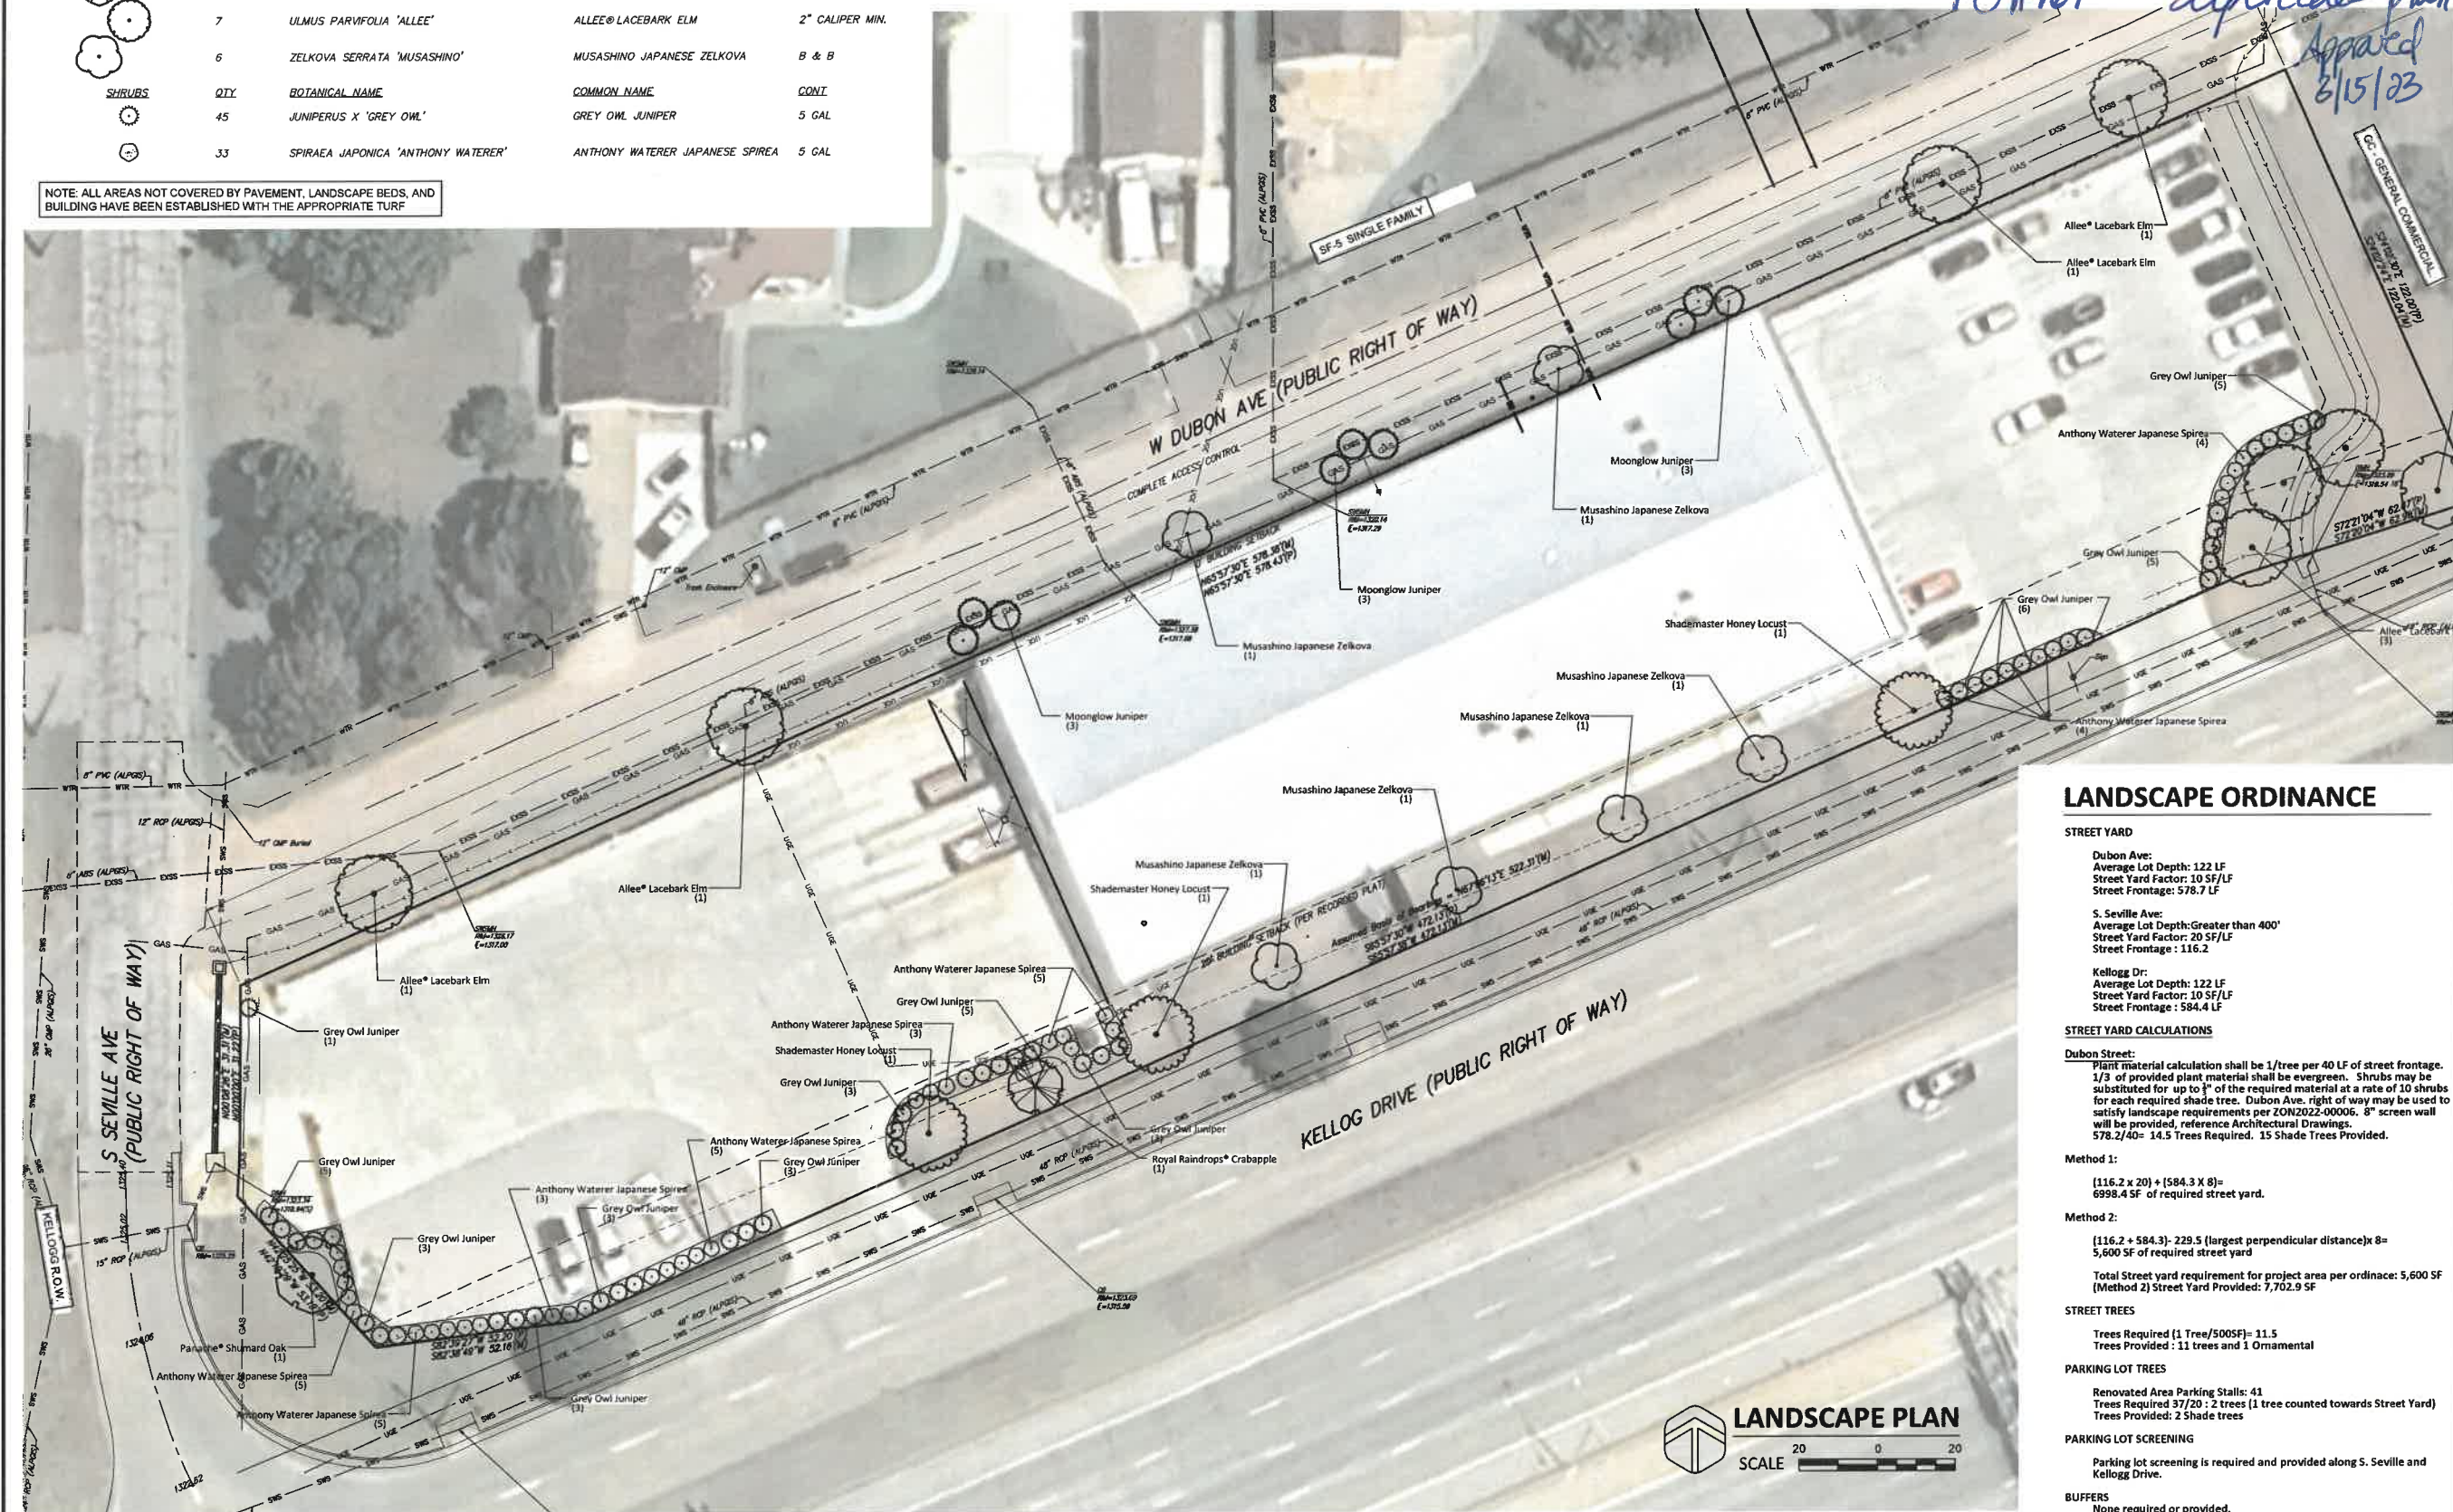

LANDSCAPE ORDINANCE

STREET YARD

Dubon Ave:
Average Lot Depth: 122 LF
Street Yard Factor: 10 SF/LF
Street Frontage: 578.7 LF

S. Seville Ave:
Average Lot Depth: Greater than 400'
Street Yard Factor: 20 SF/LF
Street Frontage: 116.2

Kellogg Dr:
Average Lot Depth: 122 LF
Street Yard Factor: 10 SF/LF
Street Frontage: 584.4 LF

STREET YARD CALCULATIONS

Dubon Street:
Plant material calculation shall be 1/tree per 40 LF of street frontage. 1/3 of provided plant material shall be evergreen. Shrubs may be substituted for up to 1/3 of the required material at a rate of 10 shrubs for each required shade tree. Dubon Ave. right of way may be used to satisfy landscape requirements per ZON2022-00006. 8" screen wall will be provided, reference Architectural Drawings. 578.2/40= 14.5 Trees Required. 15 Shade Trees Provided.

Method 1:
[116.2 x 20] + [584.3 x 8] = 6998.4 SF of required street yard.

Method 2:
[116.2 + 584.3] - 229.5 (largest perpendicular distance) x 8 = 5,600 SF of required street yard

Total Street yard requirement for project area per ordinance: 5,600 SF (Method 2) Street Yard Provided: 7,702.9 SF

STREET TREES

Trees Required (1 Tree/500SF) = 11.5
Trees Provided : 11 trees and 1 Ornamental

PARKING LOT TREES

Renovated Area Parking Stalls: 41
Trees Required 37/20 : 2 trees (1 tree counted towards Street Yard)
Trees Provided: 2 Shade trees

PARKING LOT SCREENING

Parking lot screening is required and provided along S. Seville and Kellogg Drive.

BUFFERS

None required or provided.

