VACATION REPORT AND PROGRESS

MAP NO. 6160B
SEC. NO. _____
TWP. NO. _____
RANGE _____

CASE NO: V - 1193

ASSOCIATED CASE: _____

1. VACATION OF: the east-west and the north-south alleys in Block 11, Furley, Sedgwick Co., Kansas.
GENERALLY LOCATED: north of 101st St. North and west of Greenwich Road

744-3100
REQUESTED BY: Bobby D. Eilert, et al, Rte 1, Box 105A, Valley Center 67147
AGENT: Alan Joseph
ADDRESS: Box 2373, Suite 210, 434 N. Market, 67201 PHONE 265-9650
REASON FOR REQUEST:

2. SKETCH.

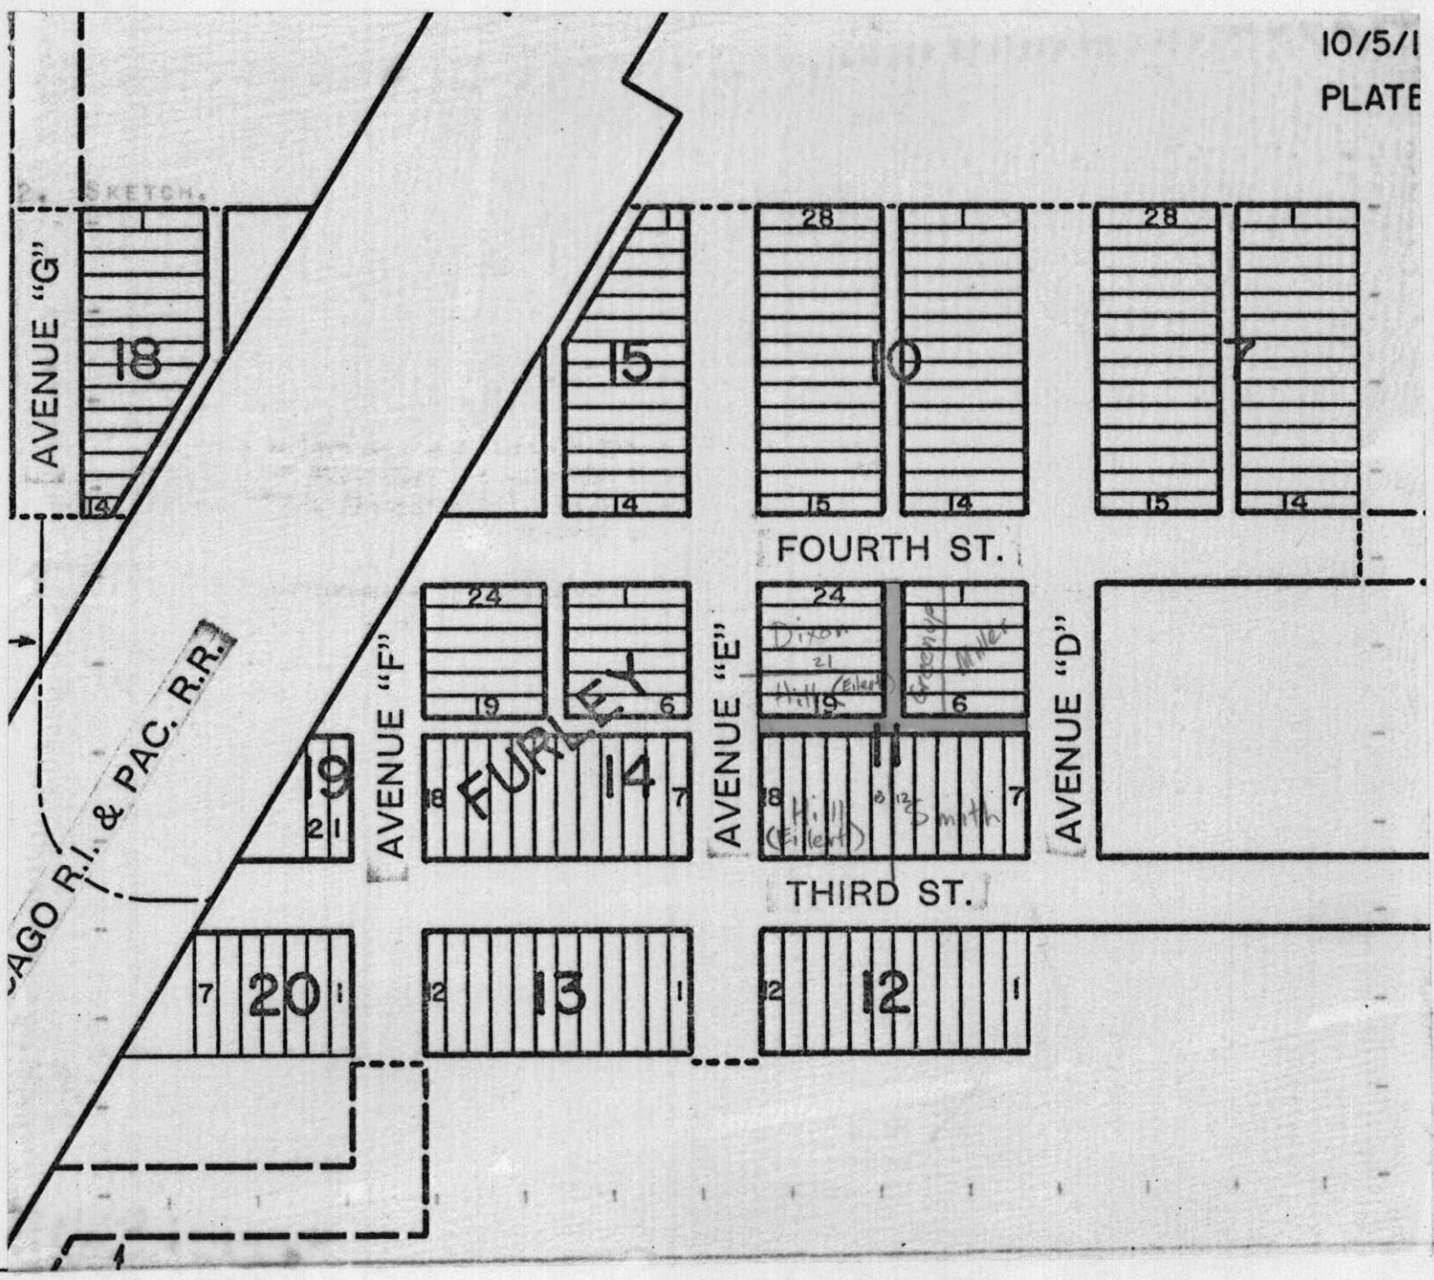

3. APPLICATION FILED 5-25-83
POSTED TO ATLAS _____
NOTICES SENT _____
S/D COMM. ACTION 6-9-83 approve
DEPT. REPORT _____
M.A.P.C. ACTION 6-16-83 approve
DEPT. REPORT _____

ORD/RES. SUBMITTED _____
APPROVED BY DEPT OF LAW _____
B.C.C. ACTION _____
ORD/RES _____ PUBLISHED _____
BD. CO. CO. ACTION 7-27-83 approve
ORDER TO VACATE RECORDED _____

T9-307

BEFORE THE BOARD OF COUNTY COMMISSIONERS
OF SEDGWICK COUNTY, KANSAS

IN THE MATTER OF THE VACATION
OF
THE EAST-WEST ALLEY AND THE
NORTH-SOUTH ALLEY IN BLOCK 11,
FURLEY, SEDGWICK COUNTY, KANSAS.

VACATION ORDER

Now on this _____ day of _____, 19__, at 9:00 o'clock A.M. comes on for hearing the petition filed herein by _____, praying for the vacation of the following described alleys:

The east-west alley and the north-south alley in Block 11, Furley, Sedgwick County, Kansas.

the said petitioners being represented by their attorney, Alan Joseph.

WHEREUPON, it is shown that proper notice has been given by publication in the _____, a newspaper printed in the State of Kansas and being published in and for general circulation in Sedgwick County, Kansas, the first publication being made on the _____, day of _____, 19__, and proper proof of such publication being filed herein. The Board being advised in the premises finds that such notice is in due legal form and conforms to K.S.A. 1970 Supp. 12-504.

THEREAFTER, the matter is presented to the Board and the Board finds that no private rights will be injured or endangered by such vacation and that the public will suffer no loss or inconvenience thereby, and that in justice to the petitioners, their prayer should be granted and that no written objections have been filed hereto with the County Clerk.

The Board further finds that the Wichita-Sedgwick County Metropolitan Area Planning Commission ; at its regular meeting held on the 16th day of June , 1983, recommended and approved the vacation of the above described alleys .

IT IS THEREFORE BY THE BOARD OF COUNTY COMMISSIONERS, in regular session duly assembled, ordered that the above described _____ hereby vacated.

JACK SPRATT, CHAIRMAN

DONALD E. GRAGG, CHAIRMAN PRO TEM

TOM SCOTT, COMMISSIONER

ATTEST:

DOROTHY K. WHITE, COUNTY CLERK

APPROVED AS TO FORM:

RICHARD EUSON, ASST. COUNTY COUNSELOR

F 8-9

FURLEY,

Sedgwick County,

Kansas.

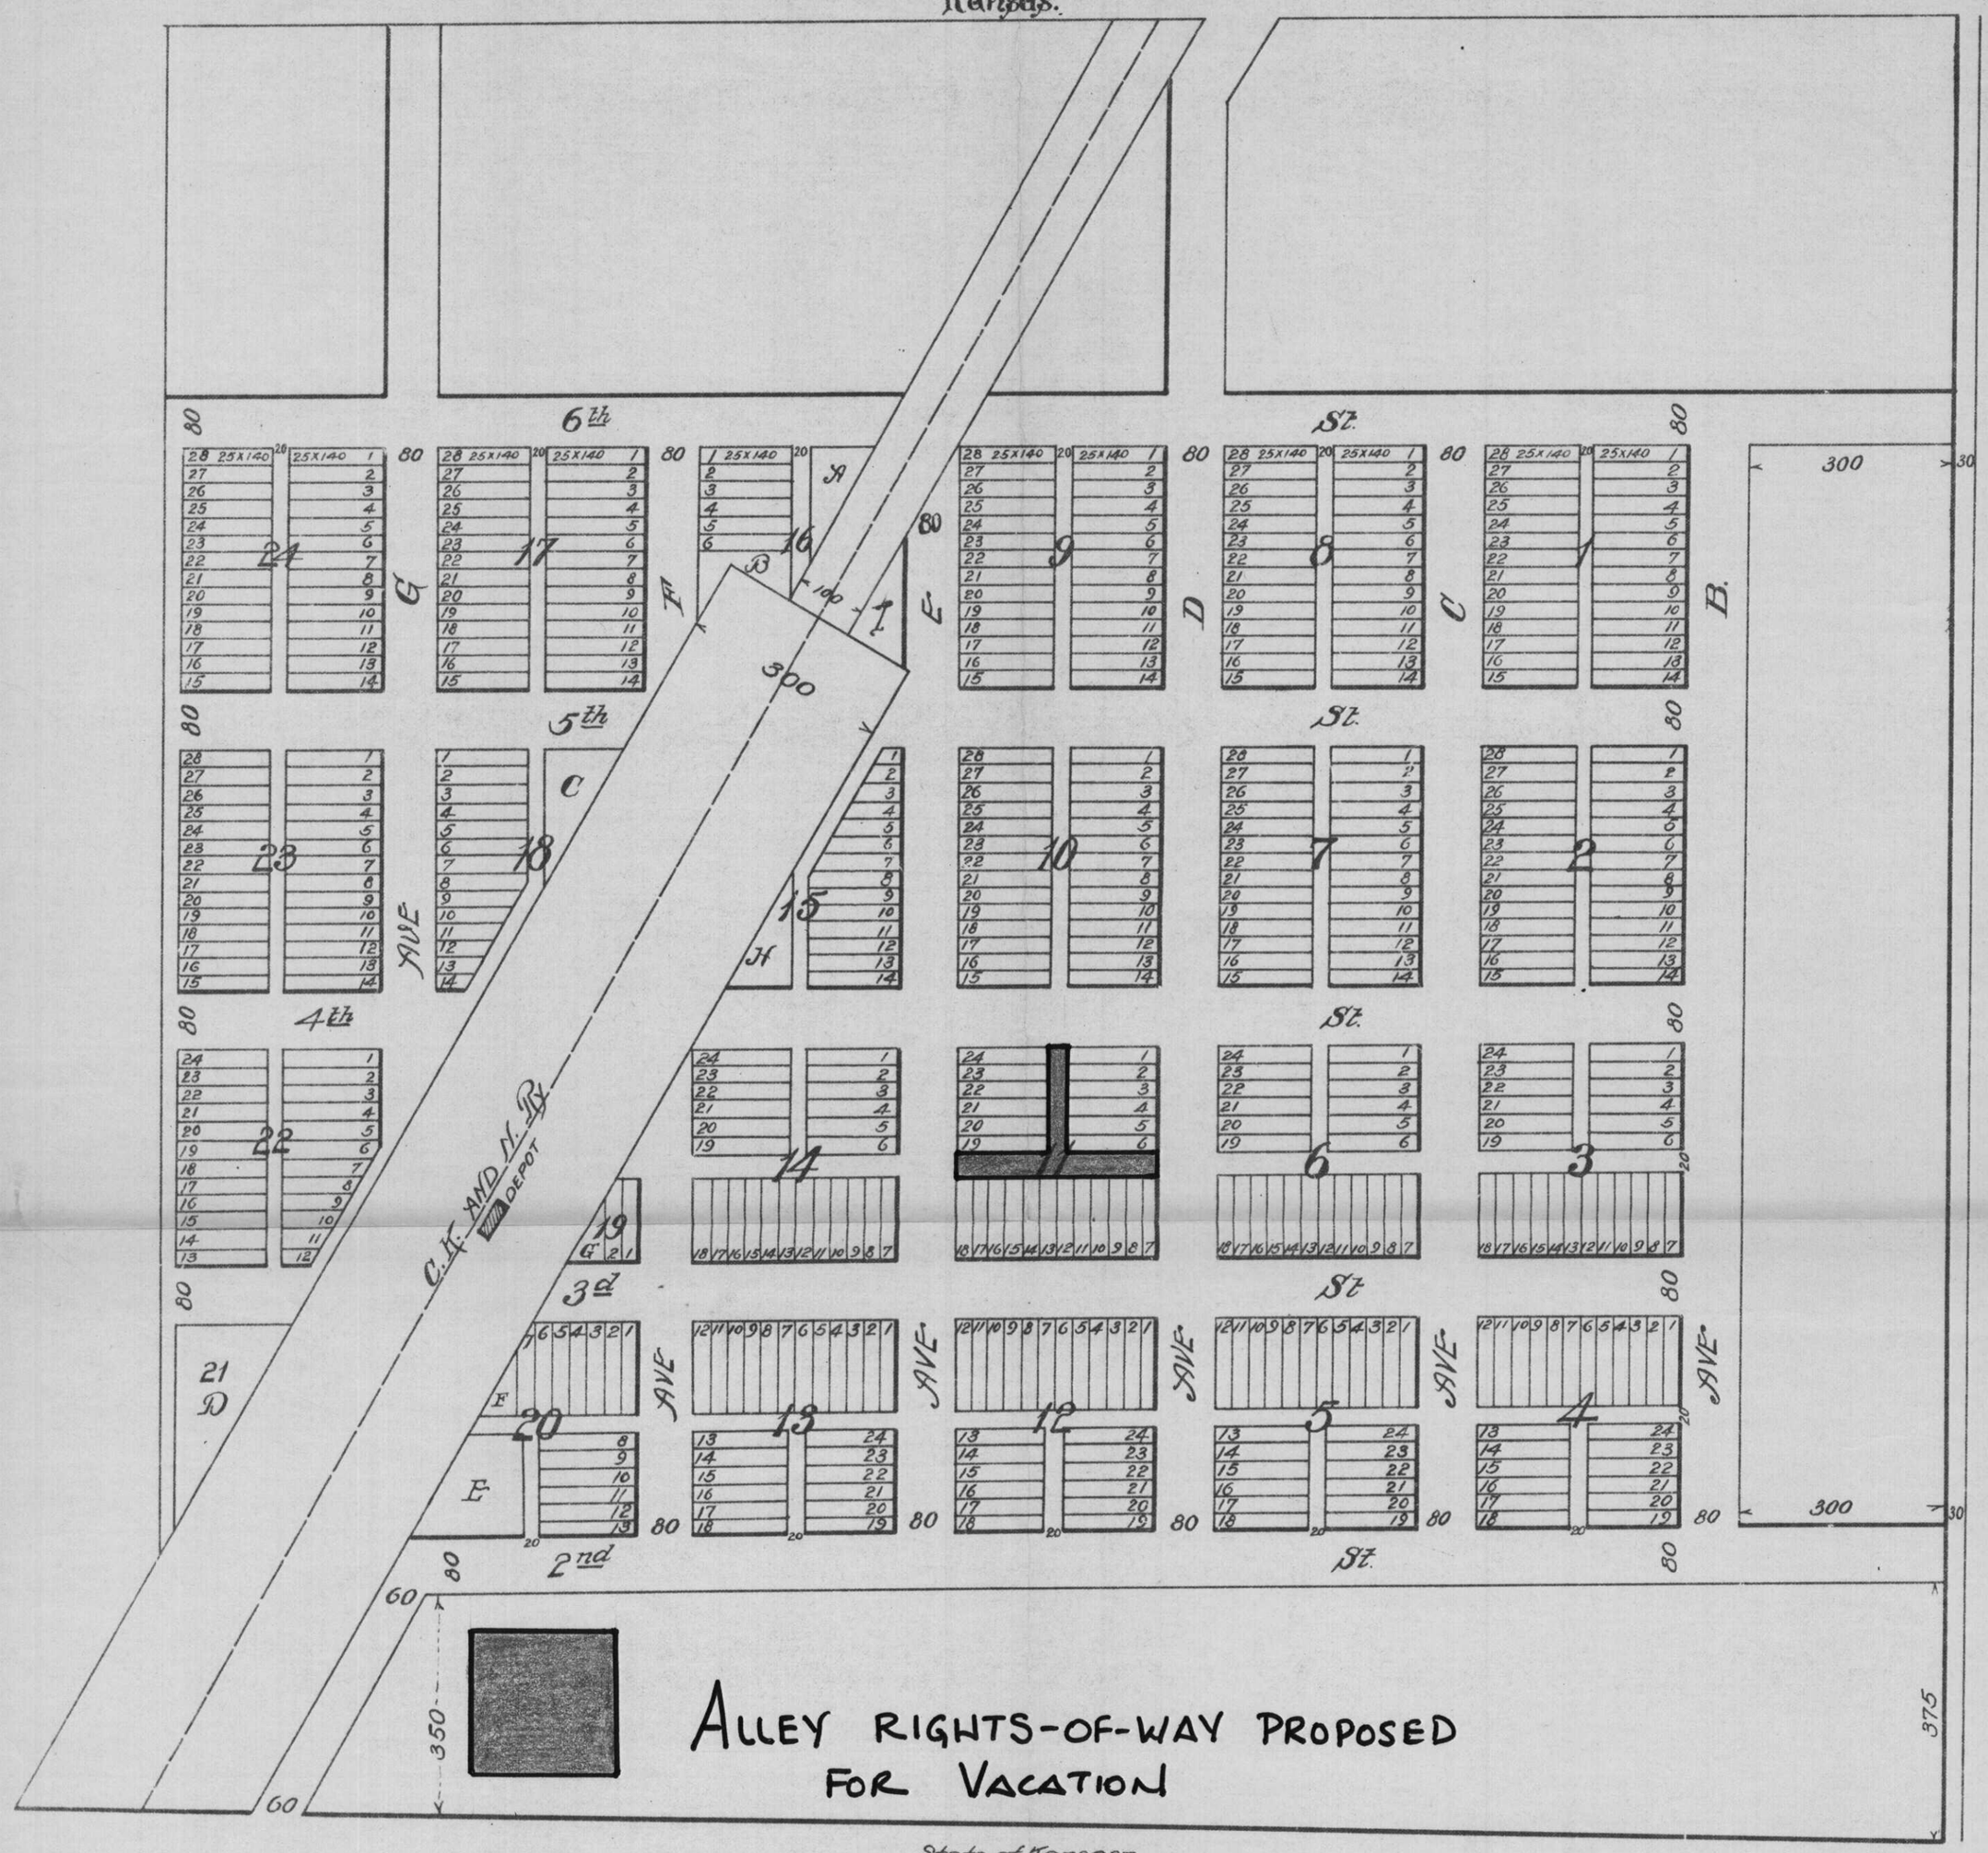

ALLEY RIGHTS-OF-WAY PROPOSED FOR VACATION

Know all men by these presents that that the Golden Belt town Company a corporation duly organized under the laws of the State of Kansas has caused this plat to be made executed and filed by it as a map or plat of a town to be known as the town of Furley, located on a part of the Northeast quarter of section sixteen (16) township twenty five (25) South of range two (2) East in Sedgwick County, Kansas. More particularly described as follows to wit:- Beginning at a point on a line running north 10°-40' west three hundred and seventy five (375) feet north of and three hundred and thirty (330) feet west of the south east corner of said quarter section running thence northerly on said line seventeen hundred and twenty feet (1720) thence westerly at a right angle to said line to the west line of said quarter section, thence southerly on the west line of said quarter section seventeen hundred and twenty (1720) feet, thence easterly on a line to the place of beginning. All streets and alleys are of the width indicated on plat all lots are 25 x 140 feet excepting those in blocks 15, 16, 18, 19, and 22 which are of such dimensions and bounded by such streets alleys and other grounds as indicated by plat. Fractions A, B, C, D, E, F, G, H & I are of such shape and dimensions and bounded by such others grounds as plat indicates.- All streets and alleys are hereby dedicated to the public use. In witness whereof the Golden Belt town Company has caused this plat to be subscribed by its President attested to by its Secretary and the seal of said corporation to be fixed hereunto this ..... day of ..... A.D. 1887.

F.H. Kollock President.
Charles C. Furley Secretary.

THE GOLDEN BELT TOWN COMPANY SEAL

State of Kansas } S.S.
Marion County }

Be it remembered that on this ..... day of May A.D. 1887 before me a Notary Public in and for said county personally came a F.H. Kollock and to me known to be the identical peson described in and who executed the foregoing plat as president of the Golden Belt town company and who duly acknowledged the execution of the same. In testimony whereof I have hereunto set my hand and official seal on the day and year last above written.

Willis Westerbrook.
Notary Public.

Notary Term expires Jany 29-1888.

WILLIS WESTERBROOK NOTARY PUBLIC COM EXPIRES JAN 29 1888 MARION COUNTY KANSAS

State of Kansas }
Sedgwick County } S.S.

Be it remembered that on this 20th day of May 1887 before me a Notary Public in and for said county personally came one C.C. Furley and to me known to be the identical person described in and who executed the foregoing plat as secretary of the Golden Belt town Company and duly acknowledged the execution of the same. In testimony whereof I have hereunto set my hand and official seal the day and year above written.

W.J. Holbrook.

Notary term expires June 9" 1890.

W.J. HOLBROOK NOTARY PUBLIC SEDGWICK CO. KANSAS

FILED 20" MAY 1887 AND RECORDED IN PLAT BOOK P PAGE 7.
H.D. HEISERMAN REGISTER OF DEEDS
GEO F. BEARSE DEPUTY.

ENTERED ON TRANSFER RECORD
MAY 20 1887
E.P. FORD CO. CLERK

I, Joseph Bowman, Register of Deeds of Sedgwick County, Kansas, do hereby certify that the above is a true and correct copy of the plat of Furley, Sedgwick County, Kansas; that the original, of which above is a copy, is on file in my office and that I have the legal custody thereof.

Witness my hand and the seal of my office this 24 day of Feb. 1912.

Joseph Bowman
Register of Deeds.

F 8-9 V-1193