



Wichita-Sedgwick County Metropolitan Area Planning Department

Javier Juarez
1936 S Palisade
Wichita, KS 67213

June 23, 2009

Re: BZA2009-23: Administrative adjustment to allow an accessory structure in front of the primary structure in TF-3 zoning; generally located northeast of the intersection of Palisade and Mt. Vernon. (1936 S. Palisade).

Legal Description: The south half of Lot 39 and all of lots 40 and 41; supplement plat of Rosenthal 5th Addition; Wichita; Sedgwick County; Kansas.

Dear Applicant:

We have reviewed your request for a Zoning Adjustment to permit an accessory structure in front of the principal structure on less than five acres. From reviewing your application, we understand that you propose to construct a detached shed on a .25-acre lot, southwest of the primary structure and in front of the primary structure. The house on this lot is built at the rear of the lot, and no other place is available for an accessory building.

Sec. V-I.2.n. of the Unified Zoning Code allows a Zoning Adjustment that would permit an accessory structure to be placed in front of the principal structure on less than five acres of land, when the conditions required by Sec. V-I.6. of the Code are met. We find that permitting an accessory structure in front of the principal structure on your property meets the four conditions required by Sec. V-I.6. of the Unified Zoning Code as set out below:

- 1) Impact on safety and convenience of vehicular and pedestrian circulation: This request is for a detached shed on a residential lot. Public vehicular and pedestrian circulation will not be affected as the garage will provide sufficient space for parking vehicles on the property and will not interfere with traffic circulation patterns.
- 2) Impact on existing uses in surrounding areas: There should be no negative impact on the existing uses in surrounding areas as a result of the garage being placed in front of the house, as the structure will meet the zoning required building setback, and will not be forward of neighboring houses.

- 3) Compatibility with existing or permitted uses on abutting sites: Placing an accessory structure in front of a principal structure is within allowable adjustments and should not detract from the existing or permitted uses on abutting sites, which are single family residences.
- 4) Effect on public health, safety or welfare: There will be no encroachment into public utility easements or right-of-way; therefore, there should be no negative impact on the public health, safety or welfare nor will properties or improvements in the vicinity be materially injured.


Our signatures below indicate that a Zoning Adjustment to permit an accessory structure to be placed in front of the principal structure on less than five acres of land for the aforementioned property is hereby GRANTED, subject to the following conditions:

- 1) The site shall be developed in general conformance with the approved site plan, and all permits necessary to construct the improvements shall be acquired.
- 2) The allowance of an accessory structure in front of the principal structure shall apply only to the "shed" illustrated on the approved site plan. All other structures or additions on the subject property shall conform to the development standards of the Unified Zoning Code unless a separate Zoning Adjustment or Variance is granted.
- 3) The detached shed shall be constructed with exterior cladding and roof materials similar to the primary structure.
- 4) If the Zoning Administrator finds that there is a violation of any of the conditions of the Zoning Adjustment, the Zoning Administrator, in addition to enforcing the other remedies set forth in the Unified Zoning Code, may, with the concurrence of the Planning Director, declare that the Zoning Adjustment is null and void.

The "Development Application" sign should now be removed from the property.



John L. Schlegel
Planning Director

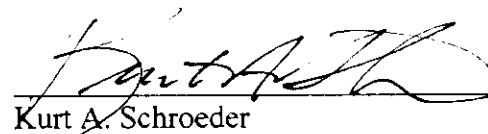


Kurt A. Schroeder
Superintendent of Central Inspection

attachment

cc: Kurt Schroeder, Office of Central Inspection
Mike Gable, Office of Central Inspection
Jim Skelton, District III, Mailstop 1-13

MORTGAGEE TITLE INSPECTION
(THIS DOES NOT CONSTITUTE A BOUNDARY SURVEY!)

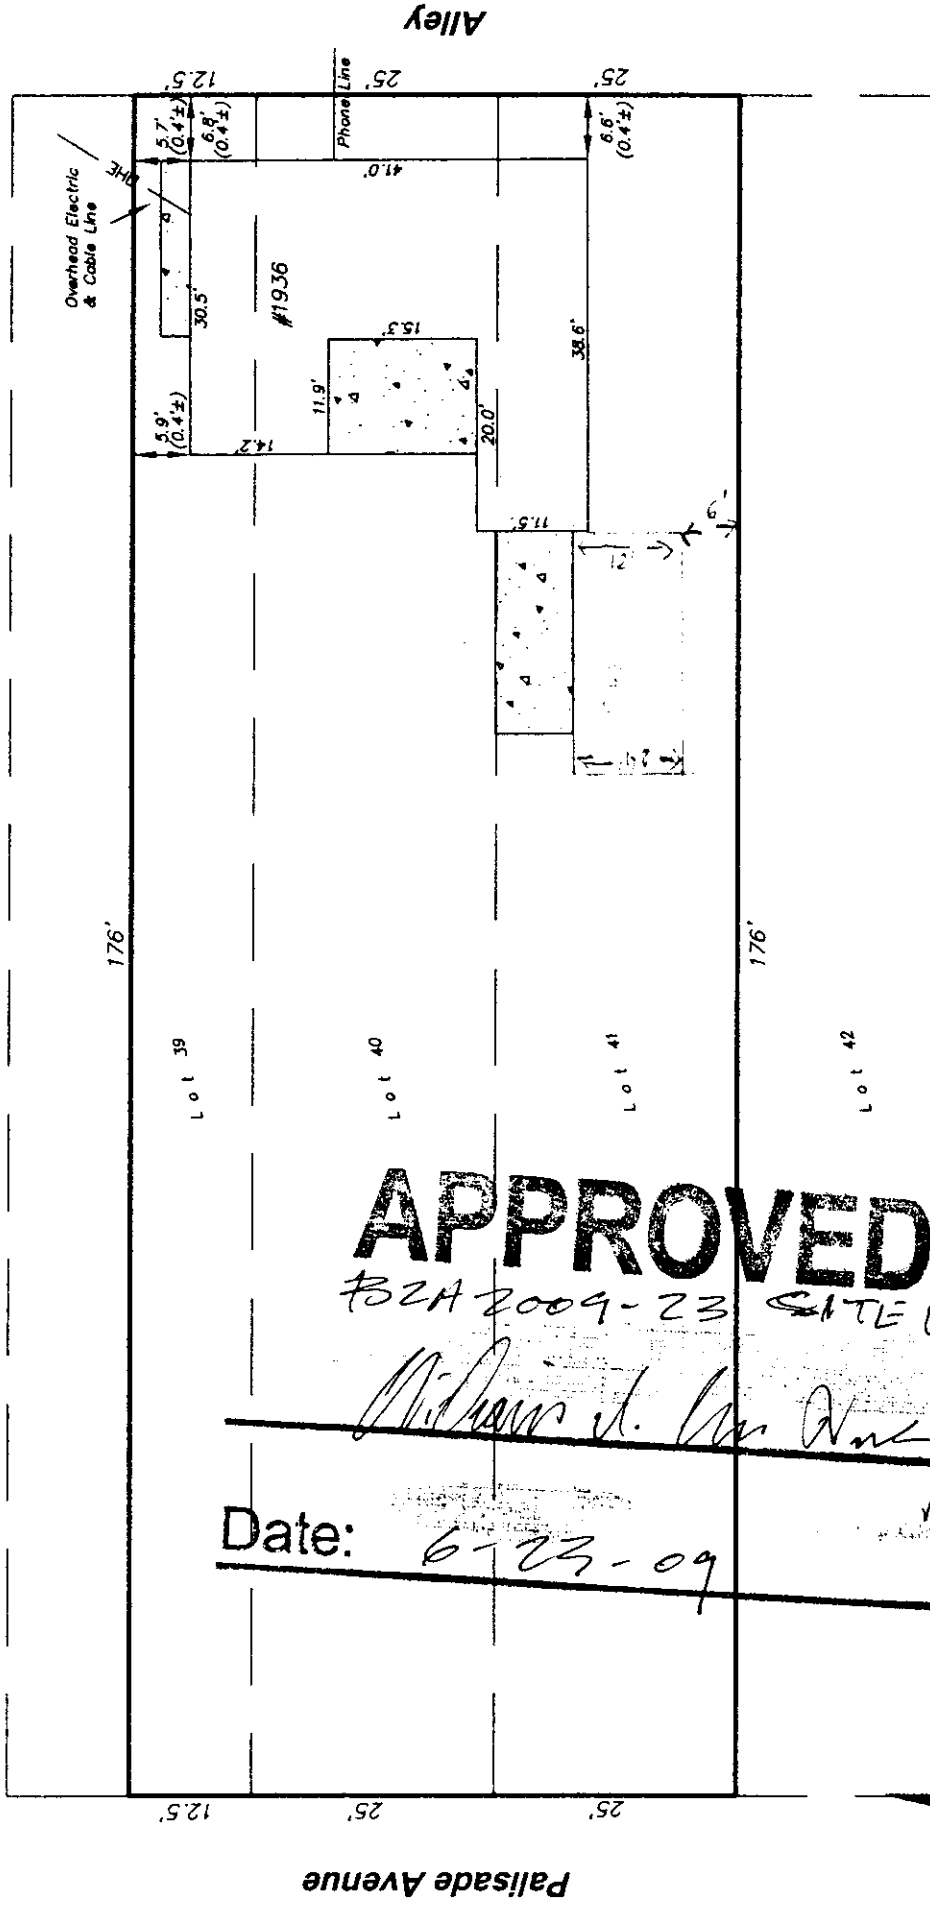

APPROVED

#2A 2009-23 SITE PLAN

Richard J. Van Wagoner

Date: 6-23-09



0 10 20

Dwn. By: AMB

NOTES:

- 1) Unplatted Easements of Record if any, are not shown hereon