



Wichita-Sedgwick County Metropolitan Area Planning Department

January 12, 2015

William Johnson
Evans Building Company
P.O. Box 12086
Wichita, KS 67277

Re: BZA2014-80: City zoning administrative adjustment to reduce the parking requirement from 20 to 15 spaces, in LI Limited Industrial zoning, generally located on the south side of W. Kellogg Drive east of S. Recca Lane (8205 W. Kellogg Dr.)

Legal Description: EAST ONE-HALF LOT 1 GRAHAM-CASADO ADDITION, Wichita, Sedgwick County, Kansas

Dear Applicants,

We reviewed your Zoning Adjustment request to reduce the parking requirement on the above-referenced property. From reviewing your application we understand that you are requesting to reduce the on-site parking requirement from 20 to 15 spaces, a 25% reduction of the Unified Zoning Code (UZY) requirement.

Sec. V-1.2.i of the Unified Zoning Code allows an adjustment to reduce the parking requirement for general retail large item by up to 25% when the conditions required by Sec. V-1.6 of the Code are met. We find that the parking requirement reduction as proposed meets the four conditions required by Sec. V-1.6 of the Code as set out below:

- 1) **Impact on safety and convenience of vehicular and pedestrian circulation:** The proposed reduction in parking requirement should have no impact on the safety and convenience of vehicular and pedestrian circulation in the vicinity of the application area. Sufficient parking is available for the current need and does not interfere with public right-of-way.
- 2) **Impact on existing uses in surrounding areas:** The proposed reduction in parking should not impact existing uses in surrounding areas, as all parking for this project should be adequately provided on the site.
- 3) **Compatibility with existing or permitted uses on abutting sites:** Abutting sites are zoned LI and include warehouse/office, warehouse/distribution/storage and machinery manufacturing uses. Therefore a 25% parking reduction should not compromise existing or permitted uses

City Hall • 10th Floor • 455 North Main • Wichita, Kansas 67202-1688

T 316.268.4421 F 316.268.4390

www.wichita.gov

on abutting sites.


- 4) Effect on public health, safety or welfare: There will be no encroachment into public right of way or utility easements; the public's safety, health and welfare should not be impacted.

Our signatures below indicate that an administrative adjustment to reduce parking by 25%, from 20 to 15 spaces is hereby granted for the aforementioned property subject to the following conditions:

- 1) The site shall be developed in general conformance with the approved site plan. Permitting and parking improvements shall be obtained and completed within one year.
- 2) All parking on the site shall be paved and marked in accordance with City standards. Gravel and unpaved areas shall have barriers to prevent parking on unimproved surfaces.
- 3) If the use changes from general retail large item, the number of parking spaces must meet the current zoning code standard.
- 4) If the Zoning Administrator finds that there is a violation of any of the conditions of the Zoning Adjustment, the Zoning Administrator, in addition to enforcing the other remedies set forth in the Unified Zoning Code, may, with the concurrence of the Planning Director, declare that the Zoning Adjustment is null and void.

The "Development Application" sign should now be removed from the property.


John L. Schlegel, Director
Metropolitan Area Planning Department

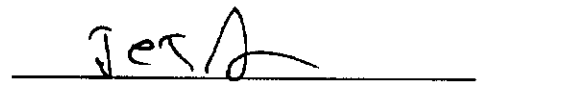
Thomas J. Stolz, Director
Metropolitan Area Building and Construction
Department


cc: JR Cox, MABCD
Jeff Blubaugh, CM District IV
Case Bell, Community Liaison District IV

SITE PLAN

APPROVED *[Signature]* BY *[Signature]*

copy 1 of 2

KELLOGG DRIVE

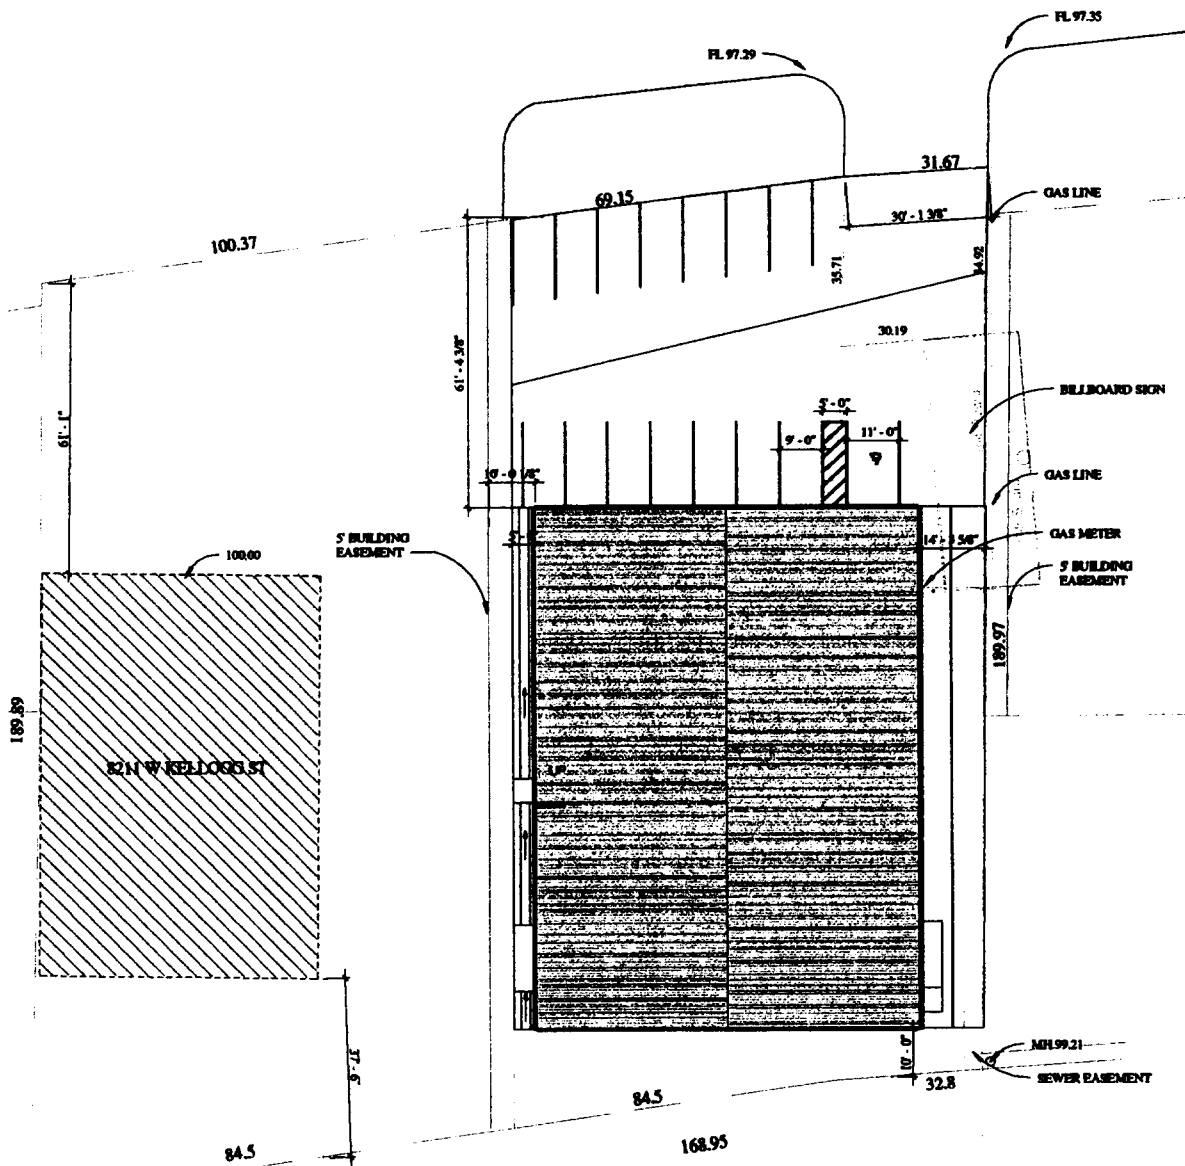


EVANS
EVANS BUILDING CO. INC.
9801 W. YORK
WICHITA, KANSAS 67277

**DREAM MACHINE
REMODEL**

8211 W KELLOGG DRIVE
WICHITA, KANSAS

PROPERTY
OF
EVANS BUILDING COMPANY, INC.
UNLAWFUL TO REPRODUCE
Wichita City License No. 26
Sedgewick Co. License No. 0006

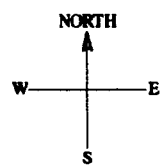

NO	DATE	TIME
1	12/11	11