


SCALE: 1" = 20'

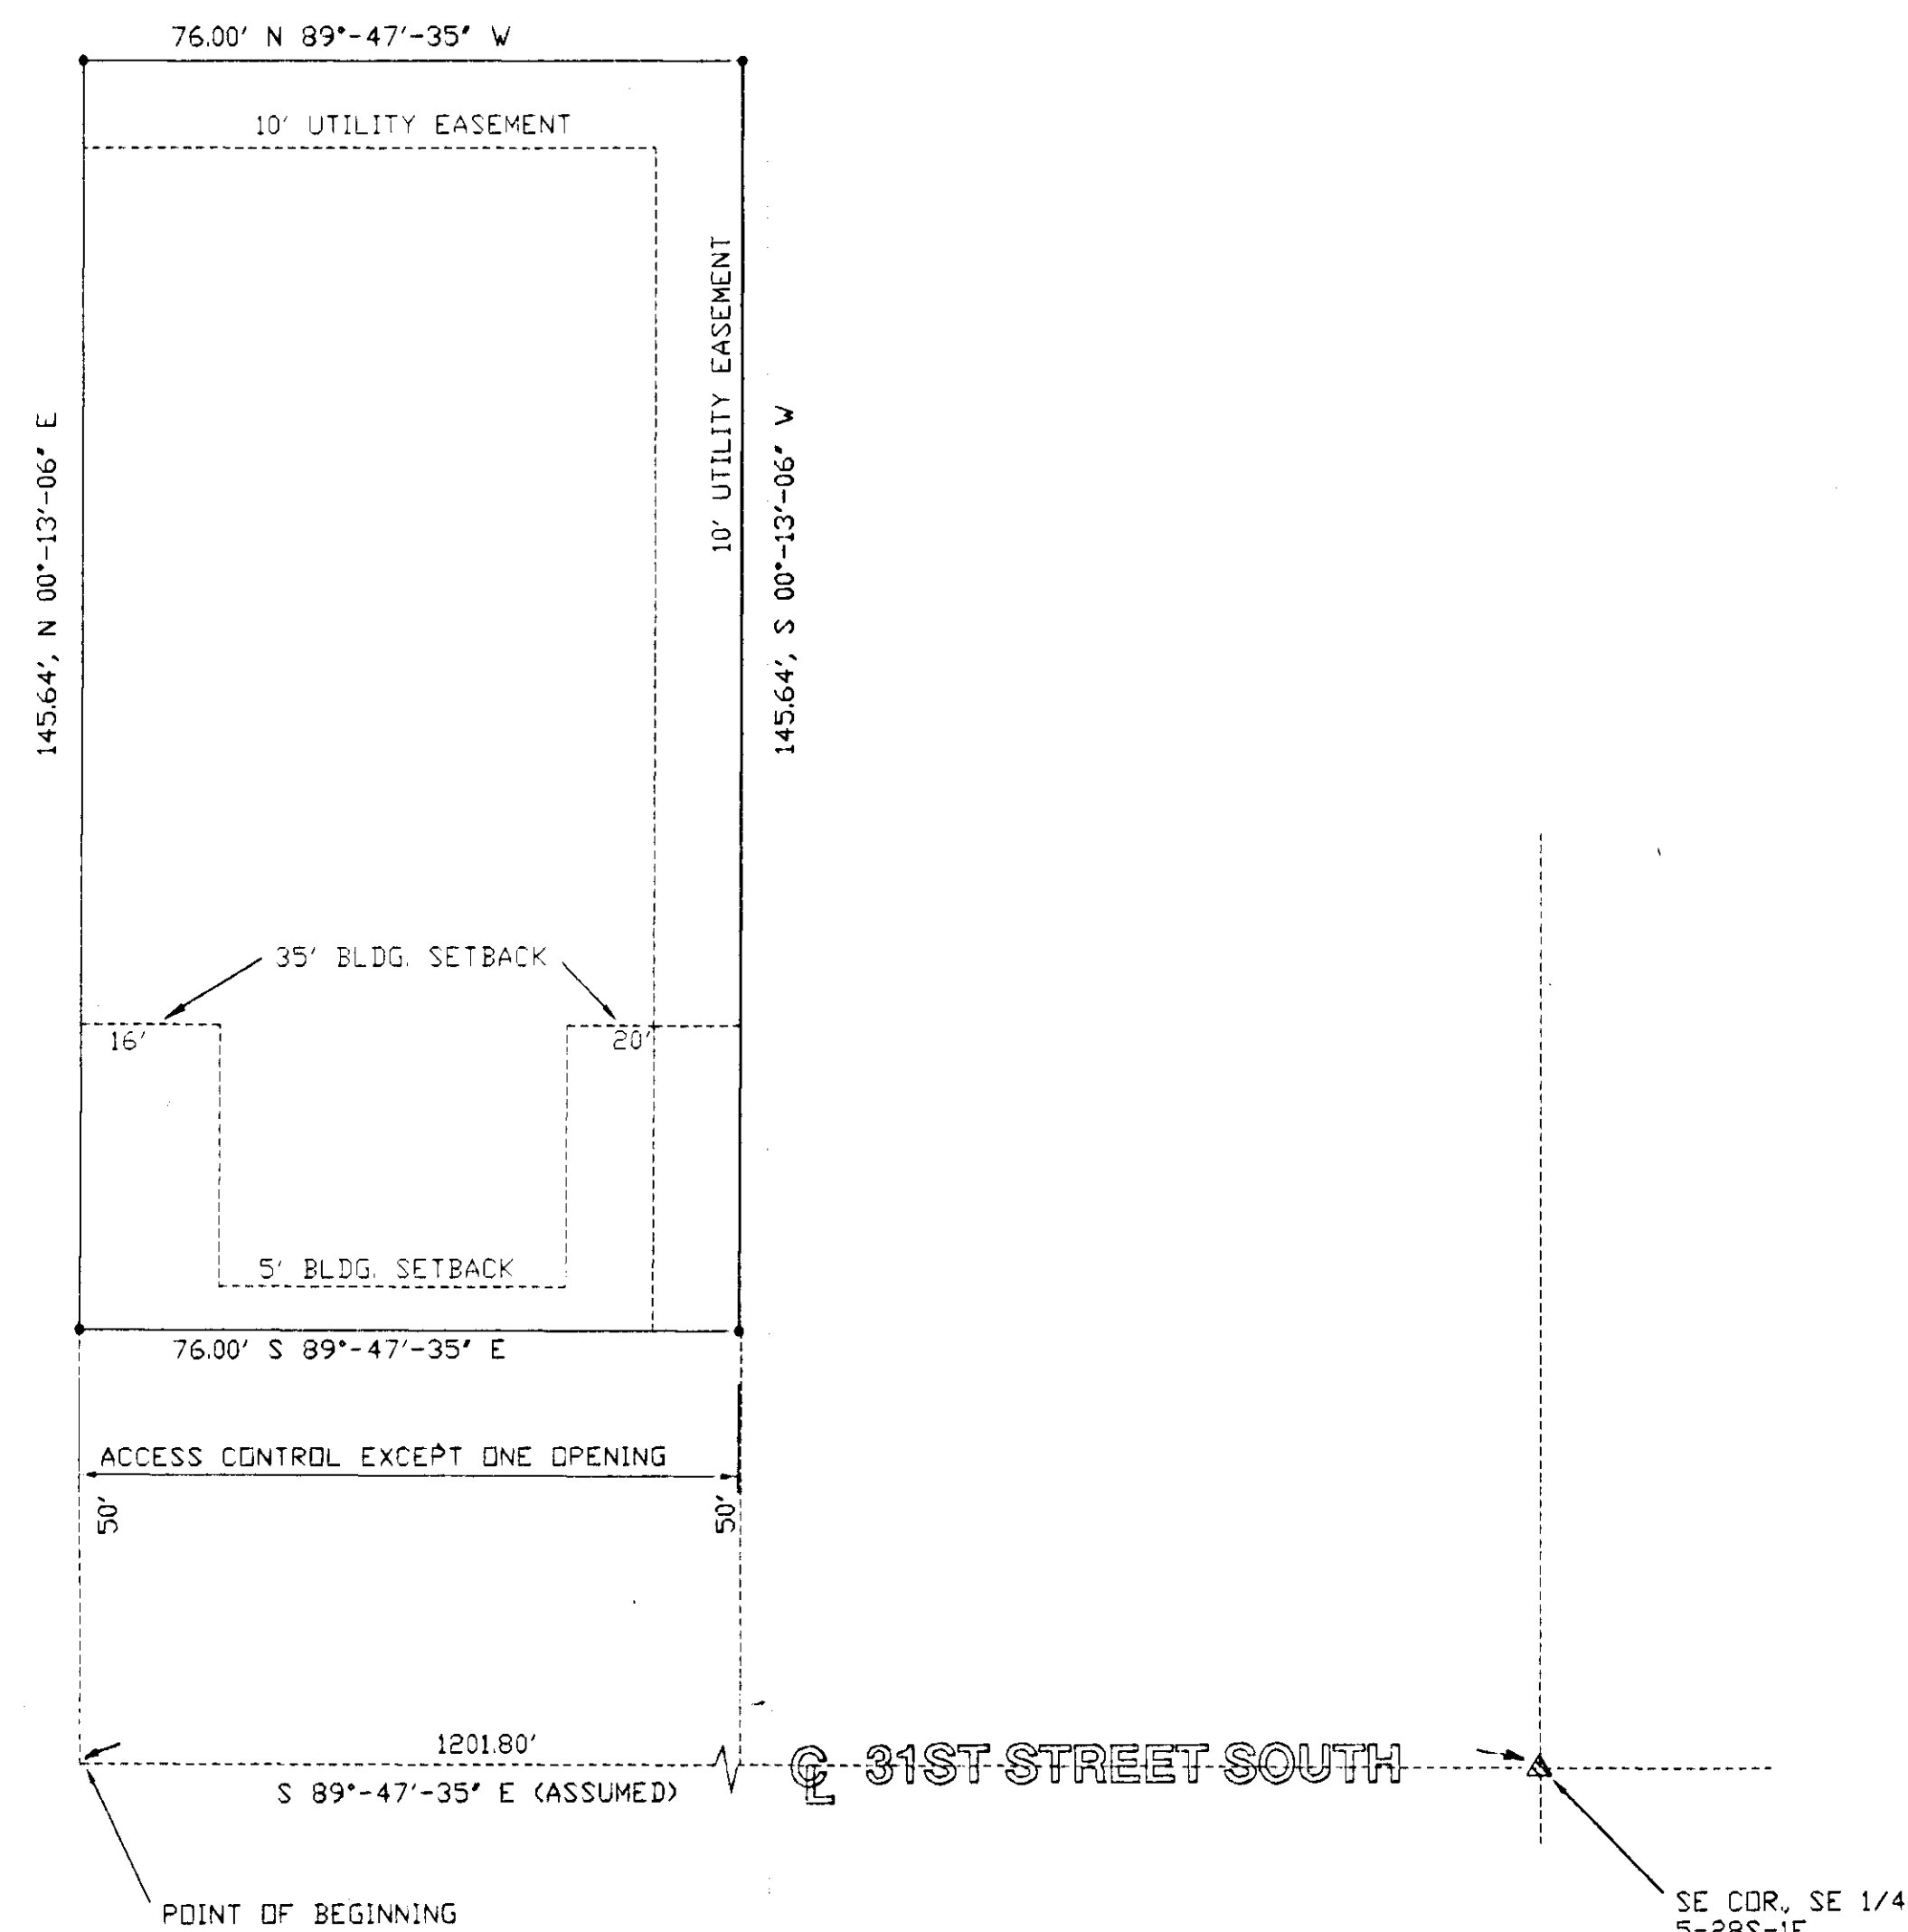

OFFICE COPY  
DO NOT REMOVE

FINAL PLAT

# FINAL PLAT OF GANN FIRST ADDITION TO WICHITA, SEDGWICK COUNTY, KANSAS

THIS PLAT APPROVED BY THE SUBDIVISION  
COMMITTEE ON 1/19/95 SUBJECT  
TO THE CONDITIONS OF APPROVAL OUTLIN-  
ED IN OUR LETTER DATED 1-19-95

- 35' BSB all the way, nothing is expansion, removal, etc
- Note that of AC in Platter's text
- M&C Ch. 1 = John W. Miley Jr
- Prop Jxs for Platter's

STATE OF KANSAS >  
SEDGWICK COUNTY >


I, BABAR M. KHAN, A LICENSED LAND SURVEYOR IN AFORESAID COUNTY AND STATE, DO HEREBY CERTIFY THAT I HAVE SURVEYED AND PLATTED 'GANN FIRST ADDITION TO WICHITA, SEDGWICK COUNTY, KANSAS' AND THAT THE ACCOMPANYING PLAT IS A TRUE AND CORRECT EXHIBIT OF PROPERTY SURVEYED, DESCRIBED AS FOLLOWS:

A TRACT OF LAND IN THE SOUTHWEST QUARTER OF SECTION 5, TOWNSHIP 28 SOUTH, RANGE 1 EAST OF THE SIXTH PRINCIPAL MERIDIAN, SEDGWICK COUNTY, KANSAS, BEING MORE PARTICULARLY DESCRIBED AS FOLLOWS: COMMENCING AT THE SOUTHEAST CORNER OF SAID SOUTHEAST QUARTER; THENCE WEST 1201.80 FEET TO POINT OF BEGINNING; THENCE NORTH 195.64 FEET; THENCE EAST 76 FEET; THENCE SOUTH 195.64 FEET; THENCE WEST 76 FEET TO THE POINT OF BEGINNING EXCEPT THE SOUTH 50 FEET FOR STREET.

ALL EASEMENTS, RIGHT-OF-WAYS, PREVIOUSLY GRANTED ARE HEREBY VACATED IN ACCORDANCE WITH K.S.A. 12-512(b), AS AMENDED.

THIS SURVEY WAS COMPLETED IN NOVEMBER, 1994.

BABAR M. KHAN, R.L.S. # 985

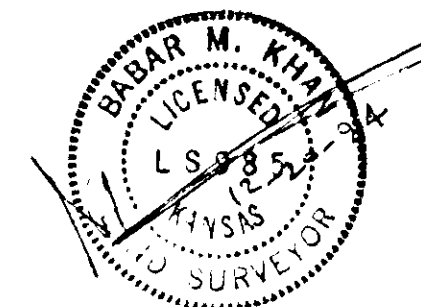

KNOW ALL MEN BY THESE PRESENTS, THAT WE, THE UNDERSIGNED PROPERTY OWNERS OF THE LAND AS ABOVE SET FORTH IN THE SURVEYOR'S CERTIFICATE, HAVE CAUSED THE LAND TO BE SURVEYED AND PLATTED INTO LOTS, BLOCKS, AND STREETS, THE SAME TO BE KNOWN AS 'GANN FIRST ADDITION TO WICHITA, SEDGWICK COUNTY, KANSAS'. EASEMENTS AS INDICATED FOR THE CONSTRUCTION AND MAINTENANCE OF PUBLIC UTILITIES ARE HEREBY GRANTED. THE STREETS ARE HEREBY DEDICATED TO AND FOR THE USE OF THE PUBLIC.

GAYFORD LYNN GANN

STATE OF KANSAS >  
SEDGWICK COUNTY >

BE IT REMEMBERED THAT ON THIS \_\_\_\_\_ DAY OF \_\_\_\_\_, 1995, BEFORE ME, A NOTARY PUBLIC IN AND FOR SAID COUNTY AND STATE, CAME GAYFORD LYNN GANN, TO ME PERSONALLY KNOWN TO BE THE SAME PERSON WHO EXECUTED THAT FORGOING INSTRUMENT OF WRITING AND DULY ACKNOWLEDGED THE SAME AS HIS VOLUNTARY ACT AND DEED. IN THE TESTIMONY WHEREOF, I HAVE HEREUNTO SET MY HAND AND AFFIXED MY NOTARIAL SEAL ON THE DAY AND YEAR ABOVE WRITTEN.

MY COMMISSION EXPIRES: \_\_\_\_\_

\_\_\_\_\_, NOTARY PUBLIC

I, WILMA GREENWOOD, HOLDER OF A MORTGAGE ON THE ABOVE DESCRIBED PROPERTY, DO HEREBY CONSENT TO THE PLAT OF 'GANN FIRST ADDITION TO WICHITA, SEDGWICK COUNTY, KANSAS'.

WILMA GREENWOOD

STATE OF KANSAS >  
SEDGWICK COUNTY >

BE IT REMEMBERED THAT ON THIS \_\_\_\_\_ DAY OF \_\_\_\_\_, 1995, BEFORE ME, A NOTARY PUBLIC IN AND FOR SAID COUNTY AND STATE, CAME WILMA GREENWOOD, TO ME PERSONALLY KNOWN TO BE THE SAME PERSON WHO EXECUTED THAT FORGOING INSTRUMENT OF WRITING AND DULY ACKNOWLEDGED THE SAME AS HIS VOLUNTARY ACT AND DEED. IN THE TESTIMONY WHEREOF, I HAVE HEREUNTO SET MY HAND AND AFFIXED MY NOTARIAL SEAL ON THE DAY AND YEAR ABOVE WRITTEN.

MY COMMISSION EXPIRES: \_\_\_\_\_

\_\_\_\_\_, NOTARY PUBLIC

THIS PLAT OF GANN FIRST ADDITION HAS BEEN SUBMITTED TO AND APPROVED BY THE WICHITA, SEDGWICK COUNTY METROPOLITAN AREA PLANNING COMMISSION, WICHITA, KANSAS.

DATED \_\_\_\_\_ DAY OF \_\_\_\_\_, 1995.

JAMES D. MINER \_\_\_\_\_ CHAIRMAN  
MARVIN KRODT \_\_\_\_\_ SECRETARY

THIS PLAT APPROVED AND ALL DEDICATIONS SHOWN HEREON, IF ANY, ACCEPTED BY CITY COUNCIL OF CITY OF WICHITA, KANSAS, THIS, \_\_\_\_\_

DAY OF \_\_\_\_\_, 1995.

ELMA BROADFOOT \_\_\_\_\_ MAYOR  
PAT BORNETT \_\_\_\_\_ CITY CLERK

ENTERED ON TRANSFER RECORD THIS \_\_\_\_\_ DAYS OF \_\_\_\_\_, 1995.

SUSAN E. CROCKETT-SPORN \_\_\_\_\_ COUNTY CLERK

THIS IS TO CERTIFY THAT THIS INSTRUMENT WAS FILED FOR RECORD IN THE REGISTER OF DEEDS OFFICE AT \_\_\_\_\_ ON THIS \_\_\_\_\_ DAY OF \_\_\_\_\_, 1995.

PAT KETTLER \_\_\_\_\_ REGISTER OF DEEDS  
ED RESA \_\_\_\_\_ DEPUTY



METROPOLITAN AREA PLANNING  
DEPARTMENT

CITY HALL — TENTH FLOOR  
455 NORTH MAIN STREET  
WICHITA, KANSAS 67202-1688  
(316) 268-4421  
FAX (316) 268-4390

January 27, 1995

Municipal Engineers, Inc.  
c/o Babar M. Khan, L.S.  
254 Laura - Suite 201  
Wichita, KS 67211

Re: S/D 94-88 GANN FIRST ADDITION - (Final Plat)

Dear Mr. Khan:

At the regular meeting of the Metropolitan Area Planning Commission on January 26, 1995, the above captioned plat was considered. The action of the Planning Commission was to recommend that the plat be approved as recommended by the Subdivision Committee subject to the conditions stated in our letter of January 19, 1995.

In addition to complying with those conditions, it is necessary that you meet the following requirements before this plat can be forwarded to the City Council for consideration:

1. Submission of the fully completed and signed tracing of the subdivision to the Metropolitan Area Planning Department.
2. Submission of a check, made out to the Register of Deeds, covering the costs of any documents to be recorded as a requirement of platting.
3. Subdivision regulations now require a detailed Lot Grading Plan be submitted to Engineering prior to the tracing being released. This applies to all multi-lot and residential developments.

Please call if you have any questions.

Sincerely,

Don Losew  
Senior Planner

DL:rh

cc: Gayford Lynn Gann, 130 1/2 West 31st Street South, Wichita, KS 67217  
Mike Lindebak, City Engineer

FILE COPY



January 19, 1995

METROPOLITAN AREA PLANNING  
DEPARTMENT

CITY HALL — TENTH FLOOR  
455 NORTH MAIN STREET  
WICHITA, KANSAS 67202-1688  
(316) 268-4421  
FAX (316) 268-4390

Municipal Engineers, Inc.  
c/o Babar M. Khan, L.S.  
254 Laura - Suite 201  
Wichita, KS 67211

Re: S/D 94-88 GANN FIRST ADDITION (Final Plat)

Dear Mr. Khan:

At the regular meeting of the Subdivision Committee of the Metropolitan Area Planning Commission on Thursday, January 19, 1995, the above captioned plat was considered. The action of the Committee was to recommend that this plat be approved subject to:

- ☒ A. On the final plat tracing, the dedication of access control to 31st Street South shall also be noted in the plat's text.
- ☒ B. The final plat tracing shall indicate the 35-foot setback across the entirety of the site's frontage to 31st Street South. Central Inspection has advised that the platting of this building setback does not preclude the property owner from maintaining or remodeling that portion of the building within the setback area. The building cannot, however, be enlarged within the setback and, if the building is removed, any new building construction must observe the platted building setback.
- ☒ C. As indicated by the platting binder, property taxes are due on this site. This plat will not be released for recording until proof is provided that all applicable property taxes have been paid.
- ☒ D. On the final plat tracing, the MAPC signature block shall be amended to indicate John W. McKay, Jr., as chairman.
- ☒ E. The applicant shall install or guarantee the installation of all utilities and facilities which are applicable and described in Article 8 of the MAPC Subdivision Regulations.
- ☒ F. The applicant's engineer is advised that the Register of Deeds is requiring the name(s) of the notary public, who acknowledges the signatures on this plat, to be printed beneath the notary's signature.
- ☒ G. Perimeter closure computations shall be submitted with the final plat tracing Section 5-101(c).

*see the  
submitted  
show you*

- H. Recording of the plat within 30 days after approval by the City Council.
- I. As indicated by City Engineering, a drainage plan still needs to be approved for this site before the plat is scheduled for City Council review.

If this plat requires the guaranteeing of improvements a list of the five methods which have been adopted as being acceptable is available through the Planning Department. Also, certificates which are required if petitions are submitted and forms for the bond and irrevocable Letter of Credit are also available from this office.

The enclosed "marked" copy of the final plat is for your information and files.

This matter will be forwarded to the Planning Commission for its consideration on Thursday, January 26, 1995 at 1:30 p.m. If you have any questions concerning this matter, please call.

Sincerely,



Don Losew  
Senior Planner

DL:rh

Enclosure: Marked Copy of plat

cc: Gayford Lynn Gann, 130 1/2 West 31st Street South, Wichita, KS 67217  
Mike Lindebak, City Engineer

METROPOLITAN AREA PLANNING COMMISSION

AGENDA ITEM NO. 2-2

January 26, 1995

**STAFF REPORT**  
(Final Plat Approved 1/19/95)

**CASE NUMBER:** S/D 94-88 GANN FIRST ADDITION

**OWNER/APPLICANT:** Gayford Lynn Gann, 130 1/2 West 31st Street South, Wichita, KS 67217

**SURVEYOR/ENGINEER:** Municipal Engineers, Inc., c/o Babar M. Khan, L.S., 254 Laura - Suite 201, Wichita, KS 67211

**LOCATION:** North of 31st Street South and west of Broadway

**SITE SIZE:** 0.25 Acres

**NUMBER OF LOTS**

|              |          |
|--------------|----------|
| Residential: |          |
| Office:      |          |
| Commercial:  | 1        |
| Industrial:  |          |
| Total:       | <u>1</u> |

**MINIMUM LOT AREA:** 10,000 sq. ft.

**CURRENT ZONING:** "AA" and "B"

**PROPOSED ZONING:** "LC" (Z-3137)

**VICINITY MAP:**



STAFF COMMENTS:

- A. On the final plat tracing, the dedication of access control to 31st Street South shall also be noted in the plat's text.
- B. The final plat tracing shall indicate the 35-foot setback across the entirety of the site's frontage to 31st Street South. Central Inspection has advised that the platting of this building setback does not preclude the property owner from maintaining or remodeling that portion of the building within the setback area. The building cannot, however, be enlarged within the setback and, if the building is removed, any new building construction must observe the platted building setback.
- C. As indicated by the platting binder, property taxes are due on this site. This plat will not be released for recording until proof is provided that all applicable property taxes have been paid.
- D. On the final plat tracing, the MAPC signature block shall be amended to indicate John W. McKay, Jr., as chairman.
- E. The applicant shall install or guarantee the installation of all utilities and facilities which are applicable and described in Article 8 of the MAPC Subdivision Regulations.
- F. The applicant's engineer is advised that the Register of Deeds is requiring the name(s) of the notary public, who acknowledges the signatures on this plat, to be printed beneath the notary's signature.
- G. Perimeter closure computations shall be submitted with the final plat tracing Section 5-101(c).
- H. Recording of the plat within 30 days after approval by the City Council.
- I. As indicated by City Engineering, a drainage plan still needs to be approved for this site before the plat is scheduled for City Council review.