

Final Plat
SUBDIVISION REPORT

SUBDIVISION COMMITTEE
METROPOLITAN AREA
PLANNING COMMISSION

S/D No.: 87-11 Name: J.M. MURPHY ADDITION

Preliminary Approved:
Scheduled S/D Meeting: 2/12/87

DESCRIPTION

General Location: South side of 27th Street South, in an area east of Seneca.
Owner: James M. Murphy, 1635 Woodrow Ct., Wichita, KS 67203
Surveyor/Engineer: Baughman Company, P.A., 315 Ellis, Wichita, KS 67211

1. Gross Acreage of Plat: 0.55
 2. Number of Lots:
 - Residential:
 - Office: 1
 - Commercial:
 - Industrial:
 - Total: 1
 3. Minimum Lot Area: 24,067.7 Sq. Ft.
 4. Existing Zoning: "BB"
 5. Proposed Zoning: "BB"
-

STAFF COMMENTS:

- A. The applicant shall guarantee any drainage improvements required by the platting of this property.
- B. If improvements are guaranteed by petition, a notarized certificate listing the petitions shall be submitted to the Planning Department for recording.
- C. Since 27th Street South is not classified as an arterial street, the final plat tracing shall delete the platting of access control to this street. The face of the plat and the platlor's text shall be amended.
- D. The applicant's agent should be prepared to discuss with the Subdivision and Utility Advisory Committees the private sewer easement that exists on this property. It is assumed that this private easement covers a private sewer service line from the commercially zoned property to the west.
- E. The representative from the City Engineer's office should be prepared to address the need for this plat to grant an appropriately wide utility easement for extension of future public sewer lateral to directly serve the property to the west.
- F. On the final plat tracing, the City Commission signature block shall be amended to reference Dale E. Rea, Deputy City Clerk.
- G. The applicant's engineer is advised that the Register of Deeds is requiring the name(s) of the notary public, who acknowledges the signatures on this plat, to be printed beneath the notary's signature.
- H. The applicant shall install or guarantee the installation of all utilities and facilities which are applicable and described in Article 8 of the MAPC Subdivision Regulations.
- I. Perimeter closure computations shall be submitted with the final plat tracing. Section 5-101(C).
- J. Recording of the plat within 30 days after approval by the Board of City Commissioners.
- K. The representative from the City Engineer's office should be prepared to comment on the status of the applicant's drainage plan. Specifically, are any drainage guarantees required by this replat?

OFFICE COPY
DO NOT REMOVE

FINAL PLAT

J. M. MURPHY ADDITION

THIS PLAT APPROVED BY THE SUBDIVISION
COMMISSION ON 2/12/87 SUBJECT
TO THE COMMISSION'S RECOMMENDATION SET OUT IN
ED IN OUR LETTER DATED 2/13/87

State of Kansas } ss. We, Baughman Company, P.A. Surveyors
Sedgwick County } in aforesaid county and state do hereby certify that we have
surveyed and platted "J. M. MURPHY ADDITION" Wichita,
Kansas, and that the accompanying plat is a true and
correct exhibit of the property surveyed, described as
and being a replat of the east 113 feet of Lot 1, Heersche's
Replat, Wichita, Kansas. Being situated in the SW 1/4 of Sec.
5, Twp 28-S, R-1-E of the 6th P.M., Sedgwick County, Kansas.

Date _____ Baughman Company, P.A.

Mark A. Savoy Surveyor

Know all men by these presents
that we, the undersigned, have caused the land described
in the surveyors certificate to be platted into a lot to be
known as "J. M. MURPHY ADDITION" Wichita, Kansas. The
utility easements are hereby granted as indicated for the
construction and maintenance of all public utilities. All
abutter rights of access to or from 27TH. ST. SO. over and
across the north line of Lot 1 are hereby granted to the
City of Wichita, provided however that Lot 1 shall have
access to 27TH ST. SO. at one point as shall be deter-
mined by the City Engineer of Wichita, Kansas.

James M. Murphy

Marcia G. Murphy

State of Kansas } ss. The foregoing instrument acknowledged
Sedgwick County } before me this _____ day of _____ 198__ by
James M. Murphy and Marcia G. Murphy his wife.

My Appt. Exp. _____ Notary Public

We, the undersigned, holders of a mort-
gage on the above described property do hereby con-
sent to the plat of "J. M. MURPHY ADDITION" Wichita,
Kansas.


Twin Lakes State Bank

State of Kansas } ss. The foregoing instrument acknowledged
Sedgwick County } before me this _____ day of _____ 198__ by

State Bank on behalf of the Bank.

My Appt. Exp. _____ Notary Public

1" = 40'
o = iron
x = cross

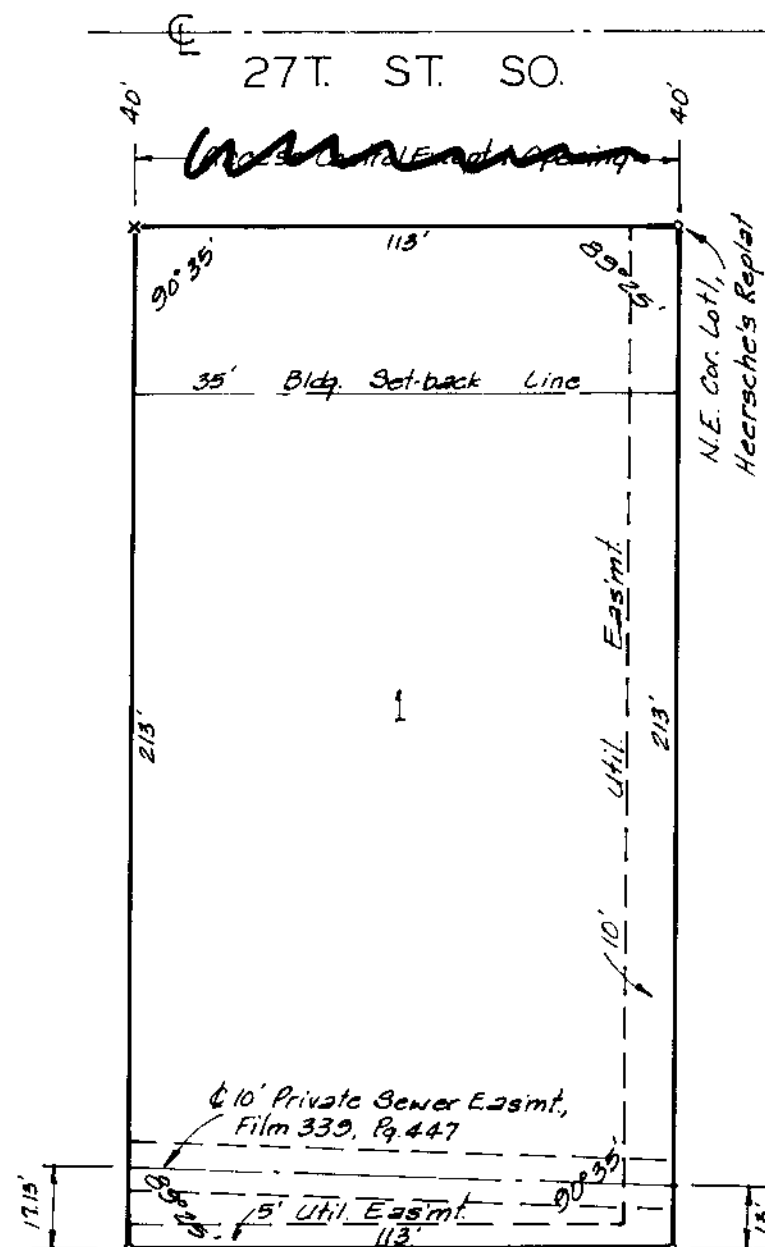

This plat of "J. M. MURPHY ADDITION"
Wichita, Kansas, has been submitted to and approved by
the Wichita-Sedgwick County Metropolitan Area Planning
Commission, Wichita, Kansas.

Dated this _____ day of _____ 198__
Wichita-Sedgwick County Metropolitan Area Planning Commission

John Terry Moore Chairman

Marvin S. Krout Secretary

This plat approved and all dedications
shown hereon accepted by the Board of Commissioners
of the City of Wichita, Kansas, this _____ day of _____
198__.

Tony Casado Mayor

DALE E. REA Deputy City Clerk

Entered on transfer record this
_____ day of _____ 198__.

Don Wright County Clerk

State of Kansas } ss. This is to certify that this plat has
Sedgwick County } been filed for record in the office of the Register of
Deeds this _____ day of _____ 198__, at
_____ o'clock _____ M.; and is duly recorded.

Pat Kettler Register of Deeds

Ed Resa Deputy

February 19, 1987

Baughman Company, P.A.
315 Ellis
Wichita, KS 67211

Re: Final Plat S/D 87-11 - J.M. MURPHY ADDITION

Dear Gentlemen:

At the regular meeting of the Metropolitan Area Planning Commission on February 19, 1987, the above-captioned plat was considered. The action of the Planning Commission was to recommend that the plat be approved as recommended by the Subdivision Committee subject to the conditions stated in our letter of February 13, 1987.

In addition to complying with those conditions, it is necessary that you meet the following requirements before this plat can be forwarded to the Board of City Commissioners for consideration:

1. Submission of the fully completed and signed tracing of the subdivision to the Metropolitan Area Planning Department.
2. Submission of a title report by an abstract or title insurance company or an attorney's opinion that fee title is vested in the plattor.
3. Certification that all real estate taxes for 1986 and all prior years have been paid.

Please call if you have any questions.

Sincerely,

Forrest L. Nagley
Senior Planner

FLN:dlk

cc: James M. Murphy, 1635 Woodrow Ct., Wichita, KS 67203
Donald Diggs, 1905 E. 21st Street N., Wichita, KS 67214