

June 11, 1987

Baughman Company, P.A.
315 Ellis
Wichita, Kansas 67211

Re: Final Plat S/D 87-44 - SHERWOOD INDUSTRIAL PARK III

Gentlemen:

At the regular meeting of the Metropolitan Area Planning Commission on June 11, 1987, the above-captioned plat was considered. The action of the Planning Commission was to recommend that the plat be approved as recommended by the Subdivision Committee subject to the conditions stated in our letter of June 5, 1987.

In addition to complying with those conditions, it is necessary that you meet the following requirements before this plat can be forwarded to the City Council for consideration:

1. Submission of the fully completed and signed tracing of the subdivision to the Metropolitan Area Planning Department.
2. Submission of a title report by an abstract or title insurance company or an attorney's opinion that fee title is vested in the platlor.
3. Certification that all real estate taxes for 1987 and all prior years have been paid.

Please call if you have any questions.

Sincerely,

Donald Losew
Junior Planner

DL:bb

cc: Sherwood Construction Co., Inc.
4421 West Harry
Wichita, Kansas 67209


OFFICE COPY
DO NOT REMOVE

THIS PLAT APPROVED BY THE SUBDIVISION
COMMITTEE ON 6/4/87 SUBJECT
TO THE CONDITIONS OF APPROVAL OUTLIN
ED IN OUR LETTER DATED 6/5/87

SHERWOOD INDUSTRIAL PARK III

WICHITA, KANSAS

FINAL PLAT

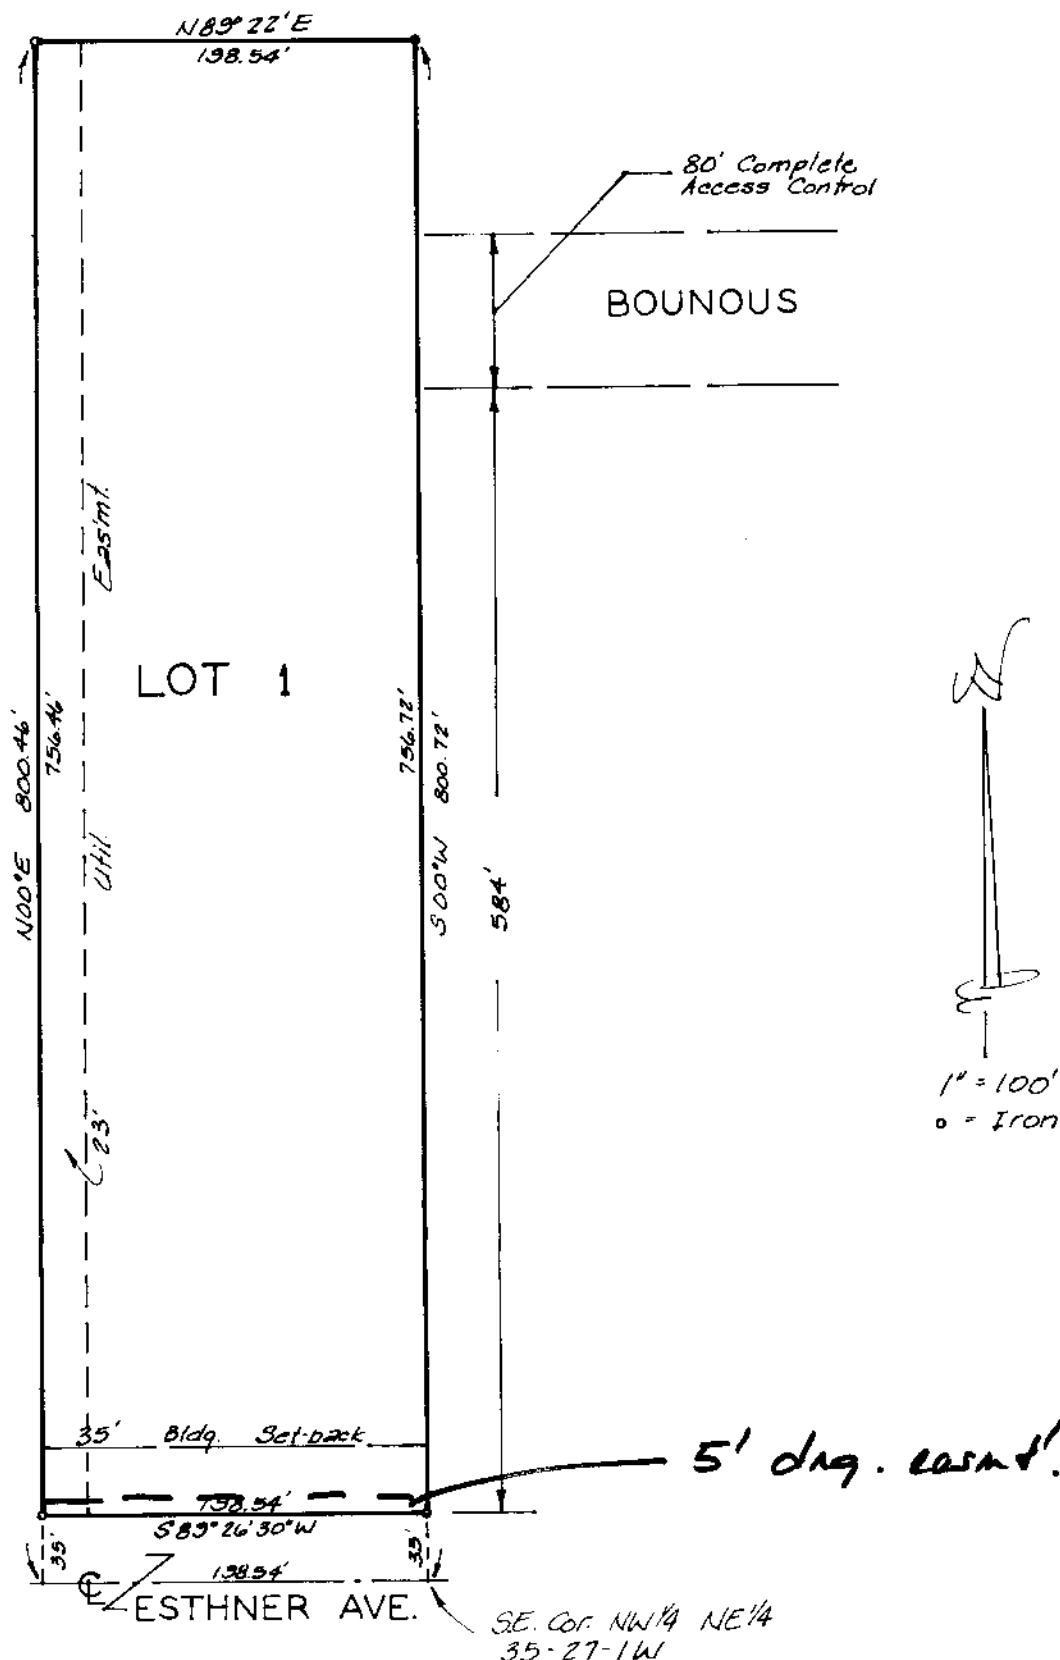

State of Kansas } S.S. We, Baughman Company, P.A., Surveyors
Sedgwick County } in aforesaid county and state do hereby certify that we have
surveyed and platted "SHERWOOD INDUSTRIAL PARK III,"
Wichita, Kansas, and that the accompanying plat is a true
and correct exhibit of the property surveyed, described as
the east 198.54 feet of the NW 1/4 of the NE 1/4 of Sec. 35,
Twp. 27-S, R-1-W of the 6th P.M., Sedgwick County, Kansas,
except the north 516.03 feet thereof.

Date

Baughman Company, P.A.

Mark A. Savoy Surveyor

Know all men by these presents that we,
the undersigned, have caused the land described in the
surveyors certificate to be platted into a lot and street to
be known as "SHERWOOD INDUSTRIAL PARK III," Wichita,
Kansas. The utility easement is hereby granted as indicated
for the construction and maintenance of all public utilities.
The street is hereby dedicated to and for the use of the
public. All abutters rights of access to or from Bounous over
and across the east line of Lot 1 are hereby granted to
the City of Wichita, Kansas.

Sherwood Construction Co., Inc.

Howard Sherwood President

State of Kansas } S.S. The foregoing instrument acknowledged
Sedgwick County } before me this _____ day of _____ 198____, by
Howard Sherwood, President of Sherwood Construction Co.,
Inc., on behalf of the corporation

Notary Public

My Appt. Exp. _____

Entered on transfer record this _____
day of _____ 198____

Don Wright County Clerk

State of Kansas } S.S. This is to certify that this plat has been
Sedgwick County } filed for record in the office of the Register of Deeds
this _____ day of _____ 198____, at _____ o'clock
_____ M., and is duly recorded.

Pat Kettler Register of Deeds

Ed Resa Deputy

This plat of "SHERWOOD INDUSTRIAL
PARK III," Wichita, Kansas, has been submitted to and ap-
proved by the Wichita-Sedgwick County Metropolitan Area
Planning Commission, Wichita, Kansas.

Dated this _____ day of _____ 198____
Wichita-Sedgwick County Metropolitan Area Planning Commission

John Terry Moore Chairman

Marvin S. Kroust Secretary

This plat approved and all dedications
shown hereon accepted by the City Council of the City of
Wichita, Kansas, this _____ day of _____ 198____

Robert G. Knight Mayor

Dele E. Resa Deputy City Clerk

Final Plat
SUBDIVISION REPORT

SUBDIVISION COMMITTEE
METROPOLITAN AREA
PLANNING COMMISSION

S/D No.: 87-44 Name: SHERWOOD INDUSTRIAL PARK III

Preliminary Approved:
Scheduled S/D Meeting: 6/4/87

DESCRIPTION

General Location: West of West Street, in an area north of Esthner.
Owner: Sherwood Construction Co., Inc., 4421 W. Harry, Wichita, KS 67209
Surveyor/Engineer: Baughman Company, P.A., 315 Ellis, Wichita, KS 67211

1. Gross Acreage of Plat: 3.6
 2. Number of Lots:
 - Residential:
 - Office:
 - Commercial:
 - Industrial: 1
 - Total: 1
 3. Minimum Lot Area: 151,990.9 Sq. Ft.
 4. Existing Zoning: "E"
 5. Proposed Zoning: "E"
-

STAFF COMMENTS:

- A. The applicant shall guarantee any drainage improvements required by the platting of this property.
- B. If improvements are guaranteed by petition, a notarized certificate listing the petitions shall be submitted to the Planning Department for recording.
- C. Due to the location of existing buildings on this unplatted tract, it is not possible to obtain the dedication of a turnaround for adjacent Bounous Street. The final plat minimizes this problem by correctly indicating "complete access control" to this dead end street.
- D. The applicant's engineer is advised that the Register of Deeds is requiring the name(s) of the notary public, who acknowledges the signatures on this plat, to be printed beneath the notary's signature.
- E. The applicant shall install or guarantee the installation of all utilities and facilities which are applicable and described in Article 8 of the MAPC Subdivision Regulations.
- F. Perimeter closure computations shall be submitted with the final plat tracing. Section 5-101(C).
- G. Recording of the plat within 30 days after approval by the City Council.
- H. The representative from the City Engineer's office should be prepared to comment on the status of the applicant's drainage plan. Specifically, are any drainage improvements required to be guaranteed with this plat?
- I. The representative from City Engineering should be prepared to state if the platting of a utility easement is needed adjacent to the south line of the lot.

NOTE: This plat has been submitted in final form only.