

is compatible with existing and permitted uses on abutting sites, and the encroachment into the rear setback should not reduce compatibility with abutting and adjacent sites.


- 4) Effect on public health, safety or welfare: There will be no encroachment into public utility easements or right-of-way; therefore, there should not be a negative impact on the public health, safety or welfare nor will properties or improvements in the vicinity be materially injured.

Our signatures below indicate that a Zoning Adjustment to reduce the rear setback for the aforementioned property from 20-feet to 17.7 feet is hereby granted, subject to the following conditions:

- 1) The site shall be developed in general conformance with the approved site plan.
- 2) The setback reduction shall apply only to the "Area of Setback Encroachment" as illustrated on the approved site plan. All other structures or additions on the subject property shall conform to the setbacks permitted by the Unified Zoning Code unless a separate Zoning Adjustment or Variance is granted.
- 3) If the Zoning Administrator finds that there is a violation of any of the conditions of the Zoning Adjustment, the Zoning Administrator, in addition to enforcing the other remedies set forth in the Unified Zoning Code, may, with the concurrence of the Planning Director, declare that the Zoning Adjustment is null and void.

The "Development Application" sign should now be removed from the property.

  
\_\_\_\_\_  
John L. Schlegel  
Planning Director

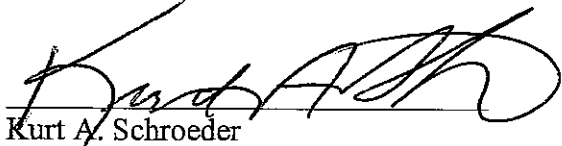  
\_\_\_\_\_  
Kurt A. Schroeder  
Superintendent of Central Inspection

Enclosure

cc: Kurt Schroeder, Office of Central Inspection  
Paul Hays, Office of Central Inspection  
Herb Shaner, Office of Central Inspection



**FILE COPY**

**Wichita-Sedgwick County Metropolitan Area Planning Department**

December 15, 2005

Gregory Dorton  
3914 Brummett CR  
Wichita, KS 67215

Re: **BZA2005-00078**: Zoning Adjustment to reduce the rear setback from 20 feet to 17.7 feet.

**Legal Description**: Lot 22, Block 2, Gray's 2<sup>nd</sup> Addition, Wichita, Sedgwick County, Kansas. Generally located north of Macarthur and Brummett (3914 Brummett Circle).


Dear Mr. Gregory,

We have reviewed your request for a Zoning Adjustment to reduce the rear setback on the aforementioned property: From reviewing the application, we understand that you desire to construct an addition to an existing single-family residence with a 17.7-foot rear setback. The 17.7-foot rear setback is a 2.3-foot encroachment into the required 20-foot rear setback for the "SF-5" Single-Family zoning district; therefore, you have requested an adjustment to reduce the required rear setback.

Section V-I.2.a. of the Unified Zoning Code allows up to a 20% reduction of the rear setback for a principle structure when the provisions of that section and the Zoning Adjustment Criteria of Section V-I.6. are met. We find that the reduction of the rear setback as proposed meets the provisions of Section V-I.2.a. and the four criteria required by Section V-1.6. as set out below:

- 1) Impact on safety and convenience of vehicular and pedestrian circulation: The setback encroachment should have no impact on the safety and convenience of vehicular and pedestrian circulation in the vicinity because the rear yard provides no vehicular access or pedestrian access.
- 2) Impact on existing uses in surrounding areas: There should be no negative impact on the existing uses in surrounding areas as a result of the reduction of the rear setback, as sufficient separation between buildings is maintained and the rear setback reduction is within allowable limits.
- 3) Compatibility with existing or permitted uses on abutting sites: The single-family residence

BRUMMETT  
CIRCLE

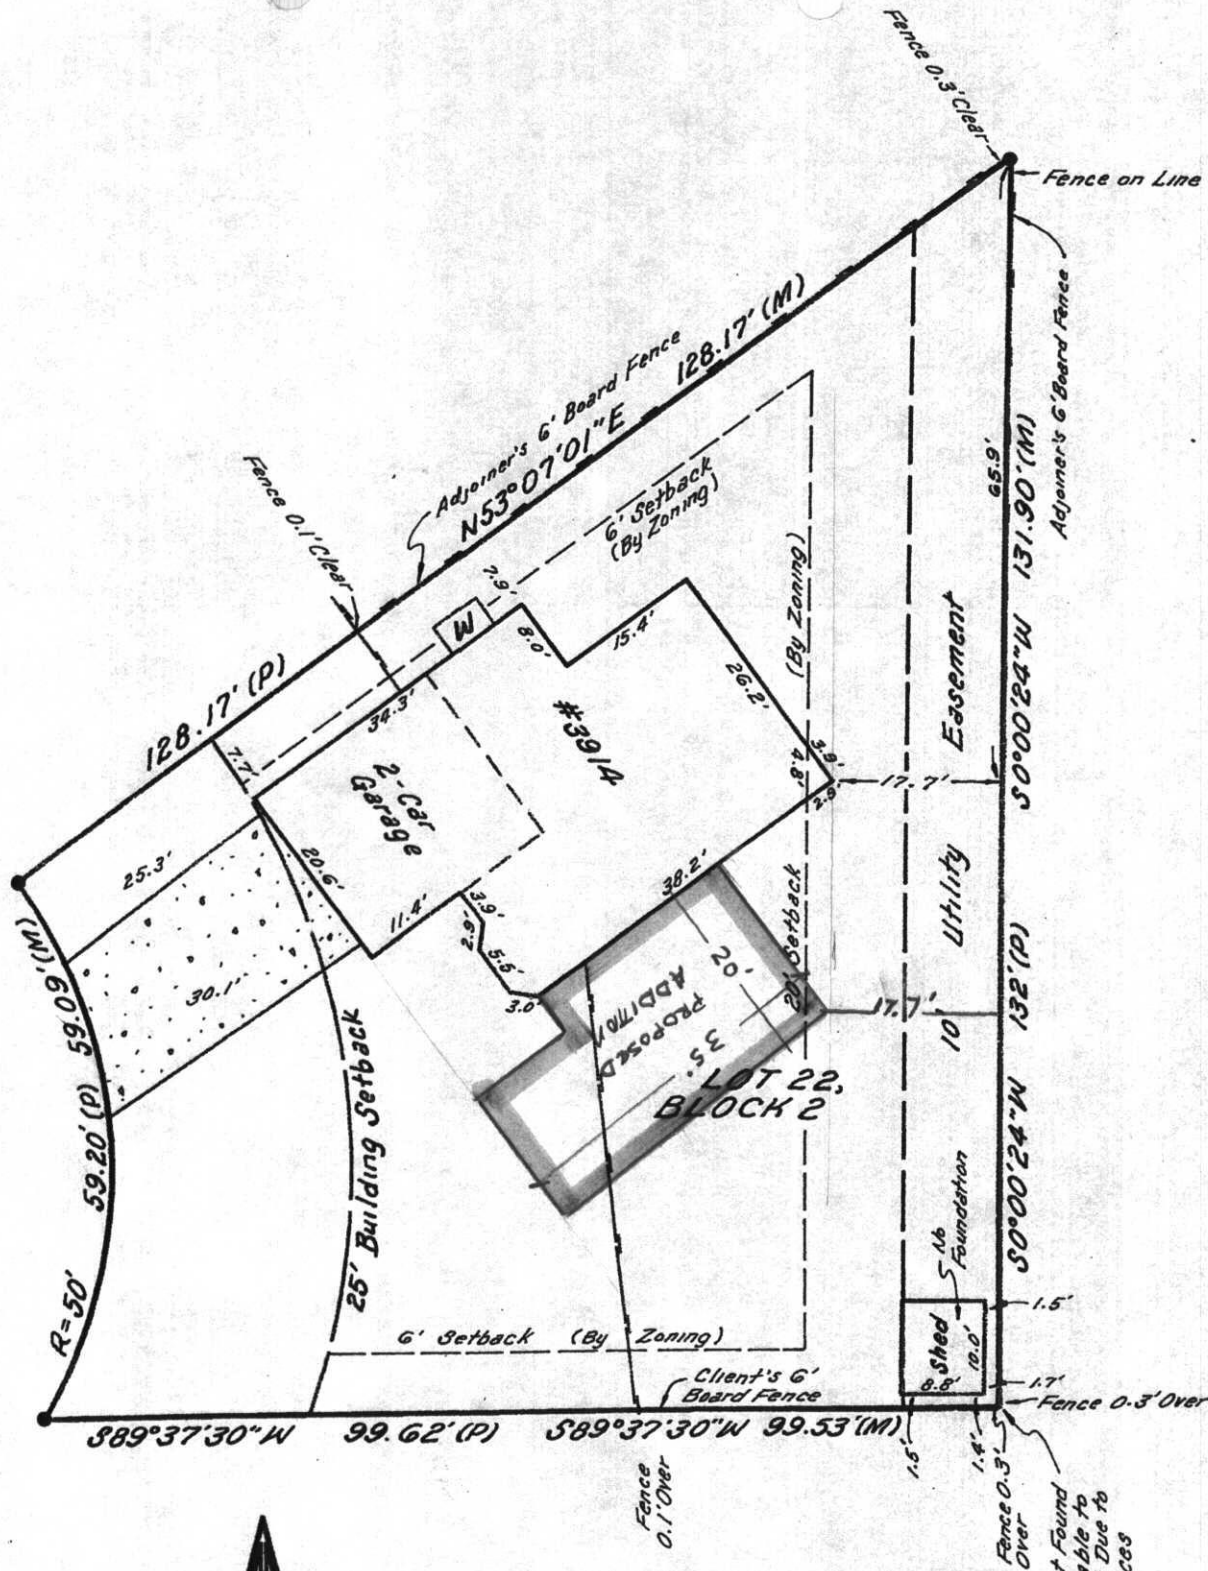

Scale: 1" = 20'  
 ● = 3/4" Iron Pipe Found  
 (P) = Platted  
 (M) = Measured  
 Bearing Basis Assumed  
 File # 2005085  
 November 5, 2005  
 W = Window Well Exit

Not Found  
 Lineable to  
 Set Due to  
 Fences