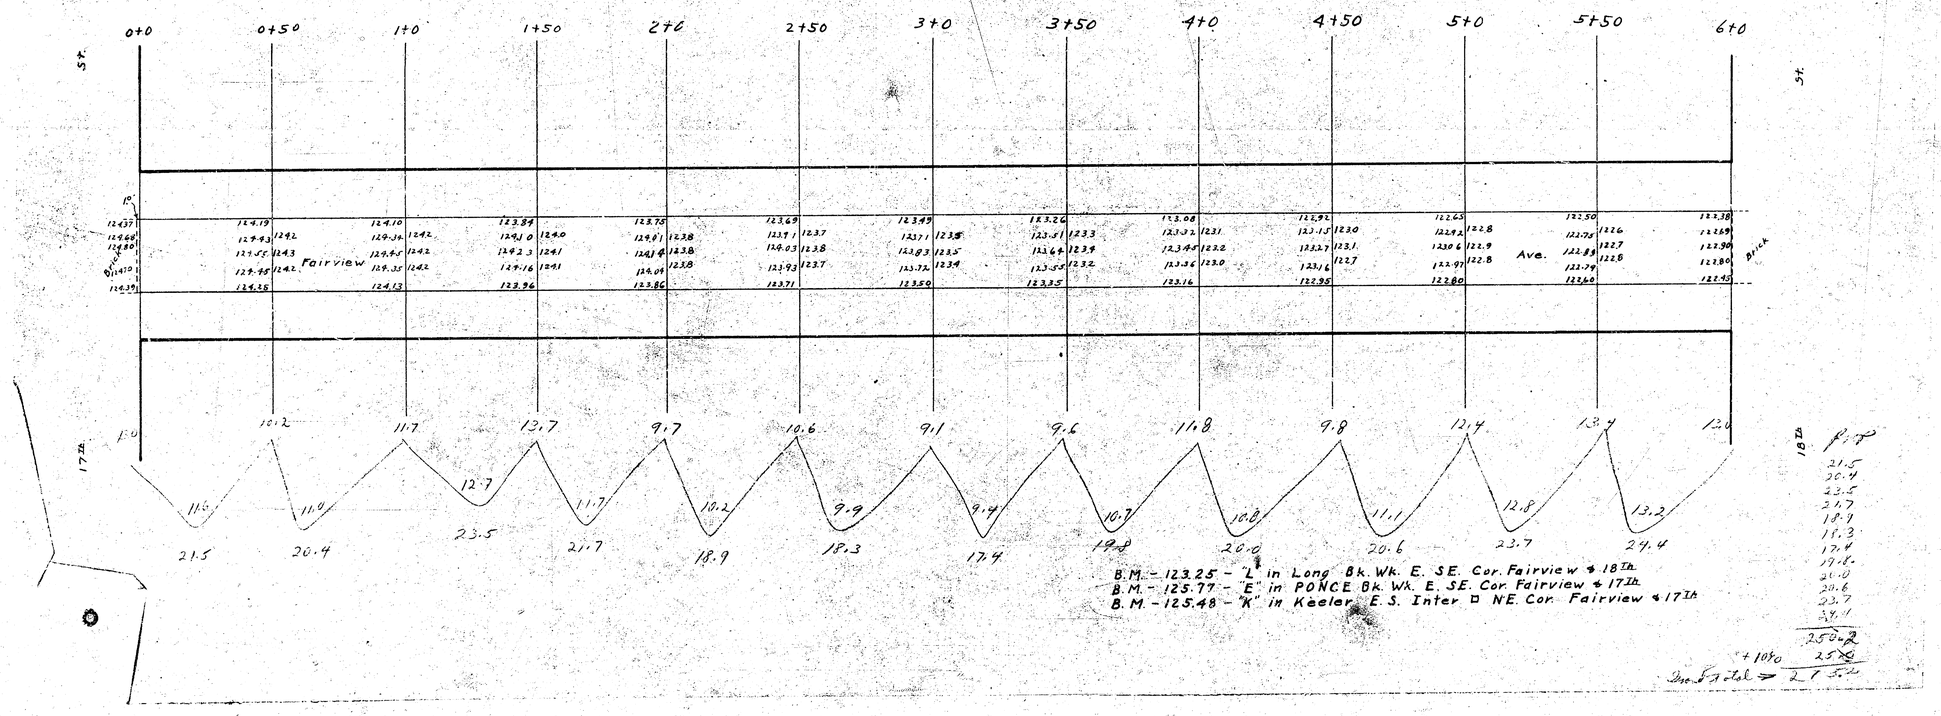1942
Fairview Ave. – N.L. 17th St. to S.L. 18th St.
26' Concrete