


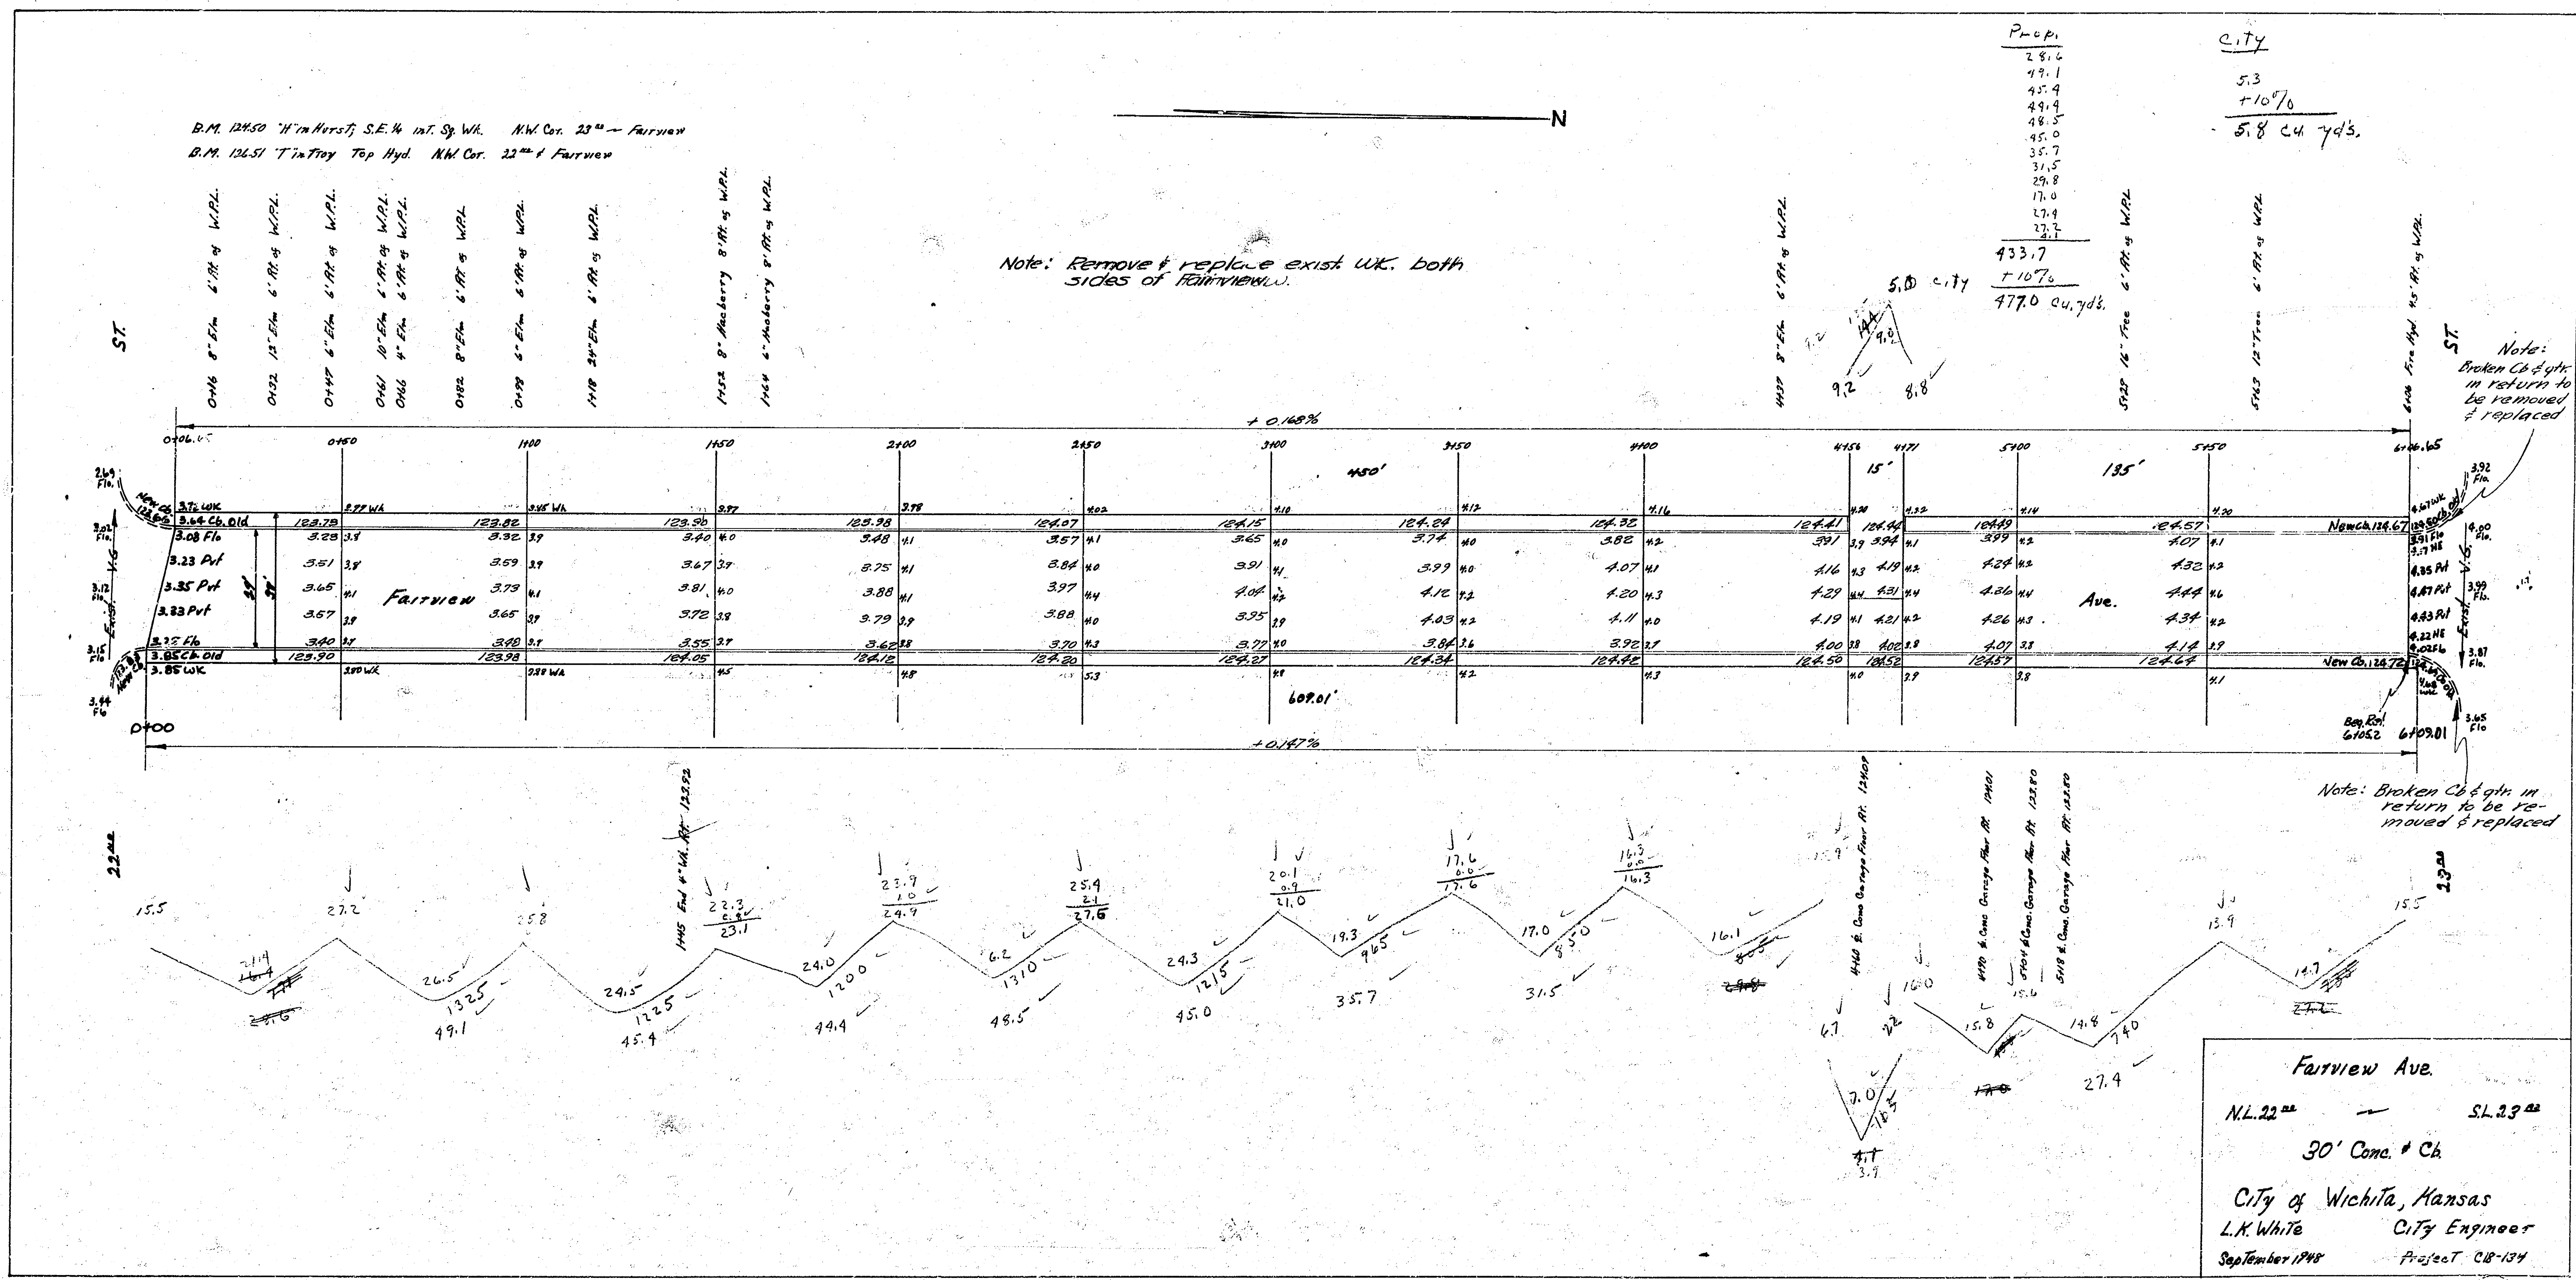

Fairview Ave.
 N.L. 22nd — SL 23rd
 30' Conc. # Ch
 City of Wichita, Kansas
 L.K. White City Engineer
 September 1948 Project CB-134