
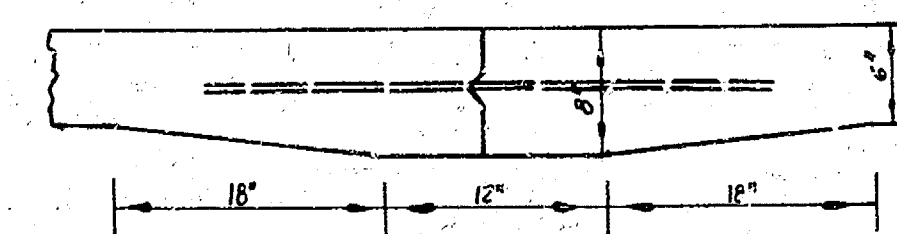


RM. 195.22 S.E. COR. CONC. STEP HOL. 80' SO. WOODLAWN

SCALE 1" = 20'

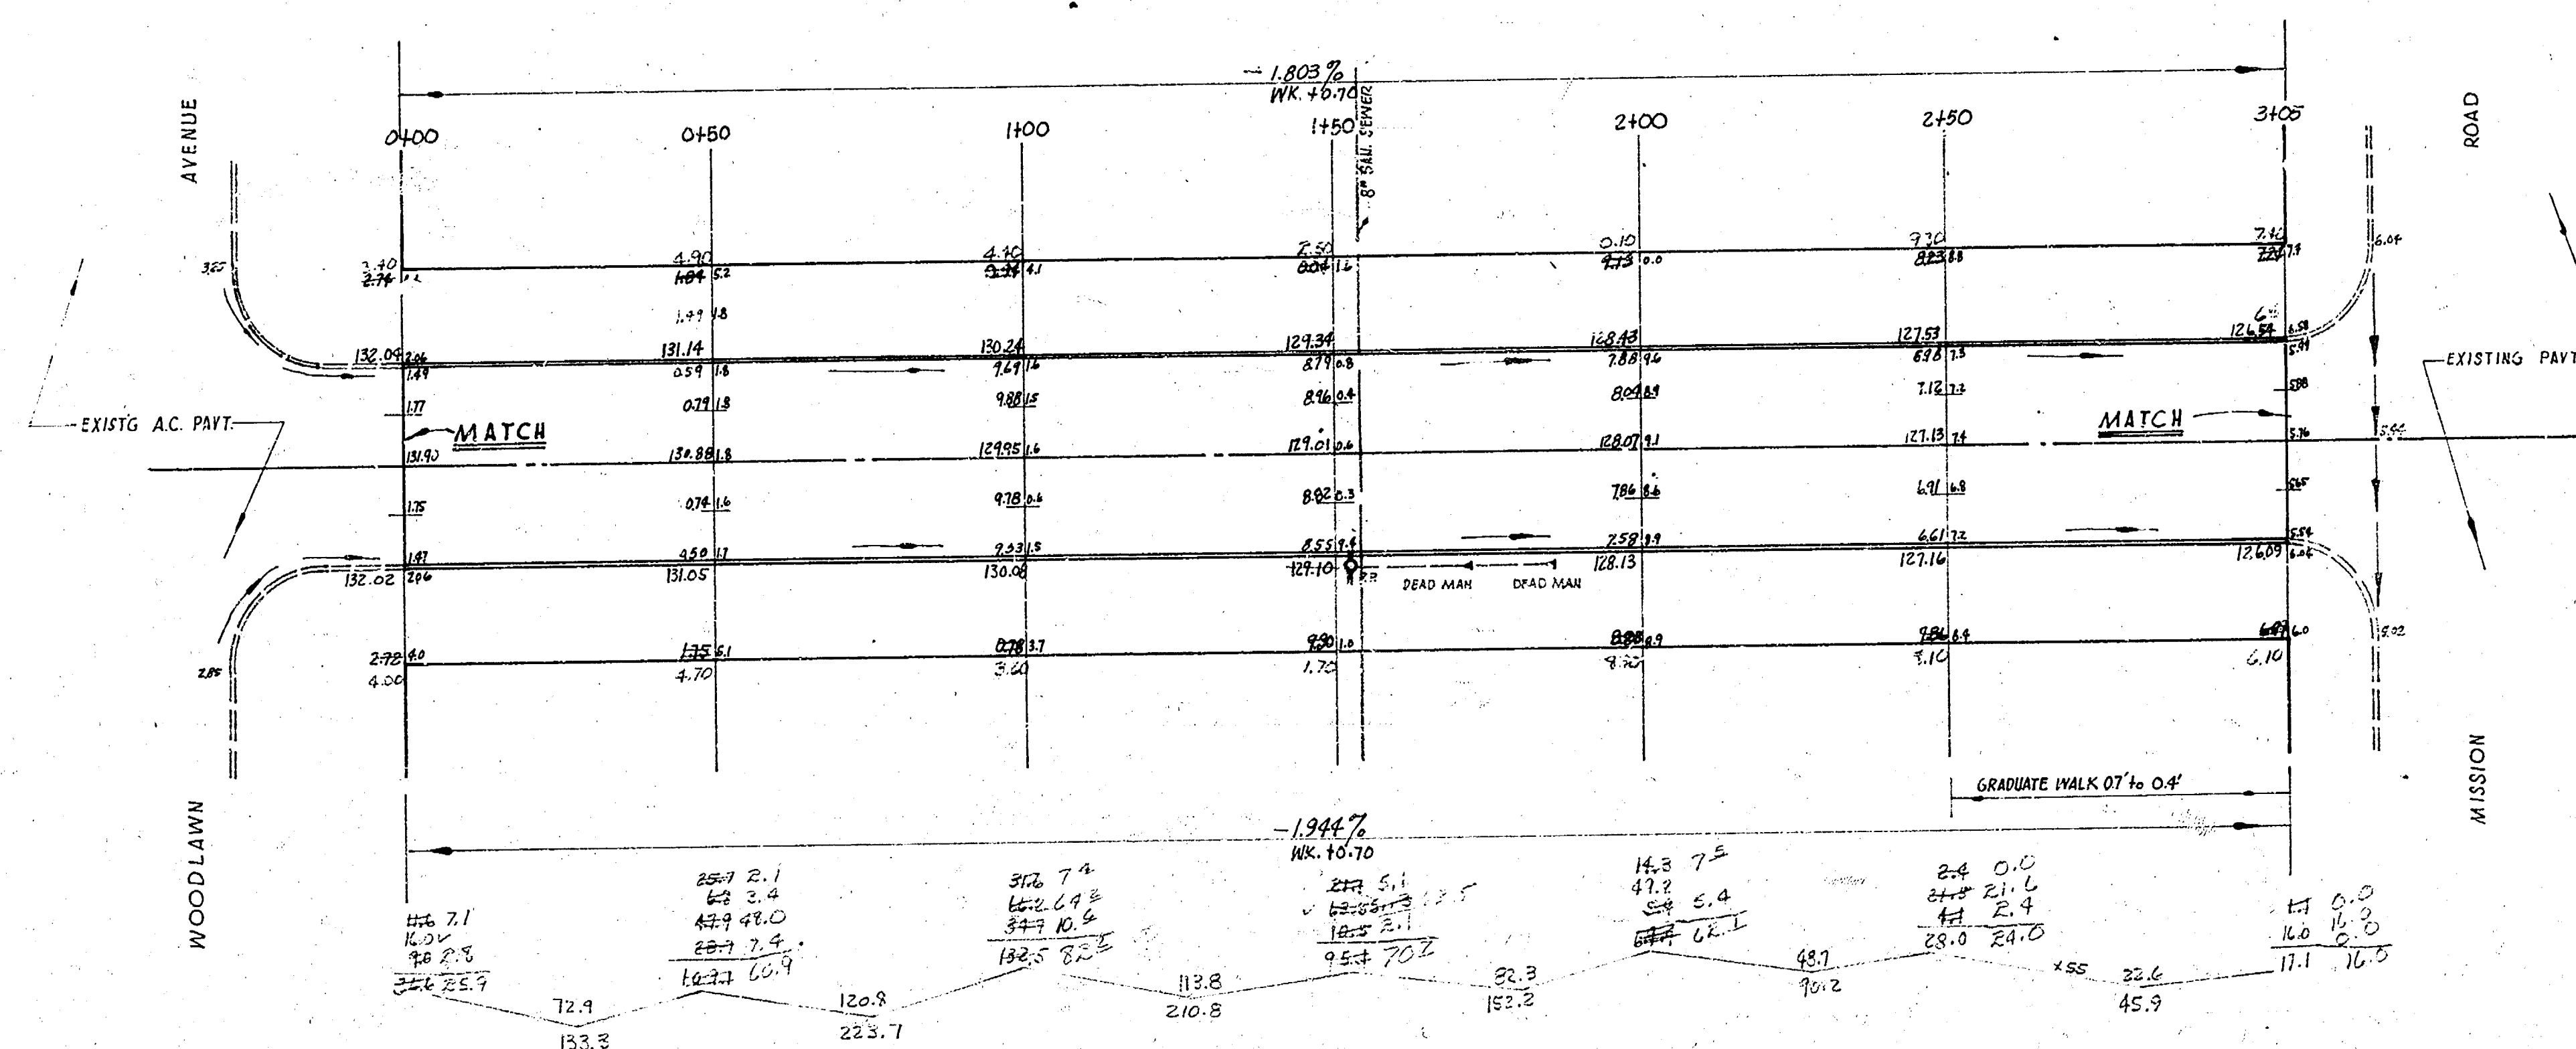

DETAIL OF MASTIC JT.

EXCAVATION TOTALS

PROP	CITY
856.1	0
+10% 85.6	
941.7 CK	0 CK & E SMITH

FUNSTON AVENUE

EL. WOODLAWN AVE. - M.L. MISSION ROAD

30' CONCRETE + CB

CITY OF WICHITA, KANSAS

D.E. SMITH CITY ENGINEER

DATE: Sept. 1958 PROJ. NO. C12-261

Seal
C. H. Smith
City Engineer
Wichita, Kansas

