


FUNSTON COURTS
 N.L. Funston To Incl. Cul-de-sac (First Court E. Cypress)
 " " " " " (First Court W. Beech)
 472-76-245-80886-000-000-001

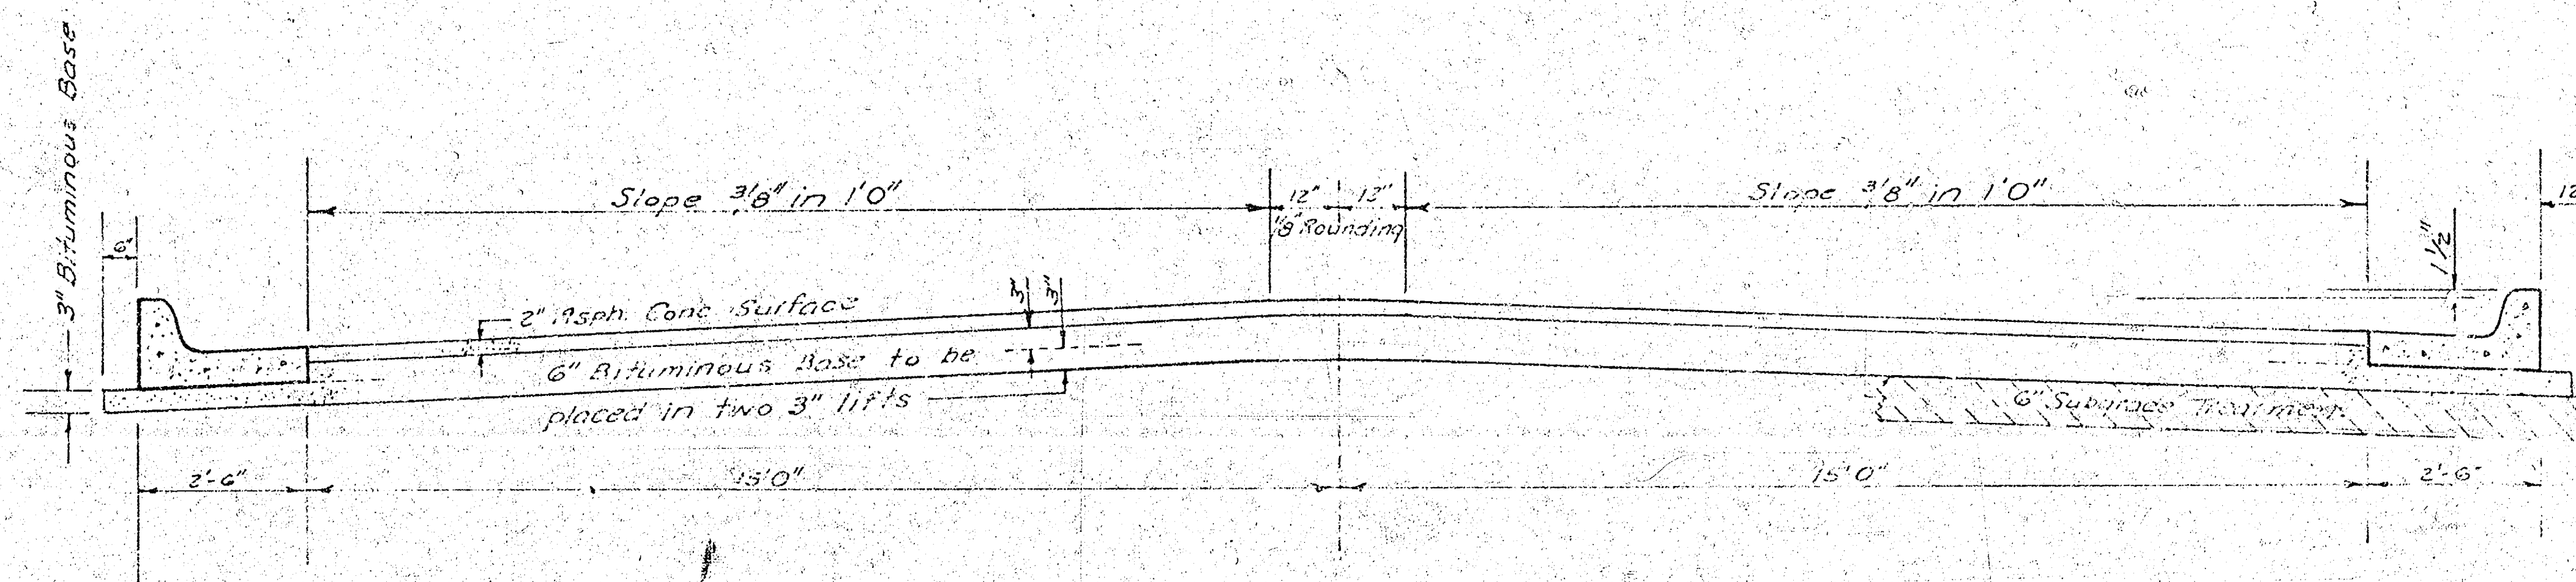


TYPICAL SECTION

35' ASPHALTIC CONCRETE PAVEMENT WITH BITUMINOUS BASE

A TACK COAT OF EMULSIFIED ASPHALT (SS-1H) SHALL BE APPLIED AT AN APPROXIMATE RATE 0.05 GALLONS PER SQ YD BETWEEN LIFTS OF ASPHALTIC MATERIALS WHEN ORDERED BY THE ENGINEER. TACK COAT WILL NOT BE PAID FOR DIRECTLY AND SHALL BE CONSIDERED AS SUBSIDIARY TO PRICE BID FOR ASPHALTIC PAVEMENT.



BITUMINOUS BASE AND ASPHALTIC CONCRETE WEARING SURFACE SHALL BE PLACED WITH A LAYDOWN MACHINE HAVING AUTOMATIC CONTROLS FOR CROWN AND GRADE. CONSTRUCTION JOINTS IN EACH LIFT SHALL BE STAGGERED A MINIMUM DISTANCE OF 1' WITH JOINTS IN PRECEDING LIFTS AND PLACED SUCH THAT A JOINT WILL BE CONSTRUCTED ON THE CENTERLINE IN THE TOP LIFT.

DETAIL OF TRANSVERSE CONSTRUCTION JOINTS

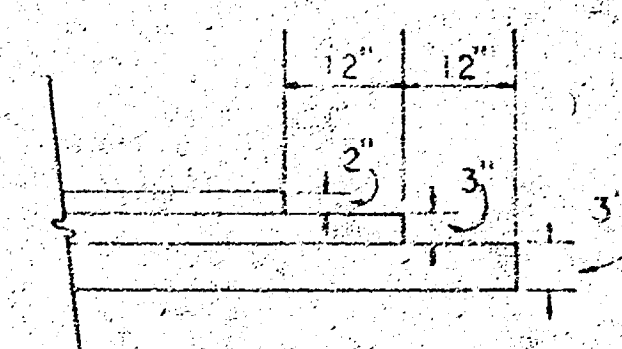

TRANSVERSE CONSTRUCTION JOINTS SHALL BE CONSTRUCTED IN FLEXIBLE BASE PAVEMENTS AT LOCATIONS WHERE PAVEMENT TEMPORARILY ENDS TO FACILITATE FUTURE PAVEMENT CONSTRUCTION AS SHOWN BY DETAIL. THE COST OF CONSTRUCTING THE TRANSVERSE CONSTRUCTION JOINTS SHALL NOT BE MEASURED OR PAID FOR DIRECTLY BUT SHALL BE INCLUDED IN THE BID PRICE FOR SQUARE YARDS OF ASPHALTIC CONCRETE PAVEMENT.

The A.C. Pavement between the curb and gutter shall be paid as Sq.Yds. 8" (10" placement) (6" Bituminous Base). The Bituminous Base under the curb and gutter shall be paid as Sq.Yds. 3" Bituminous Base.

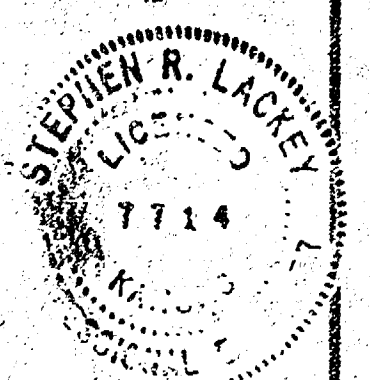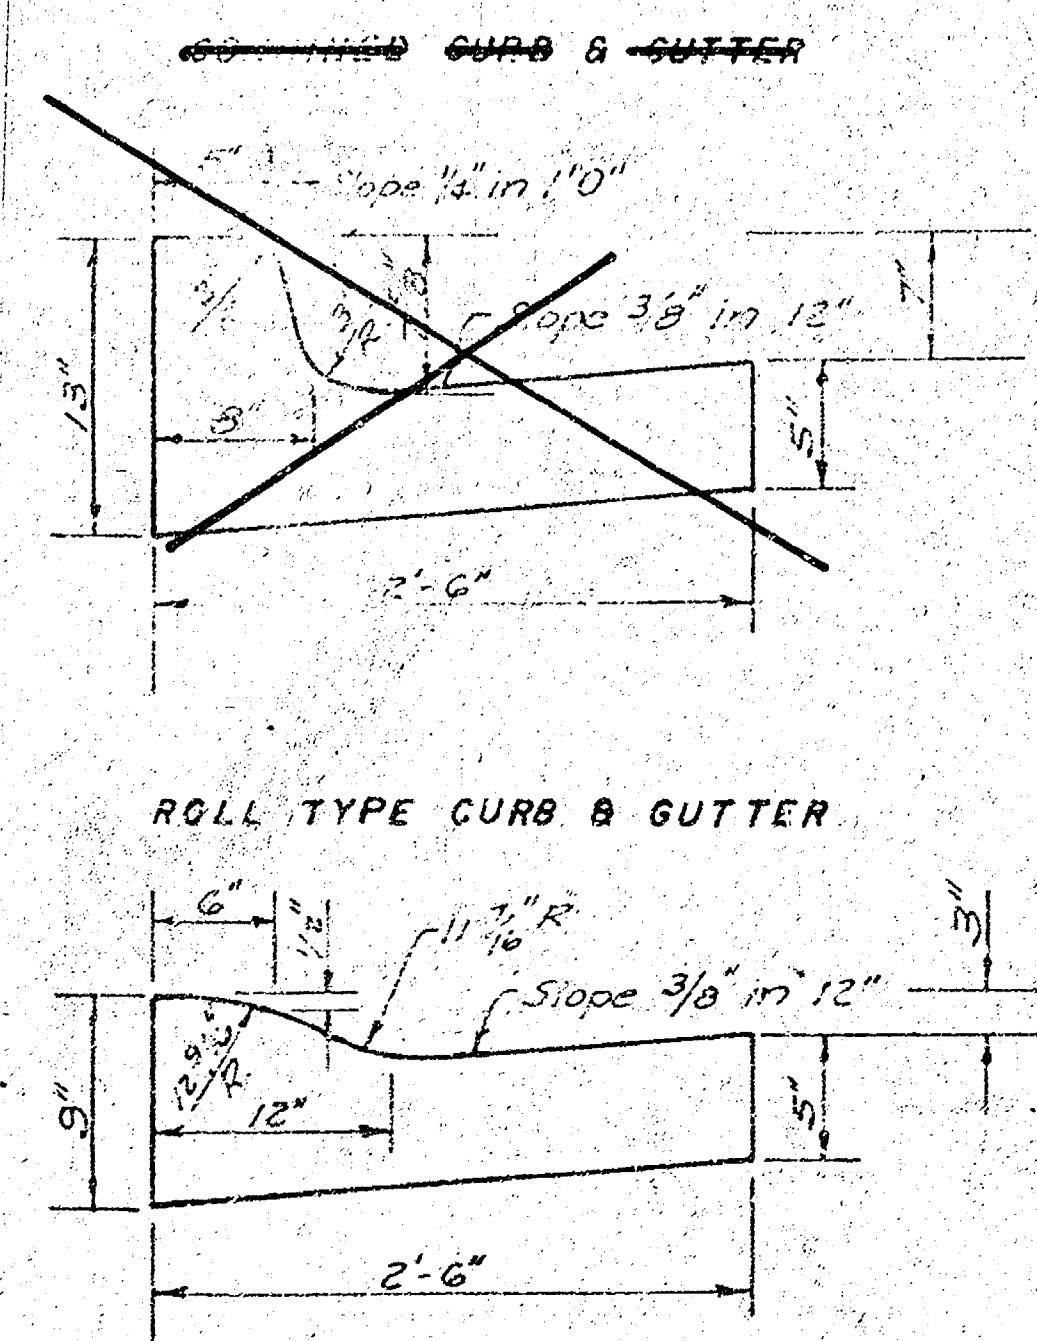



CITY OF WICHITA KANSAS

DEPARTMENT of PUBLIC WORKS - Engineering Division.

Dean Sellers Acting CITY ENGINEER


DATE _____ Proj. No. 472-76-245-80886-000-000-001

B.M. 16948 R.R. Spk. On W-Face P Pole At NE Cor. Funston & Cypress

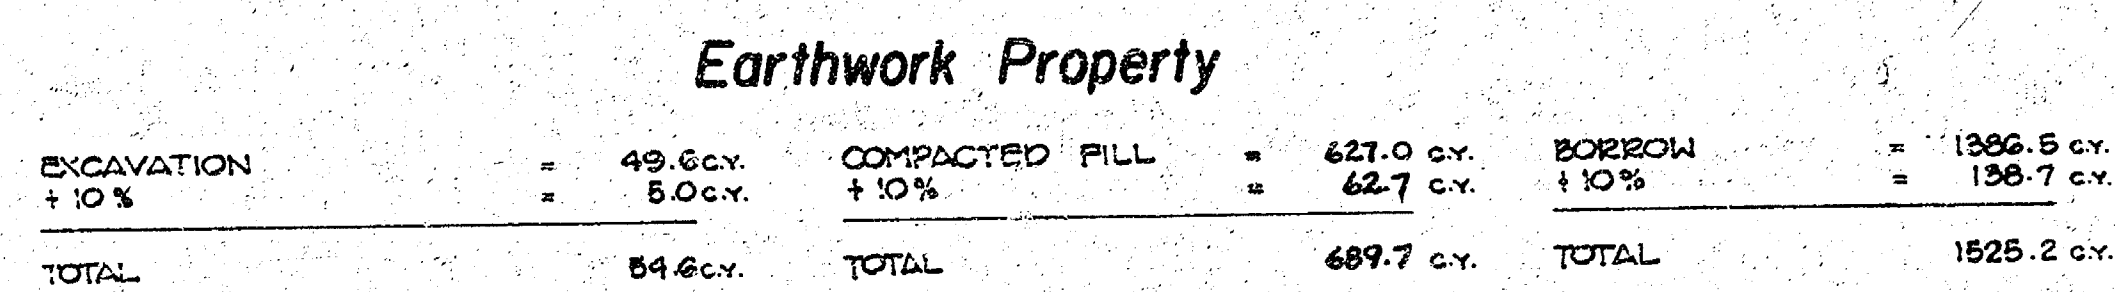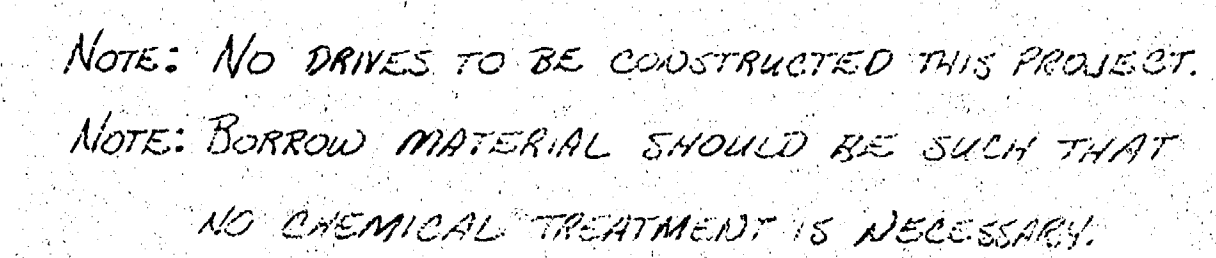

Funston Court
N.L. Funston - First Court
East Of Cypress
34' F-F With Comb. Curb & Gutter
City Of Wichita, Kansas
Dean Sellers City Engineer
Proj. No. 472 76 245 80886 000 000 001
Date: _____
Sheet 2 of 5

B.M. 16948 R.R. Spk. On W-Face P.Pole At NE Cor. Funston & Cypress

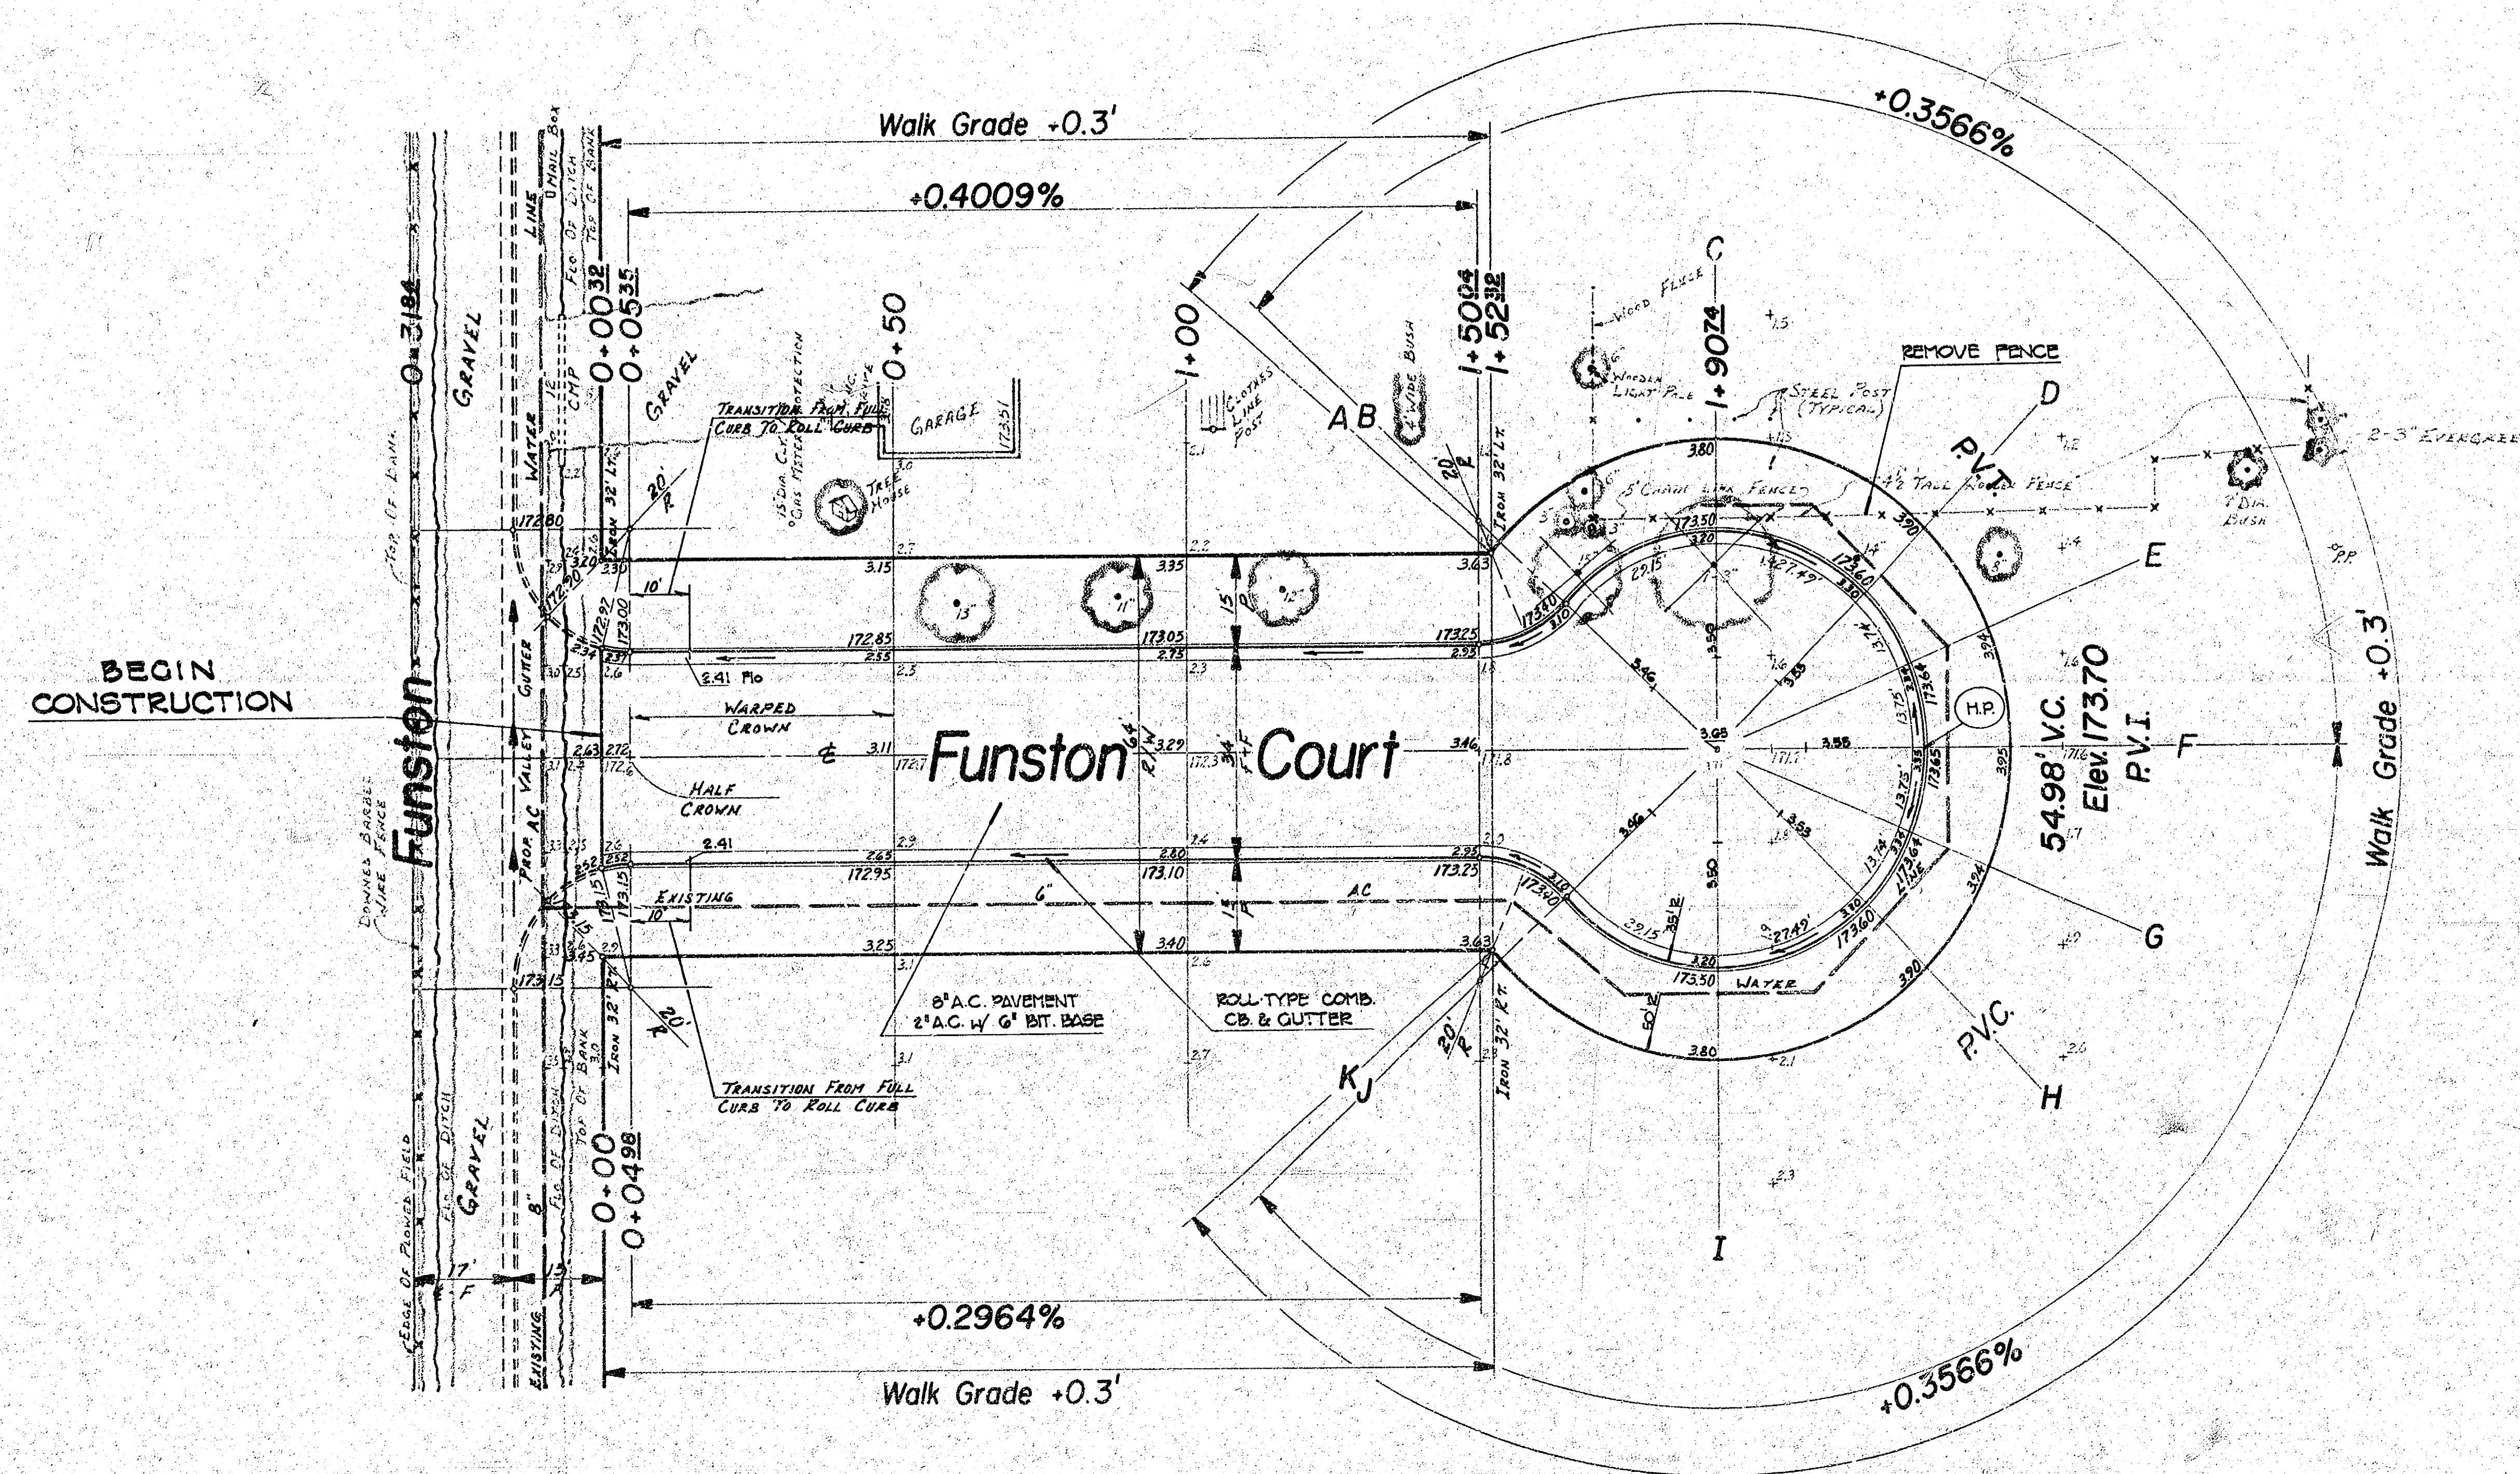

SURVEY RANBOR BOOK B F 32
PLAN RENOWELL
ENC. RENOWELL
CHECKED

Funston Court
N.L. Funston - First Court
West Of Beech

34' F-F With Comb. Curb & Gutter

City Of Wichita, Kansas

Dean Sellers City Engineer

Proj. No. 472 76 245 80886 000 000 001

Date _____

Sheet 3 Of 5

3013