



B.M. 90.65 Top Iron in Flood Control R/W Marker 200' N. 1/4 Sec. 16
W. of N. End Big Ar. River Bridge & Hydraulic

Base line for X-Sections on N. Ch. line E.S. of N.R.




Grand Total		Excav.		Fill		Excav.		Fill	
Prop.	City	Prop.	City	Prop.	City	Prop.	City	Prop.	City


Survey by
B.M. 90.65
Top Iron in Flood Control R/W Marker 200' N. 1/4 Sec. 16
W. of N. End Big Ar. River Bridge & Hydraulic

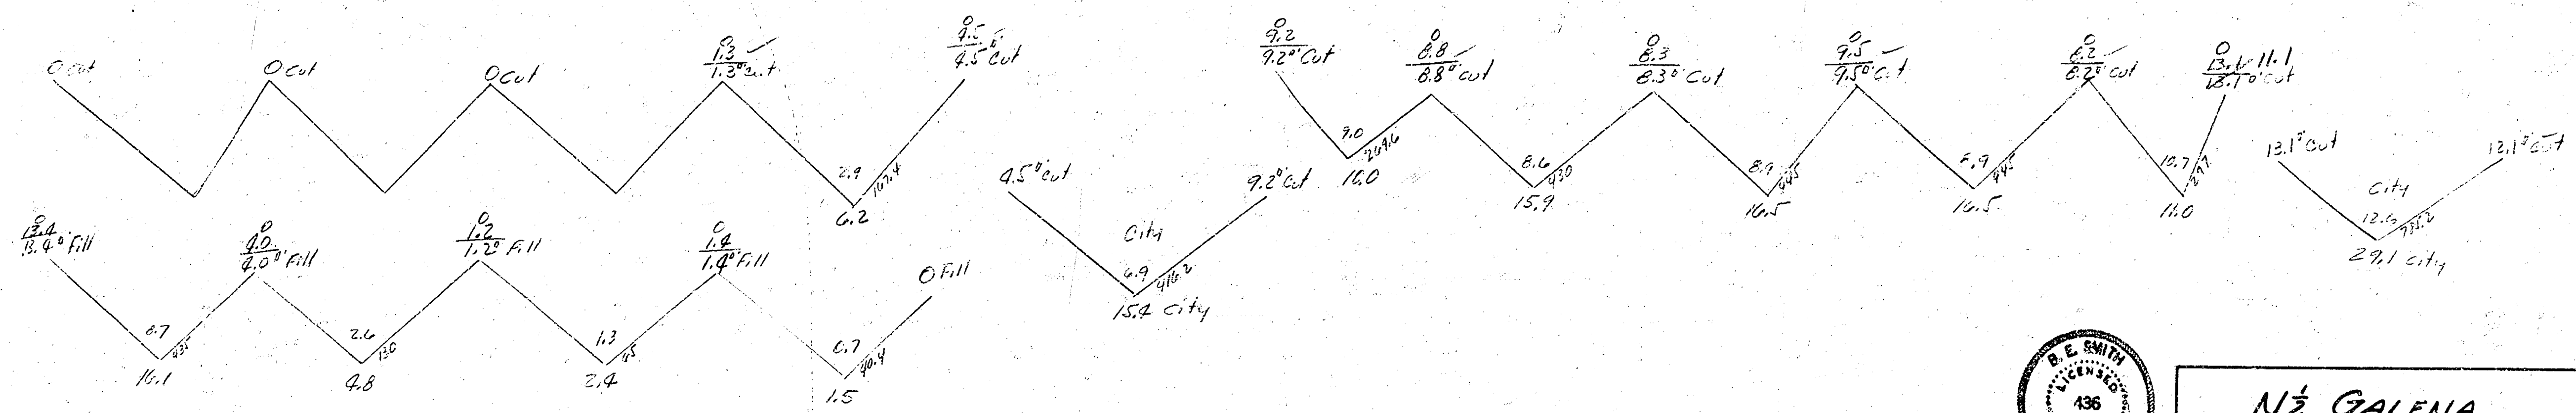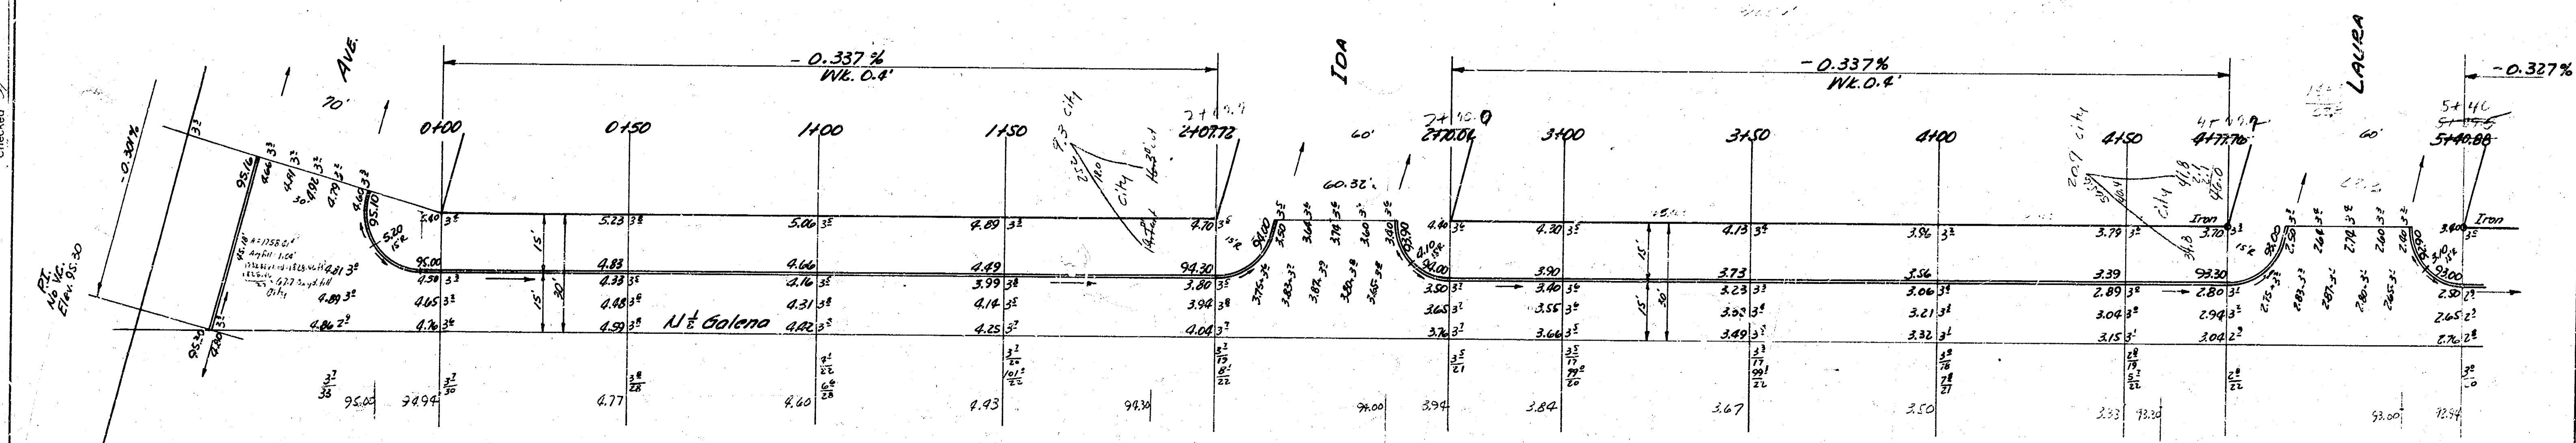

1
5

N. Ch. GALENA
W.L. WASHINGTON TO W.L. HYDRAULIC
15' CONC. & CO.
CITY OF WICHITA, KANSAS
B.E. SMITH CITY ENGINEER
Oct. 1955 Proj. No. C15-221

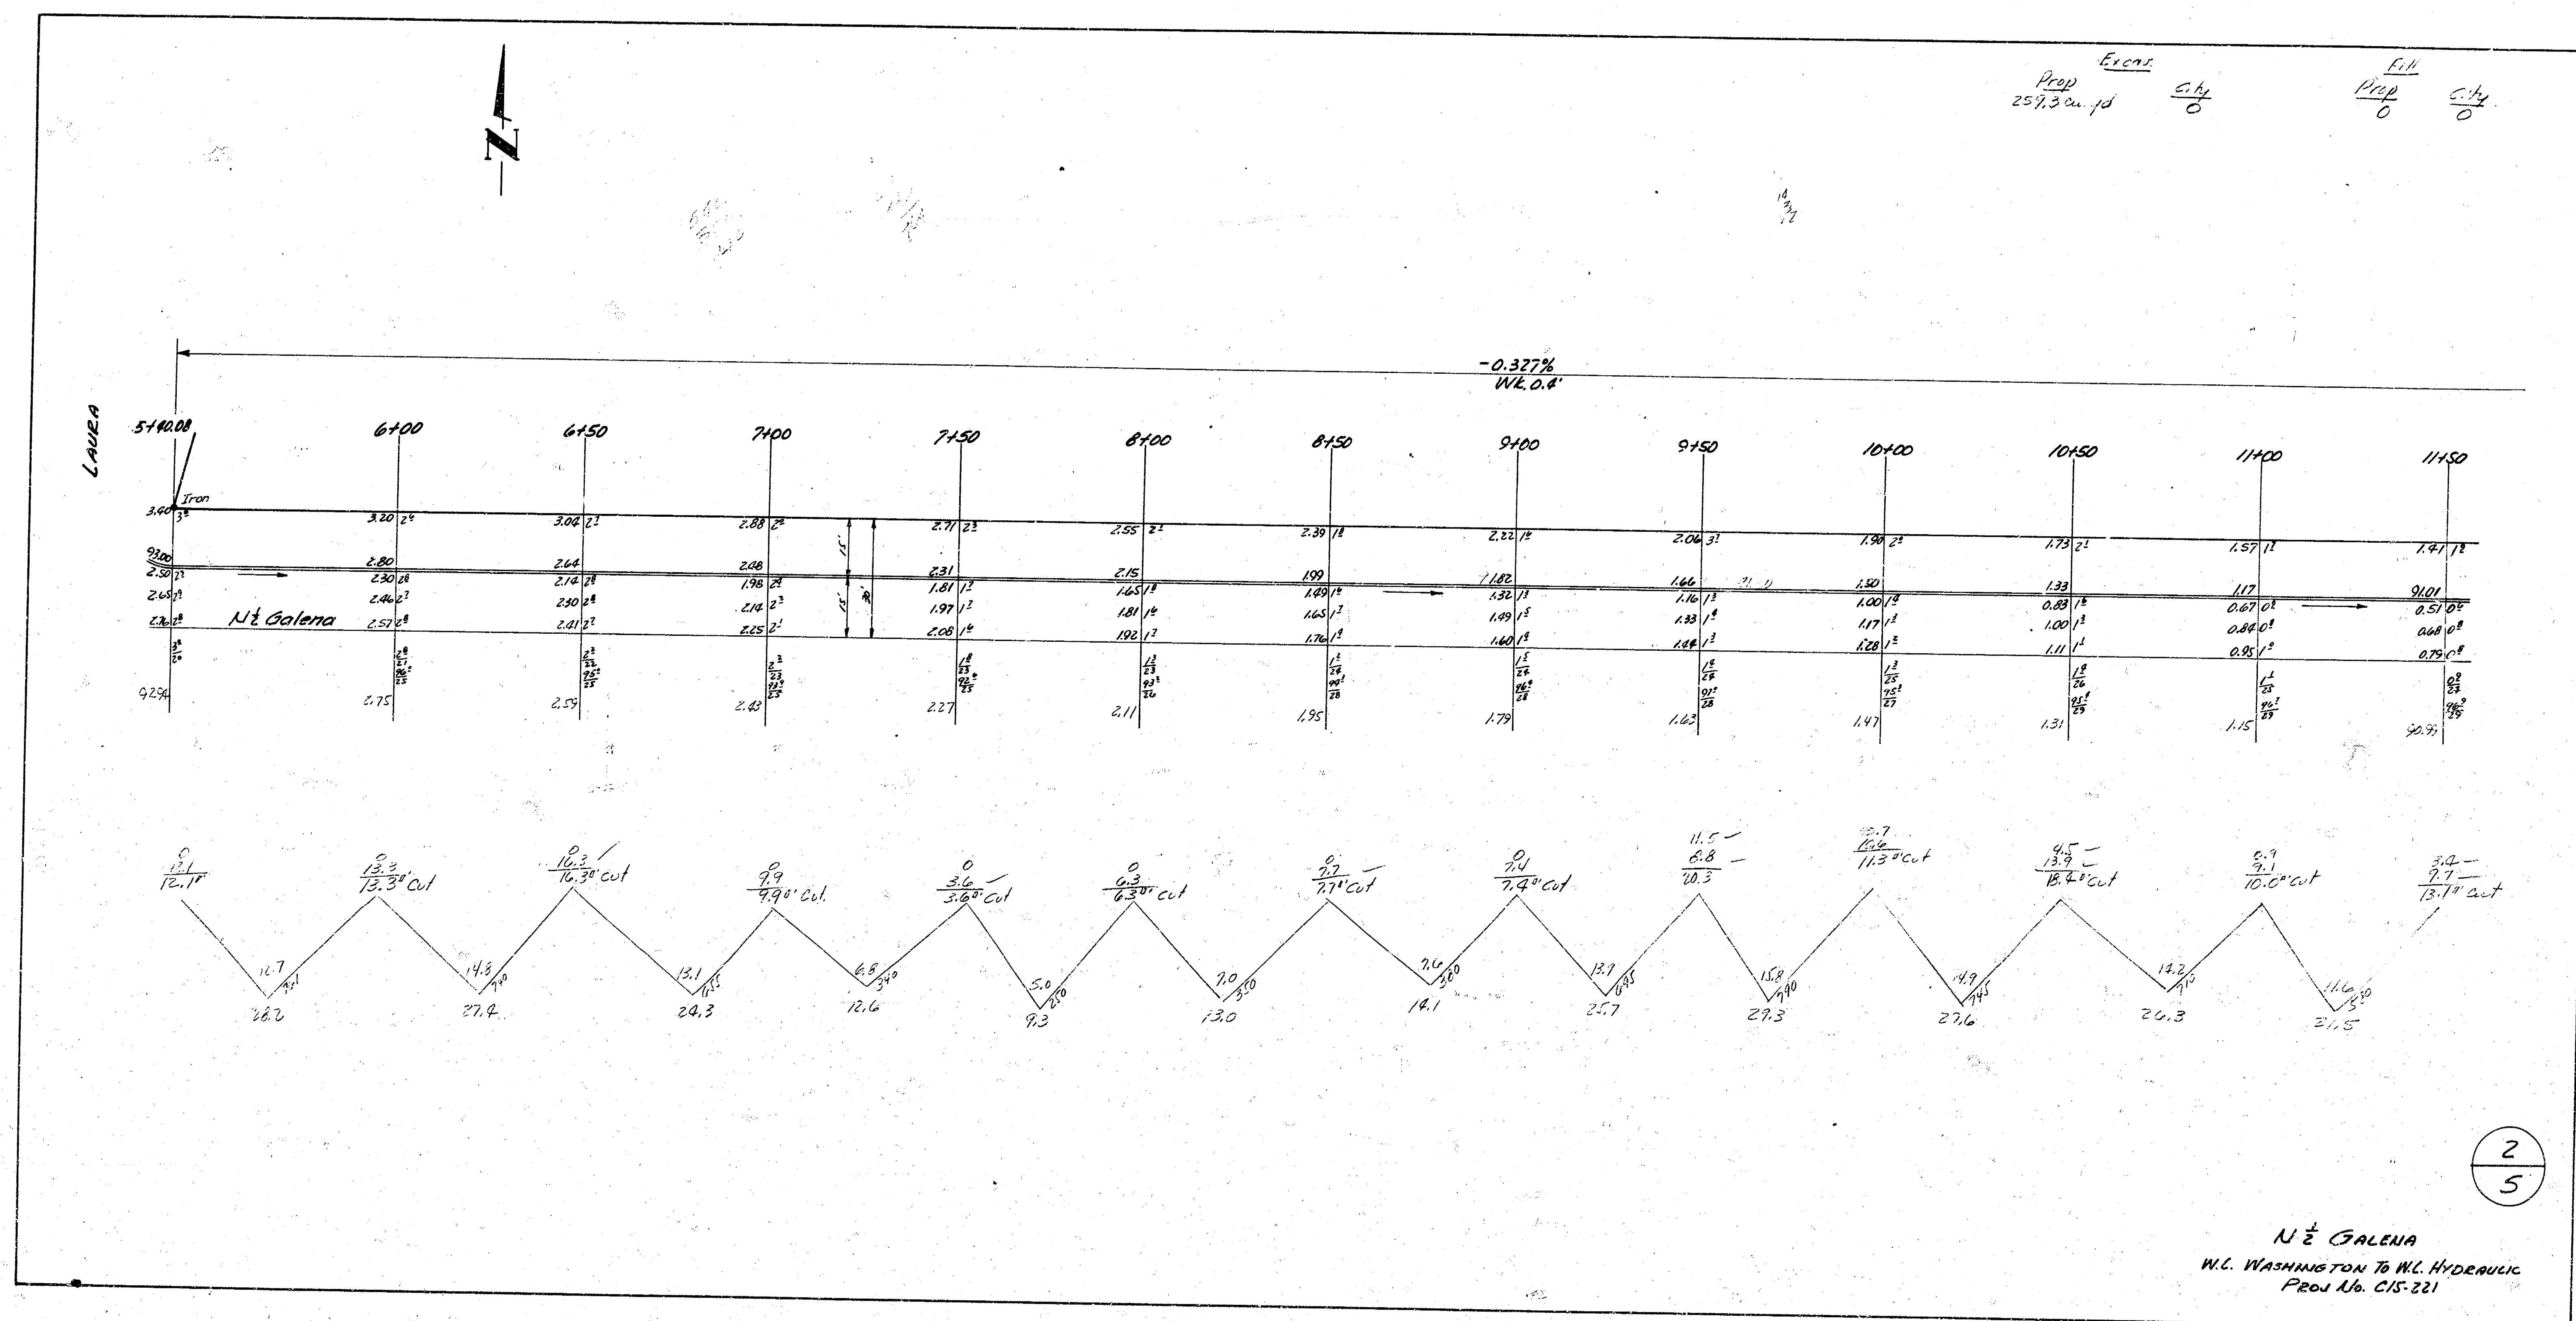

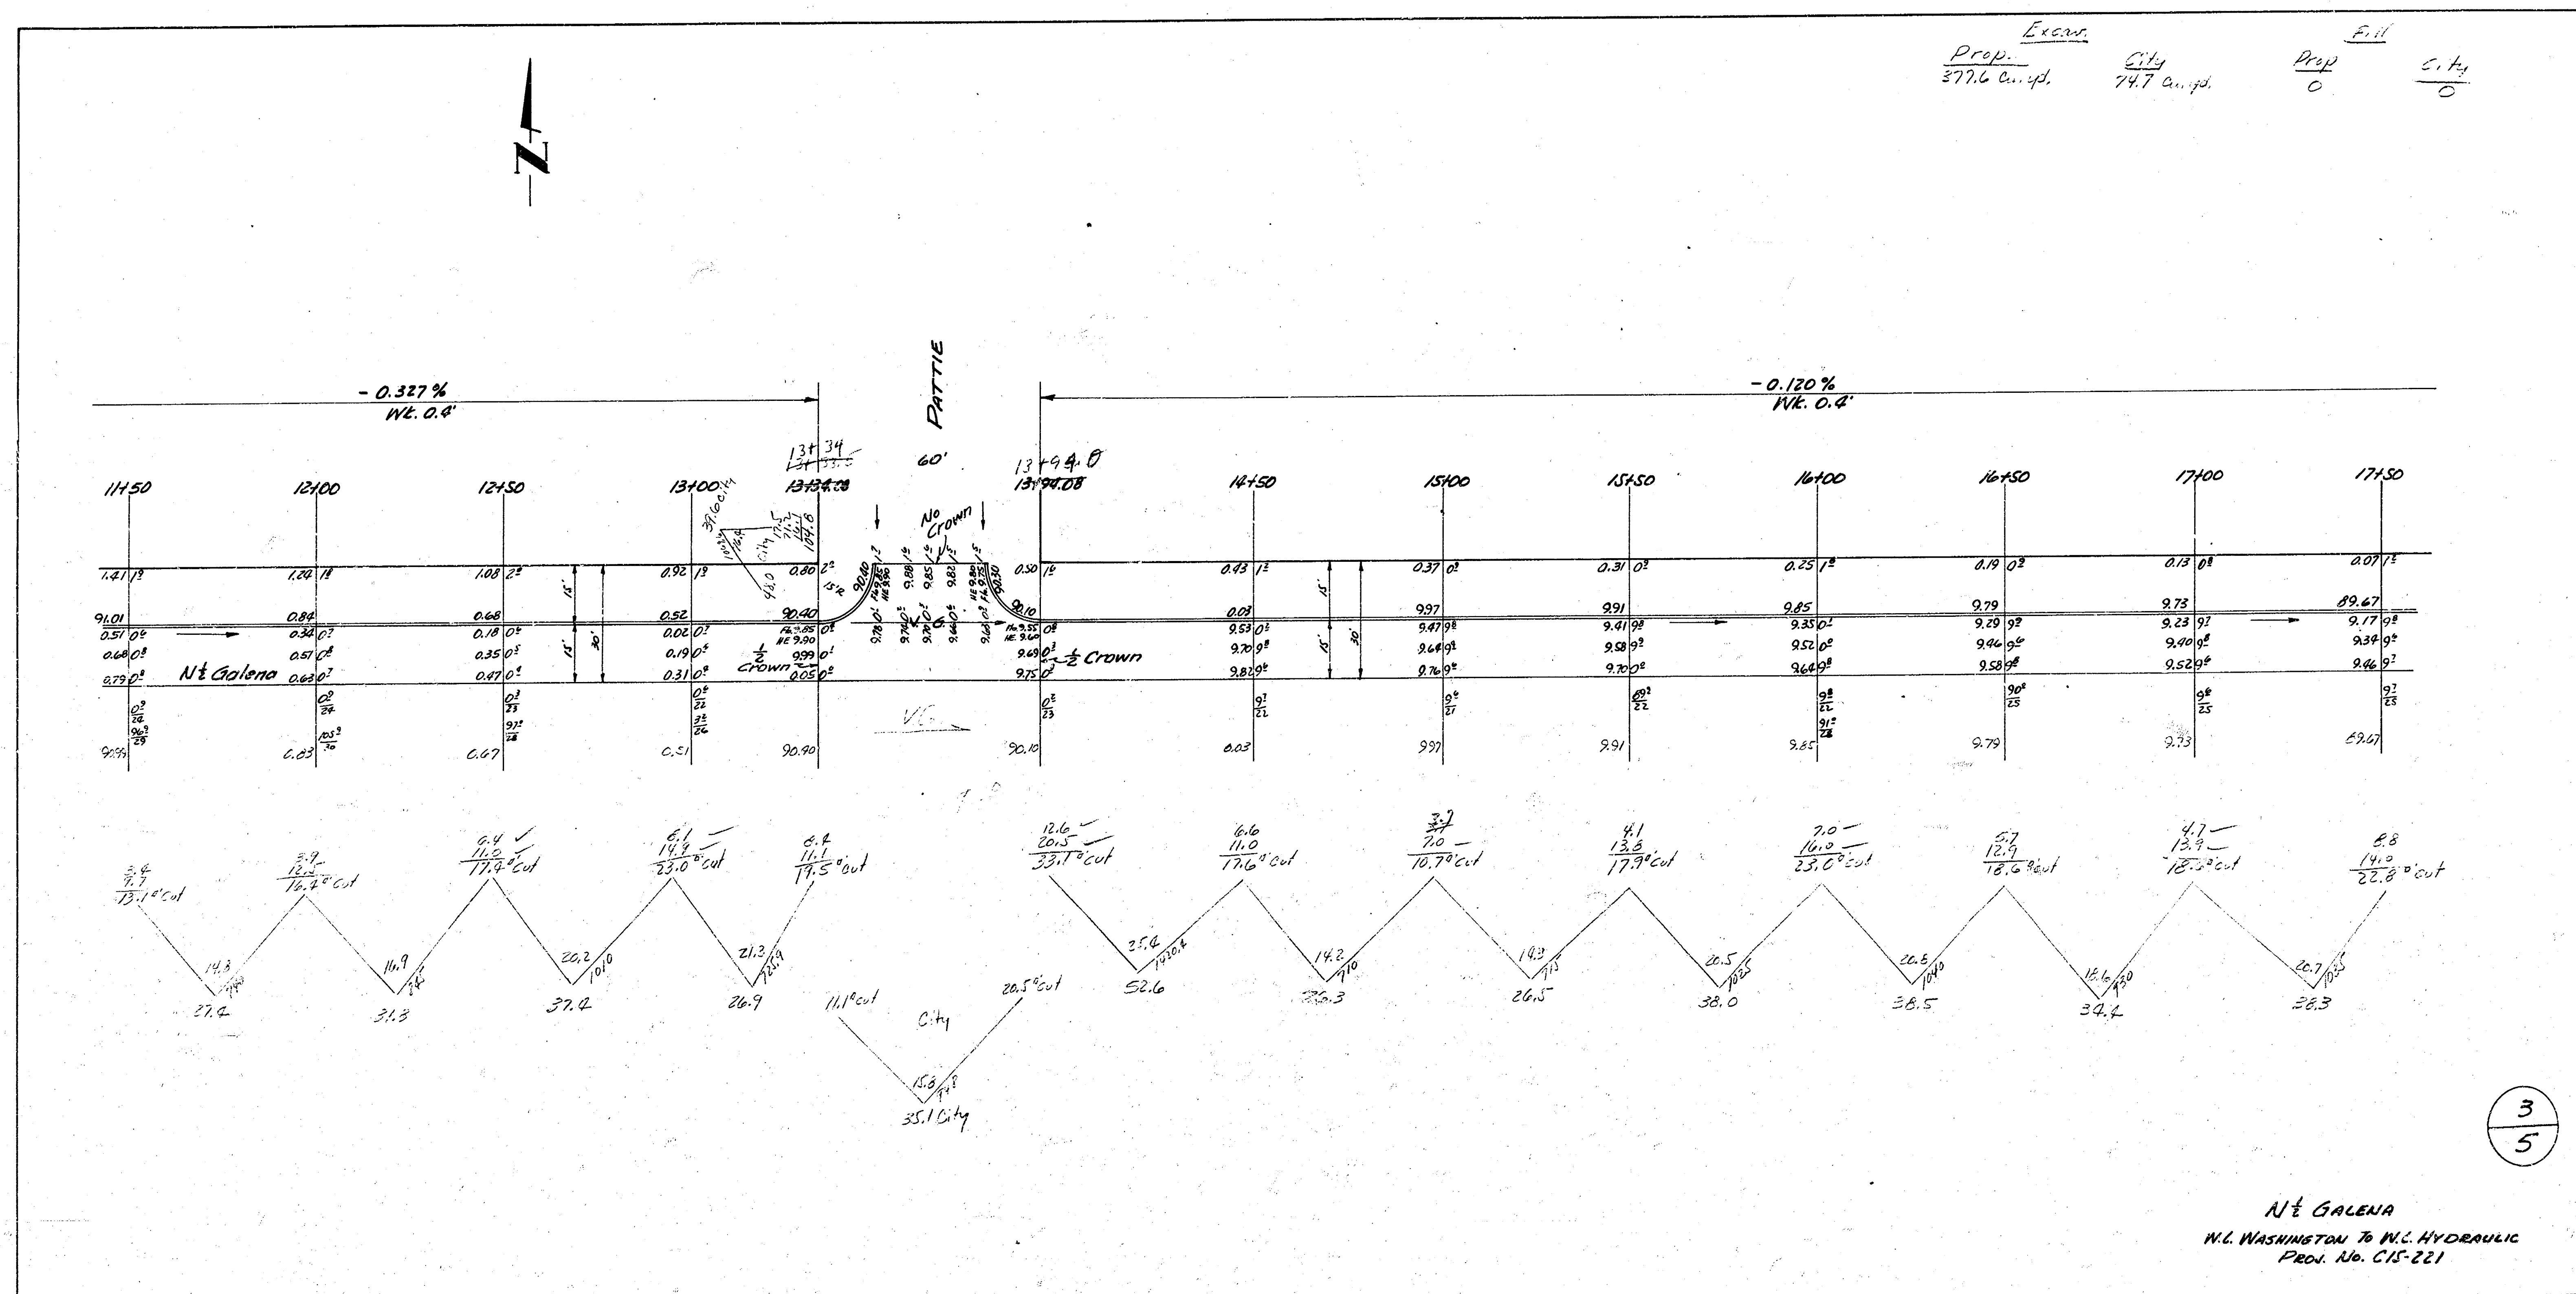

3
5

PROJ. NO. C15-221

