


Note: Chuck and I
 elevation at 17th +
 Road to be new
 is a 190 ft
 28.7 359

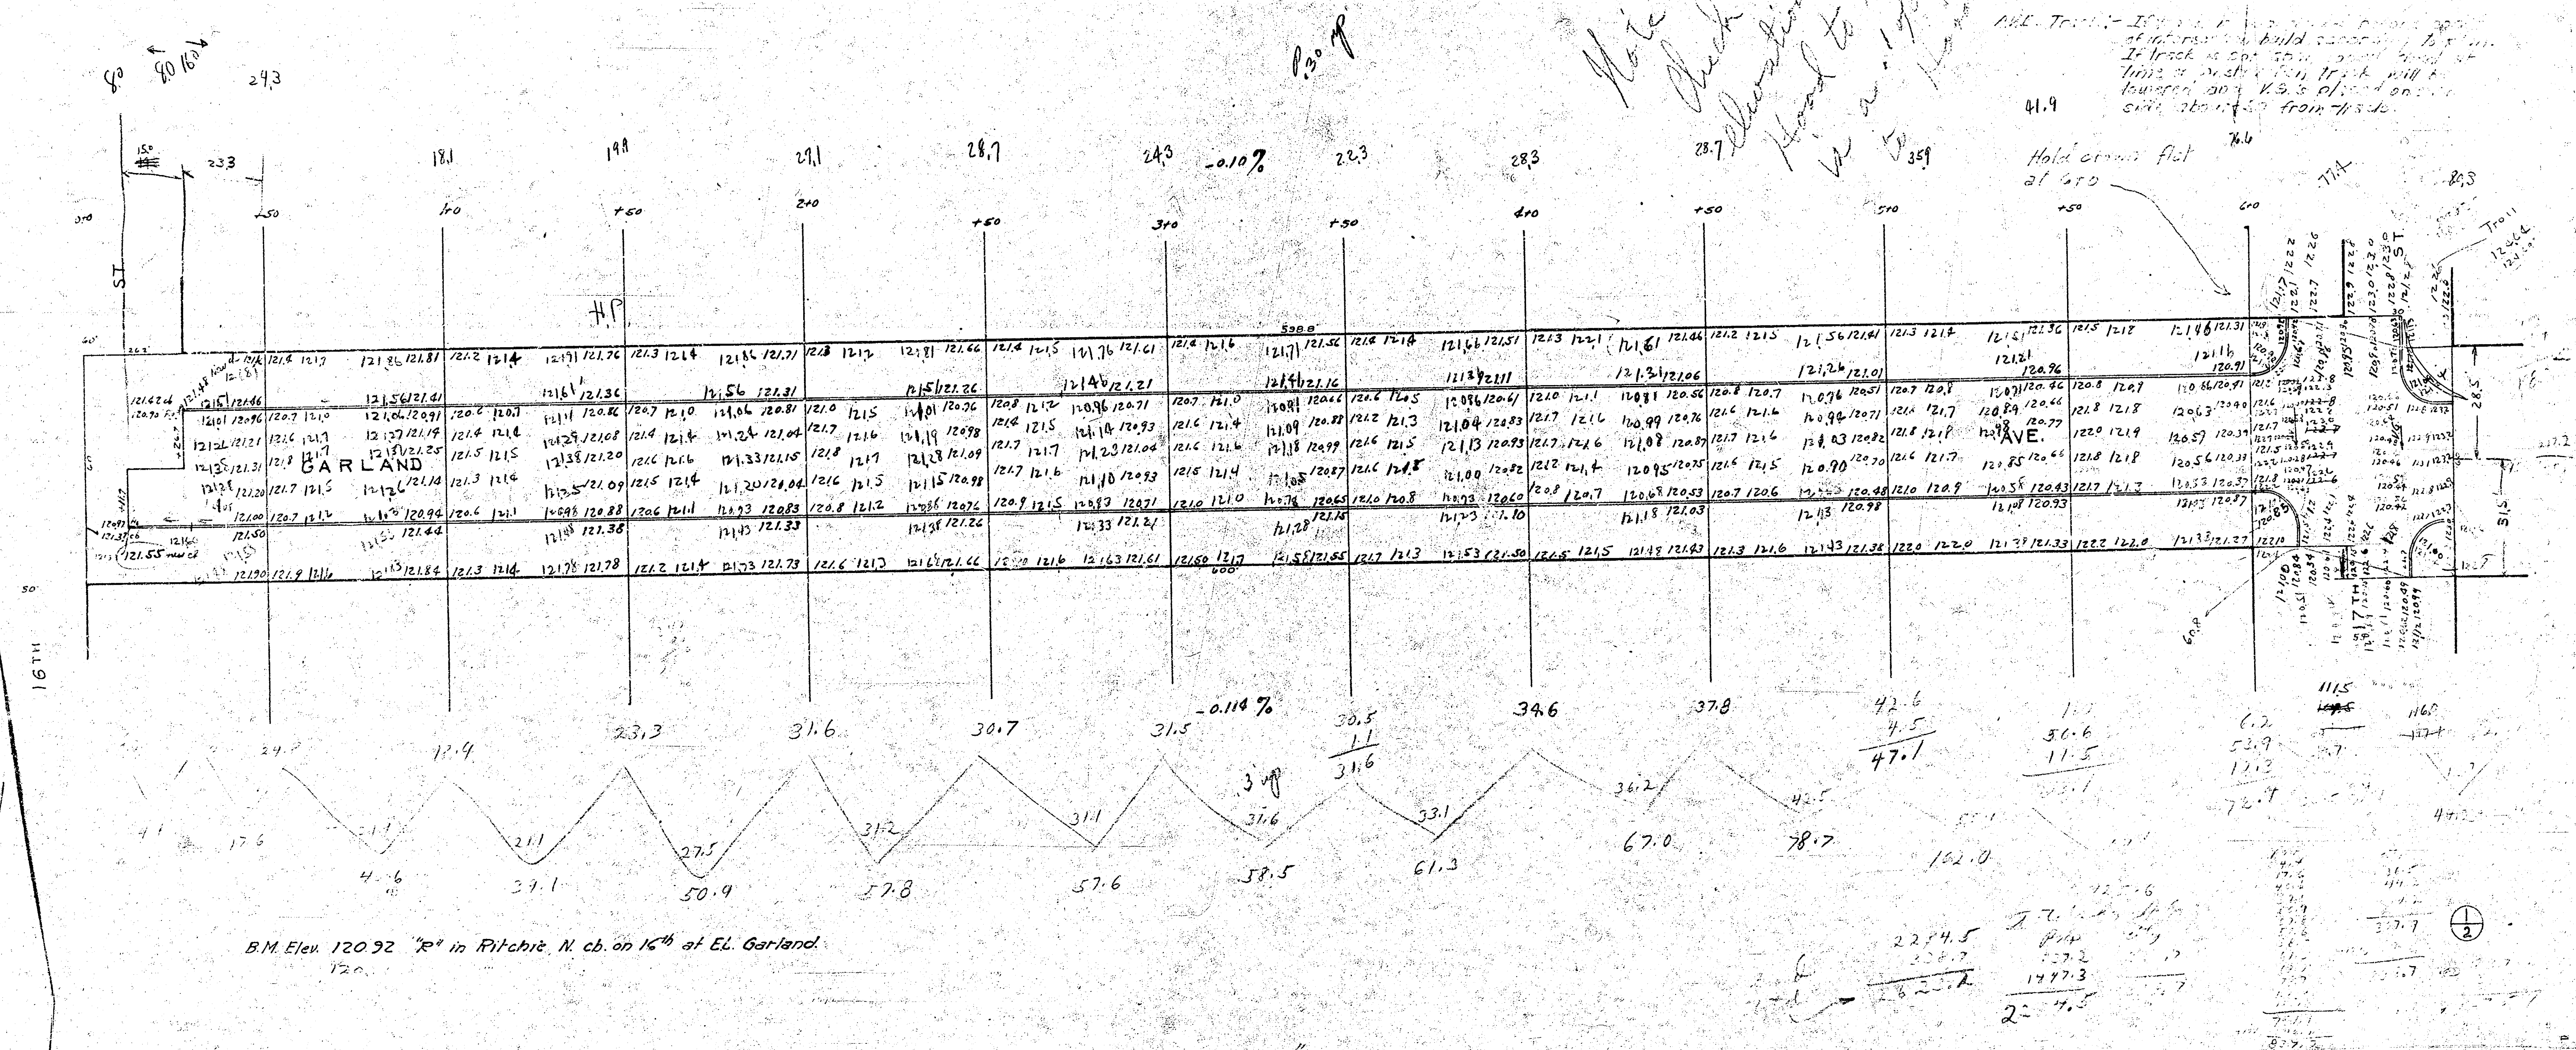

12.3
80.3
8.0
10.0.6

2.1
48.0
44.8

1.9
48.0
44.8

42.0

1.1
47.0
2.4
50.5

W/L 4
2.1 + 0.10%
1.3
50.9.59

4
43.4
2.4
46.2

7
40.4
6
4.19

418
17
480

0.7
39.4
40.1

35.4

3.6
0.6
37.2

1.8
52.2
2.4
56.4

46.1

0.00

7.50

17.0

7.50

27.0

37.0

7.50

47.0

57.0

7.50

67.0

NOTE: Hold crown
flat at 12.17.34 and
change to full crown
at 6.1.50.

