


1941
GARLAND - S.L. LOT 5 HANNA SUB. to S.L. 16TH
30' CONC

Note: Start approaching 16th St. int. with a flat crown from Sta. 3+85. Also build 16th St. int. to a crown of not more than 2".

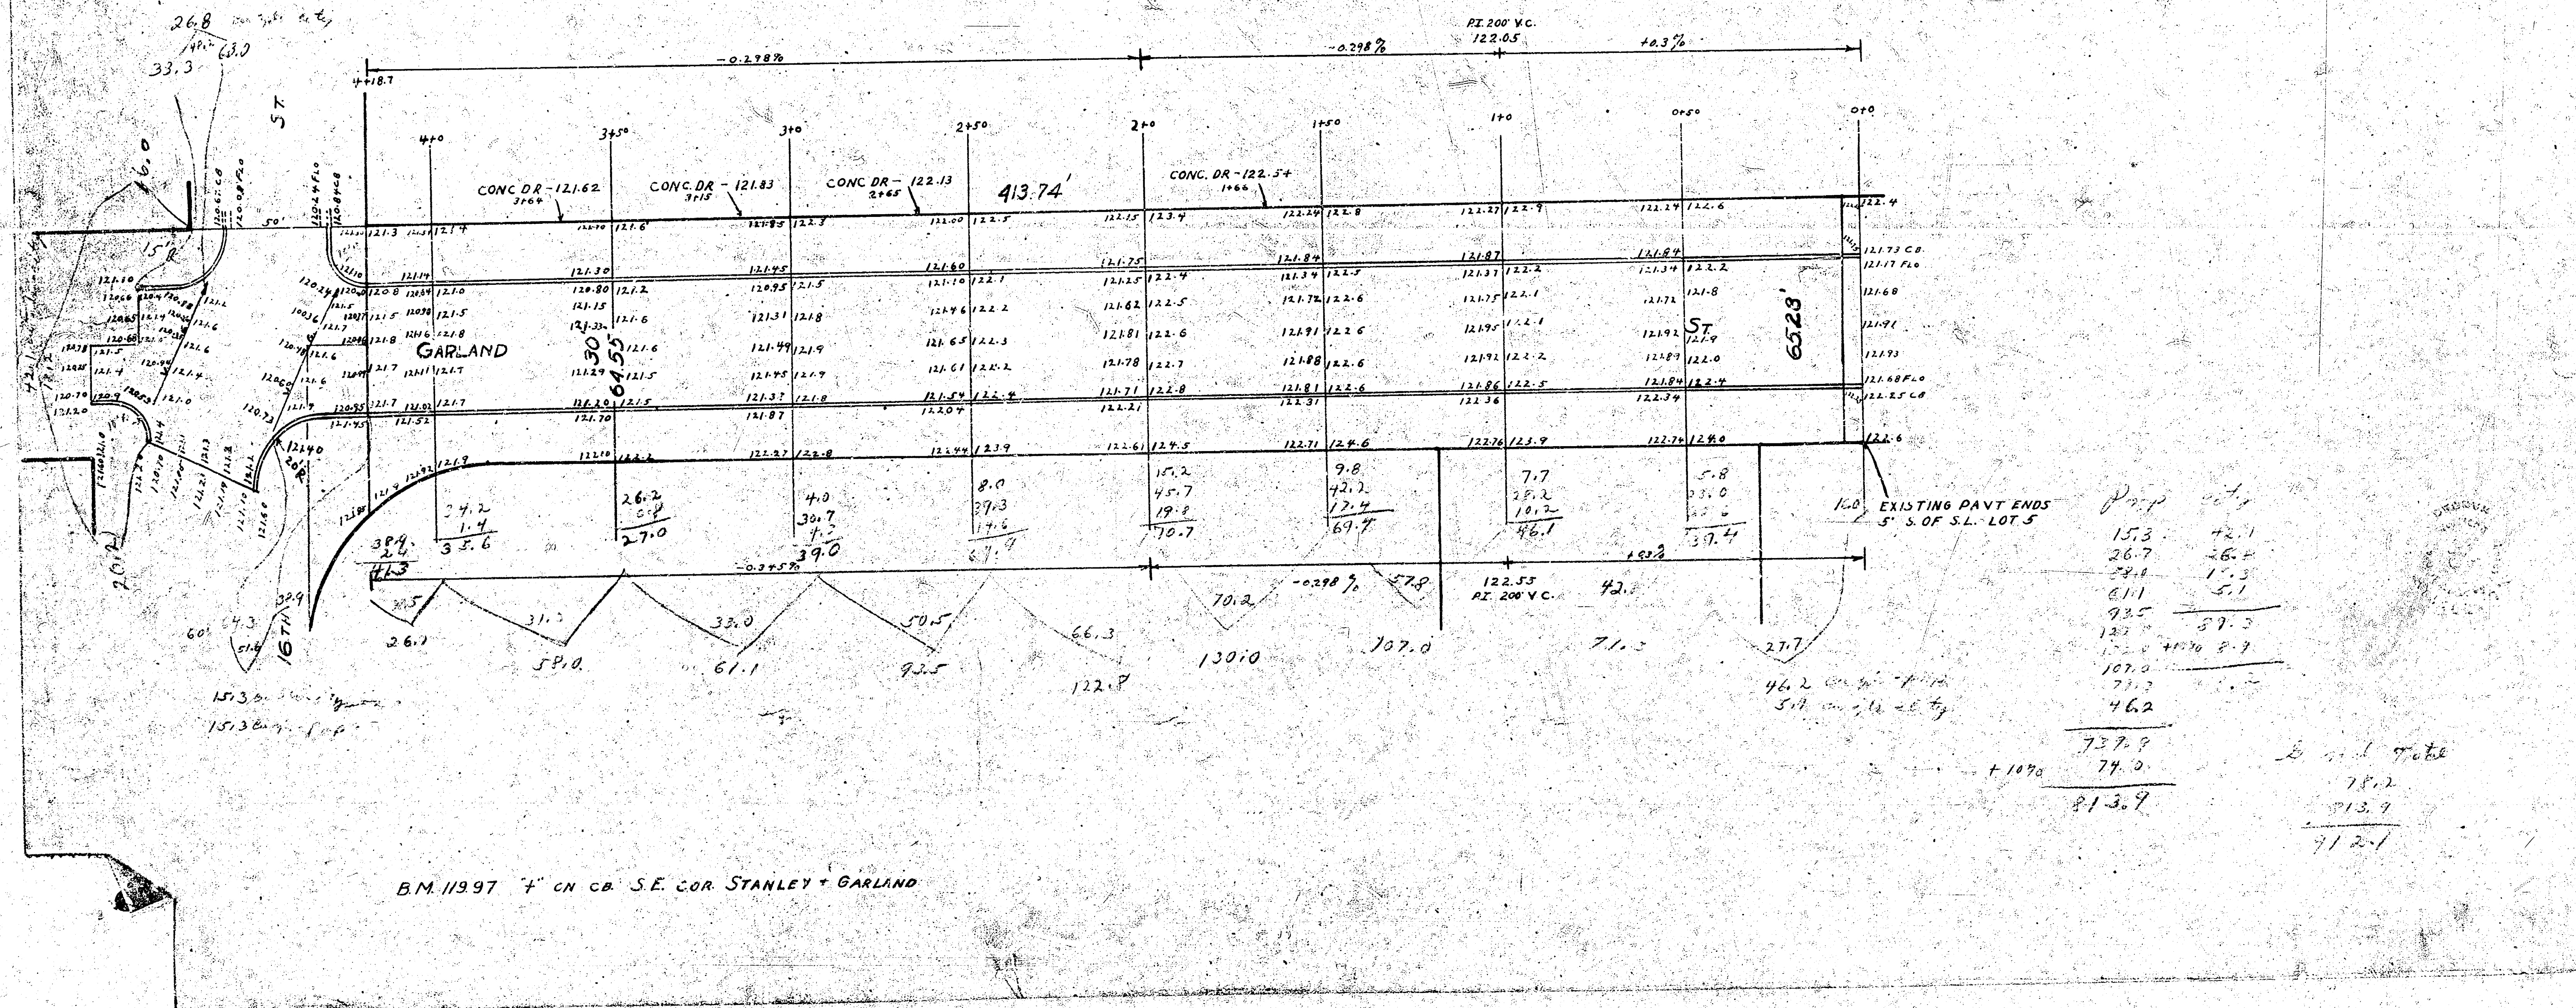

Prop	Act
15.3	42.1
26.7	26.4
24.8	15.3
61.1	5.1
93.5	59.3
127.0	44.9
107.0	8.9
71.3	
46.2	

737.9	78.2
74.0	513.9
813.9	712.1