

NOTE: Property pays for all of 26" slab. City pays for intersection.



<u>Property</u>	<u>City</u>
21.1	92.5
86.7	19.7
58.9	3.0
88.4	15.9
119.8	7.0
111.5	<u>138.1</u>
<u>512.4</u>	

Property Excavation

+10% $\frac{512.4}{51.2}$
Total - 563.6 cu yds.

City - 138.1
13.8


151.9 cu yds.

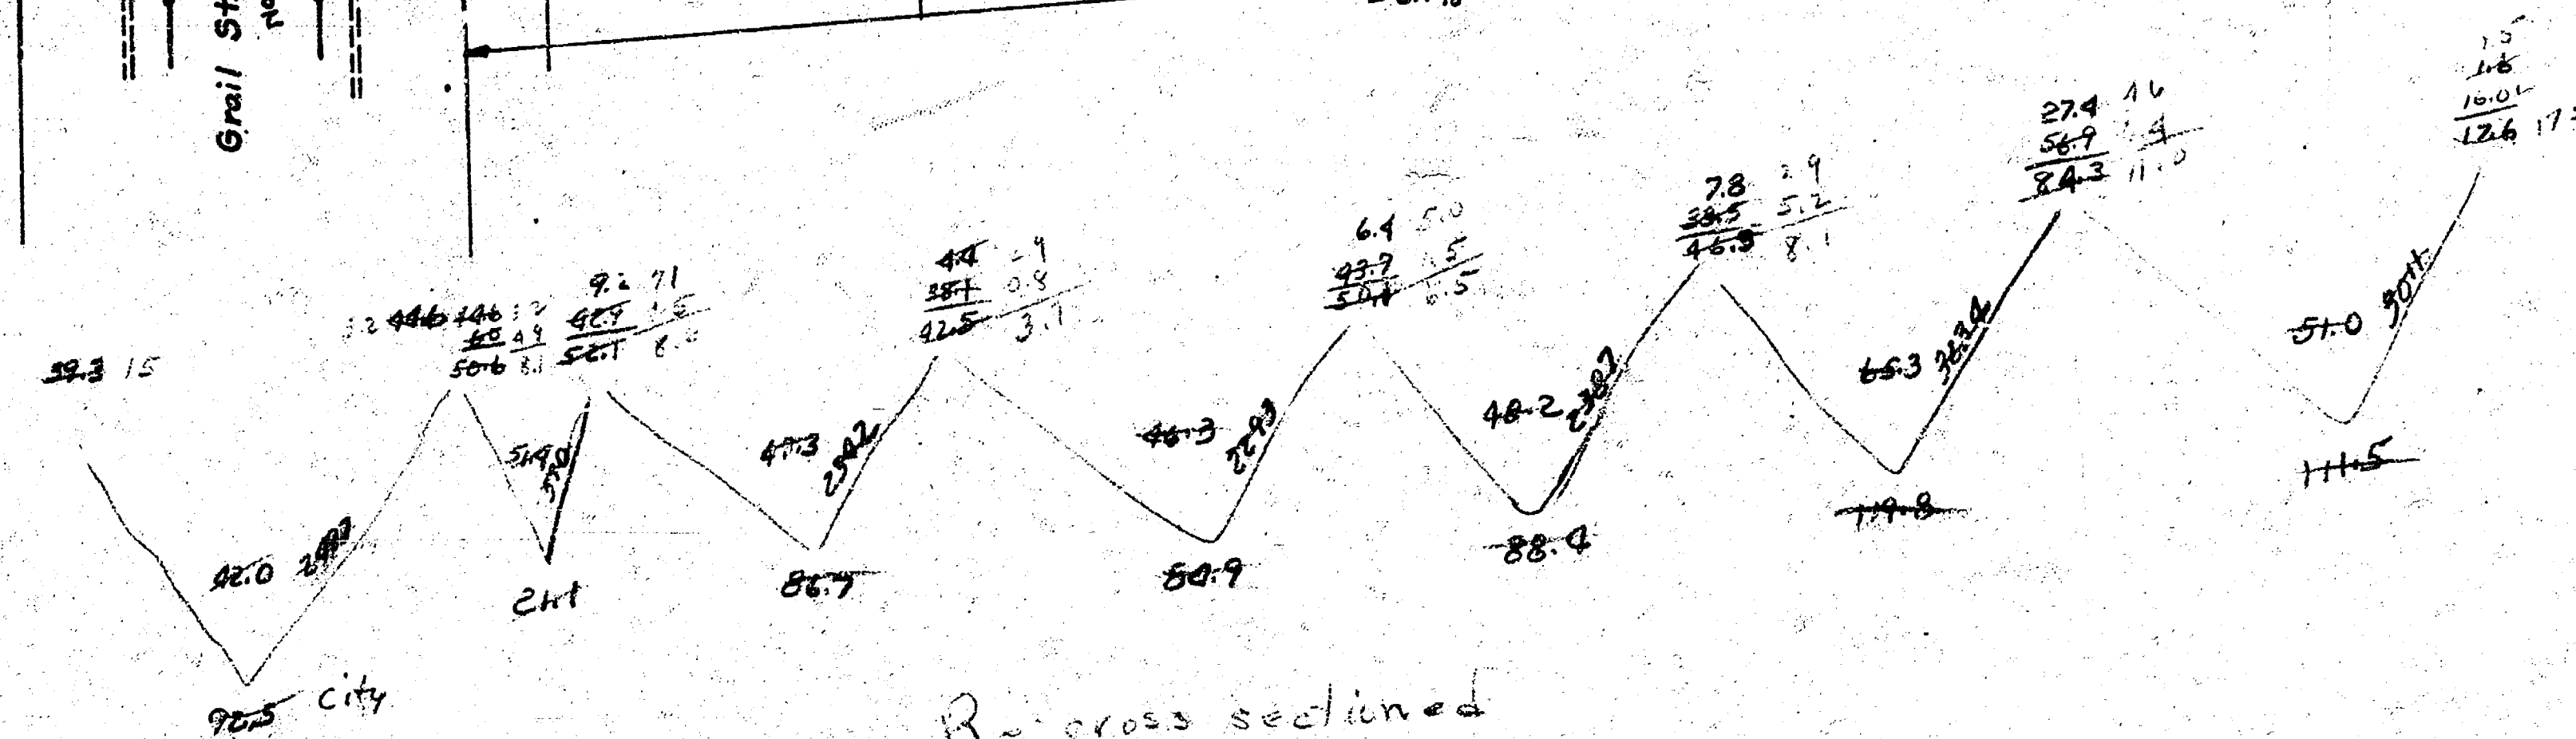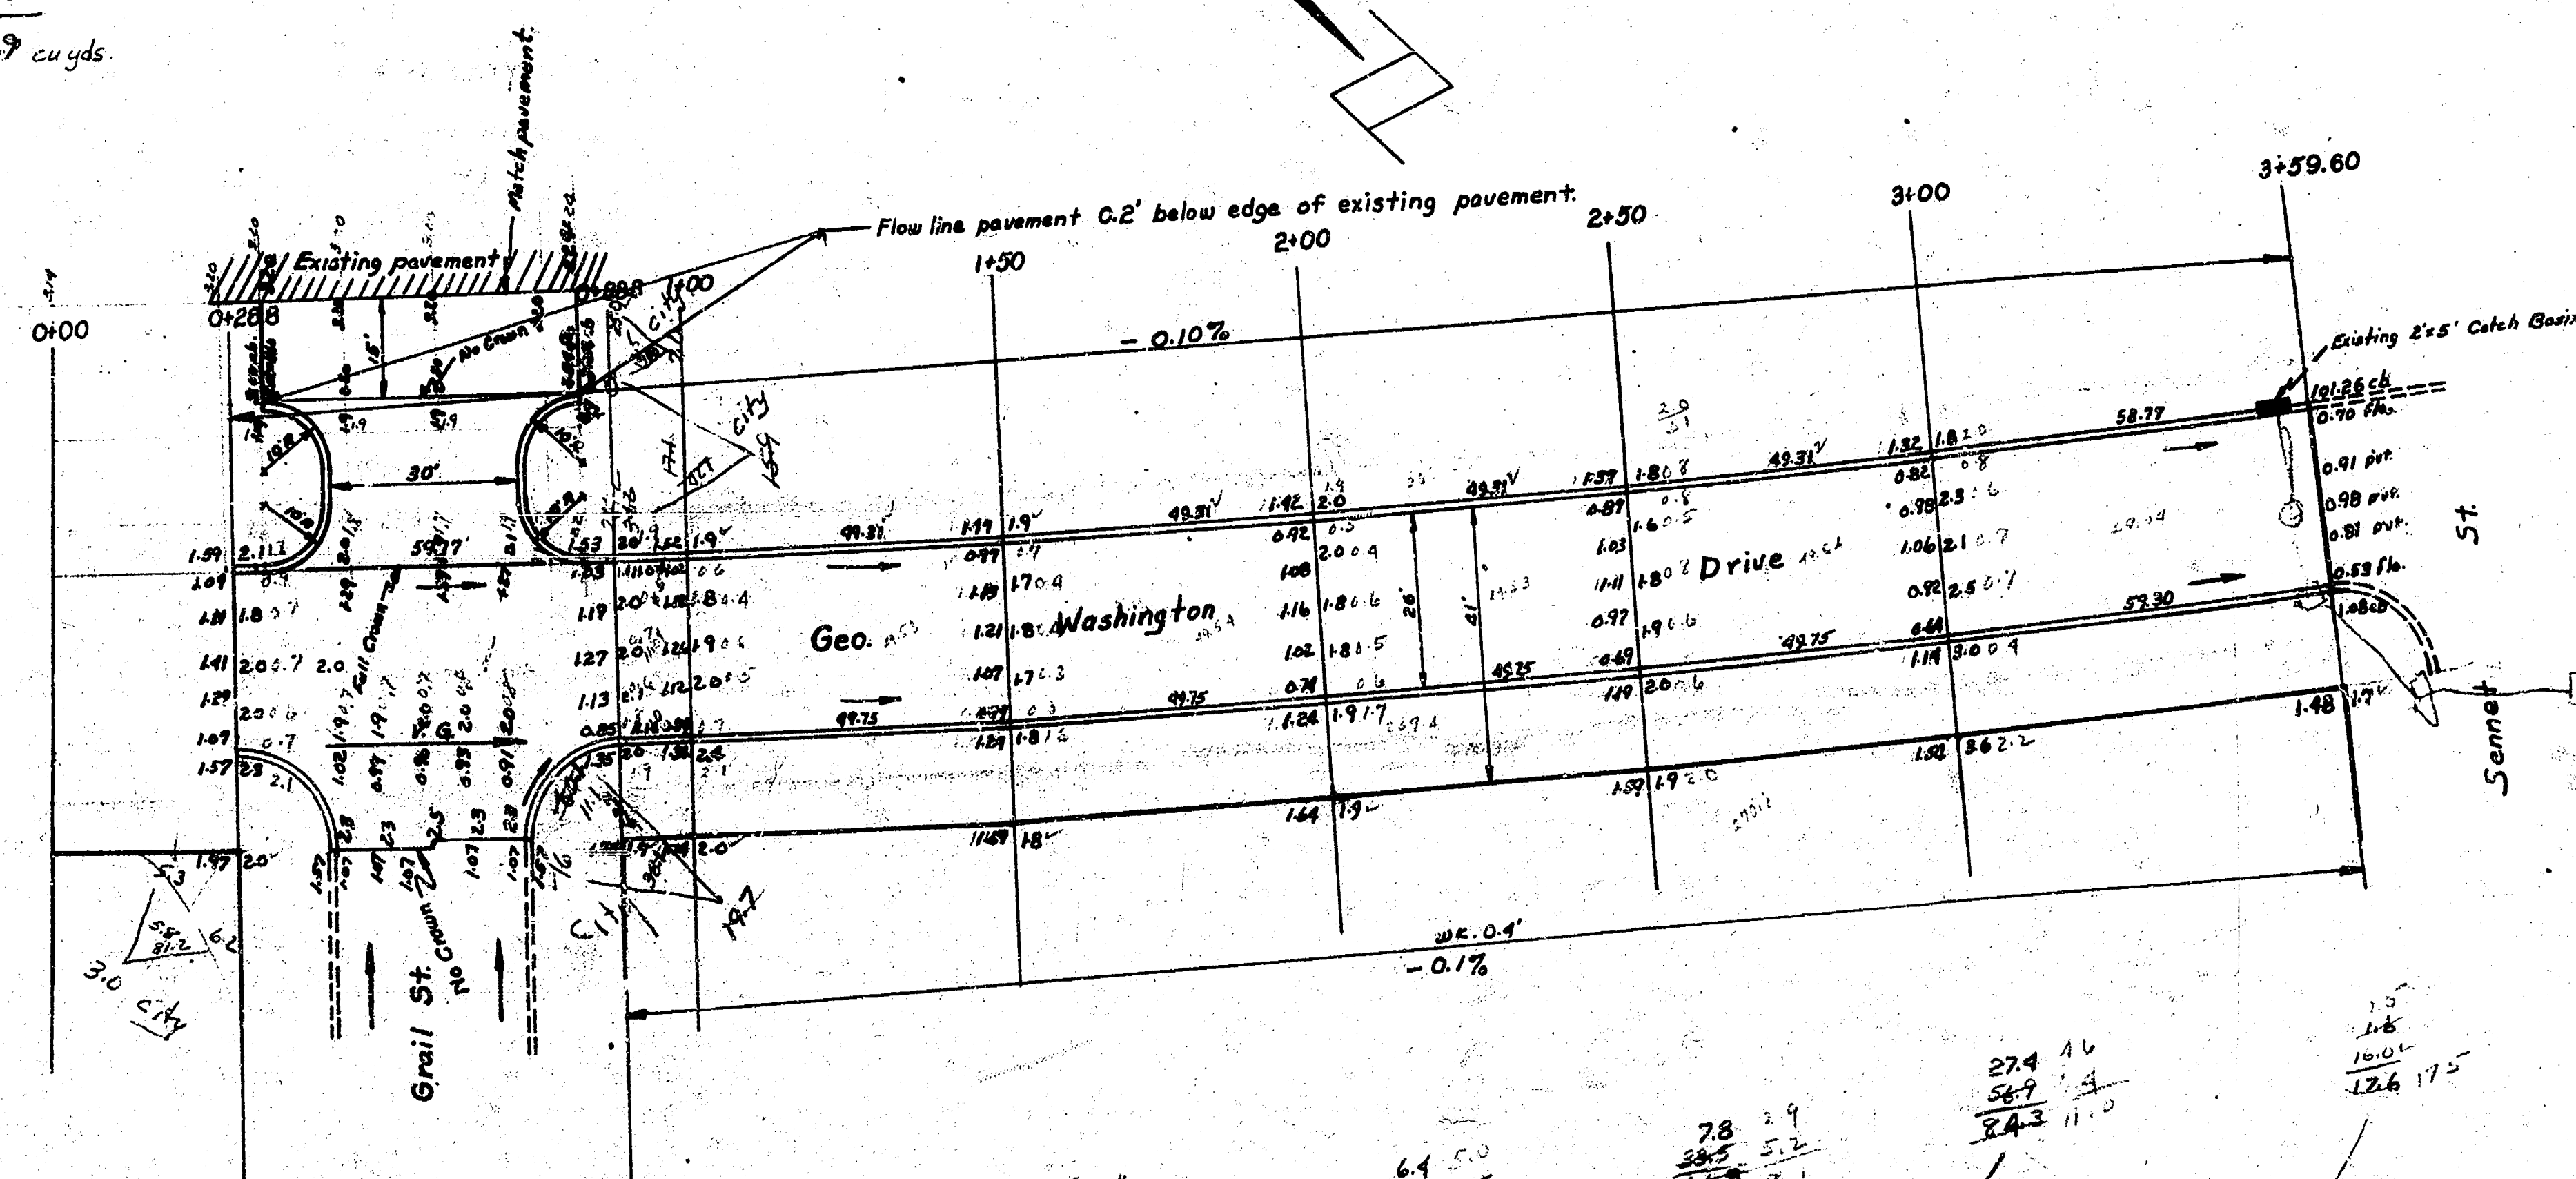

Re cross sectioned

GEO. WASHINGTON DRIVE
SL. Grail St. to SL. Sennet St.
26' Conc. & Cb.

City of Wichita, Kansas
L. K. White City Engineer
January 1951 Proj. No. C10-114.

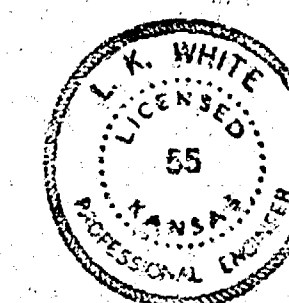

4 5 51