
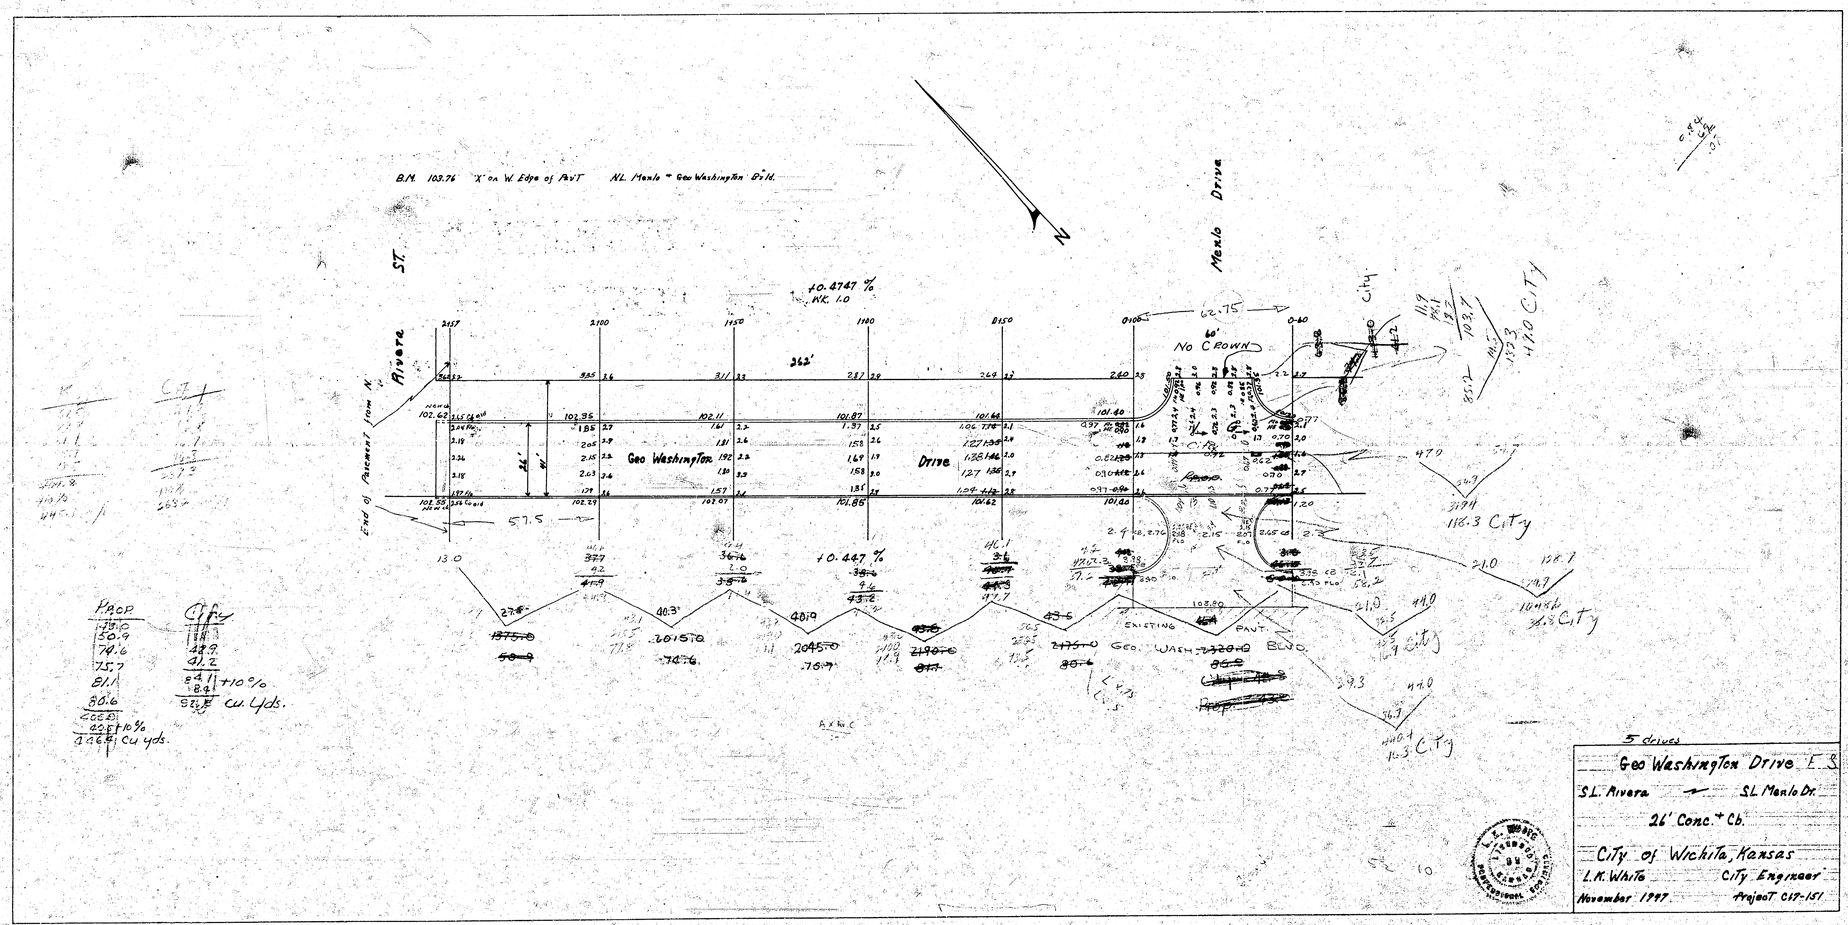


Prop.
75.0
50.9
76.6
75.7
81.1
80.6
400.9
40.1 +10%
440.9 cu yds.

City
118.3
42.9
91.2
84.1
84.1 +10%
92.5 cu. yds.

B.M. 103.76 'X' on W. Edge of Pavt NE. Manlo & Geo Washington Blvd.

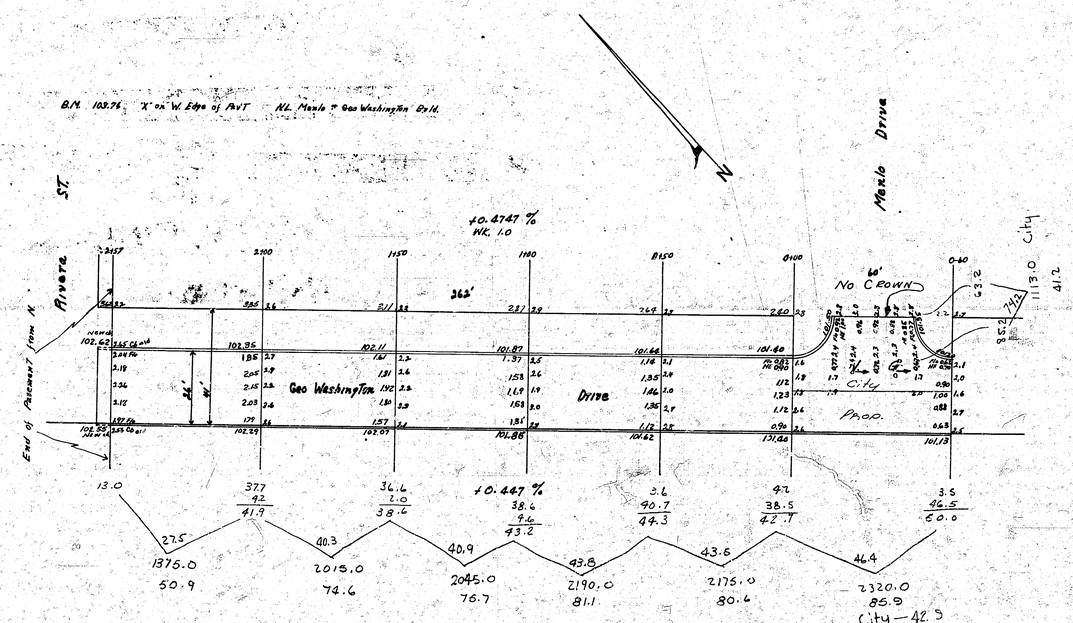

Prop.	City.
43.0	22.9
50.9	41.2
74.6	64.1 +10%
75.7	6.4
81.1	52.5 cu. yds.
86.6	
405.9	
405.1 +10%	
1467 cu. yds.	

5 drives

Geo Washington Drive

S.L. Rivera — S.L. Manlo Dr.

26' Conc. + Cb.

City of Wichita, Kansas

L.K. White City Engineer

November 1947 Project 617-151

4135 (e)