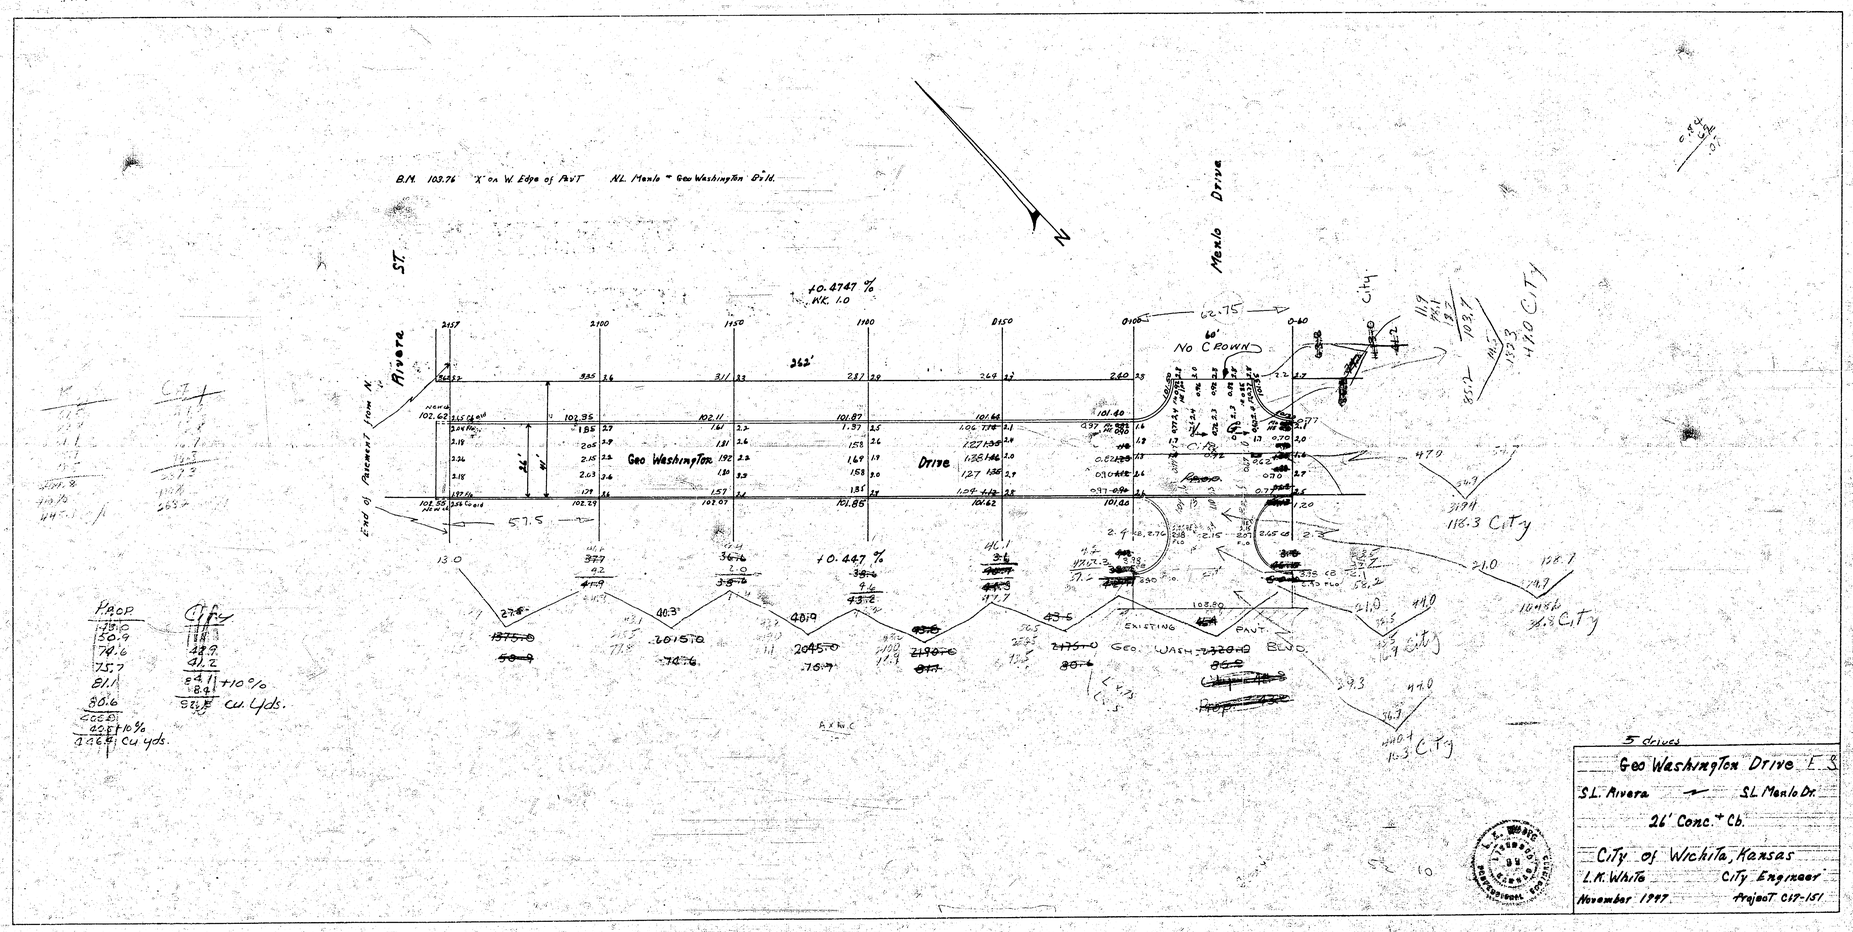
B.M. 103.76 X on W. Edge of Pavt N.L. Manlo ~ Geo Washington Bd.
Rivera ST.
Manlo Drive
Geo Washington Drive
End of Pavement from N.
+0.4747 %
N.K. 1.0
+0.447 %
262'
No Crown
60'
62.75
57.5
Existing Pavt.
Geo. Wash. Blvd.
Prop
City
+10%
cu. yds.
5 drives
Geo Washington Drive E.S.
S.L. Rivera ~ S.L. Manlo Dr.
26' Conc.+ Cb.
City of Wichita, Kansas
L.K. White City Engineer
November 1997 Project C17-151

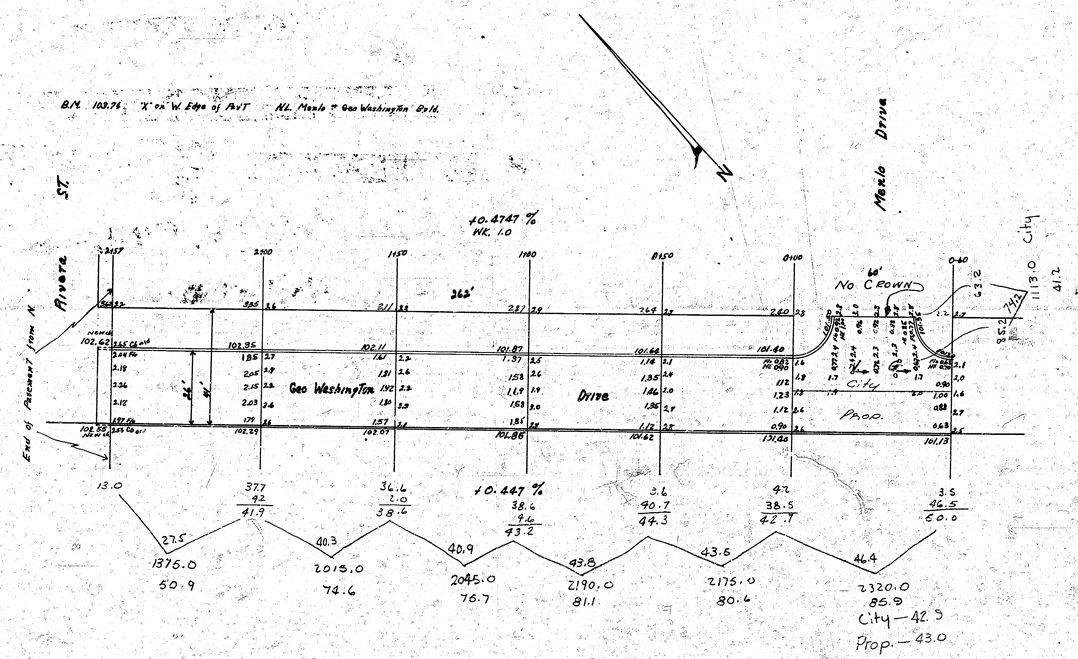

Prop.	City
43.0	
50.9	
74.6	22.9
75.7	41.2
81.1	64.1 +10%
86.6	6.4
405.9	92.5 cu. yds.
405.9 +10%	
446.4 cu. yds.	

5 drives

Geo Washington Drive


26' Conc. + Cb.

City of Wichita, Kansas

L.K. White — City Engineer

November 1997 — Project C17-151

4135 (e)