


146.50


2" = 50' Plan of Elvassar & Gilbert

Prop
 199.3
 392.8
 251.7
 396.2
 225.9
 43.2
 1507.1
 +10%
 Total 1660.0 Cu. Yds

City
 80.9
 30.1
 28.8
 139.8
 +10%
 Total 153.8 Cu. Yds.

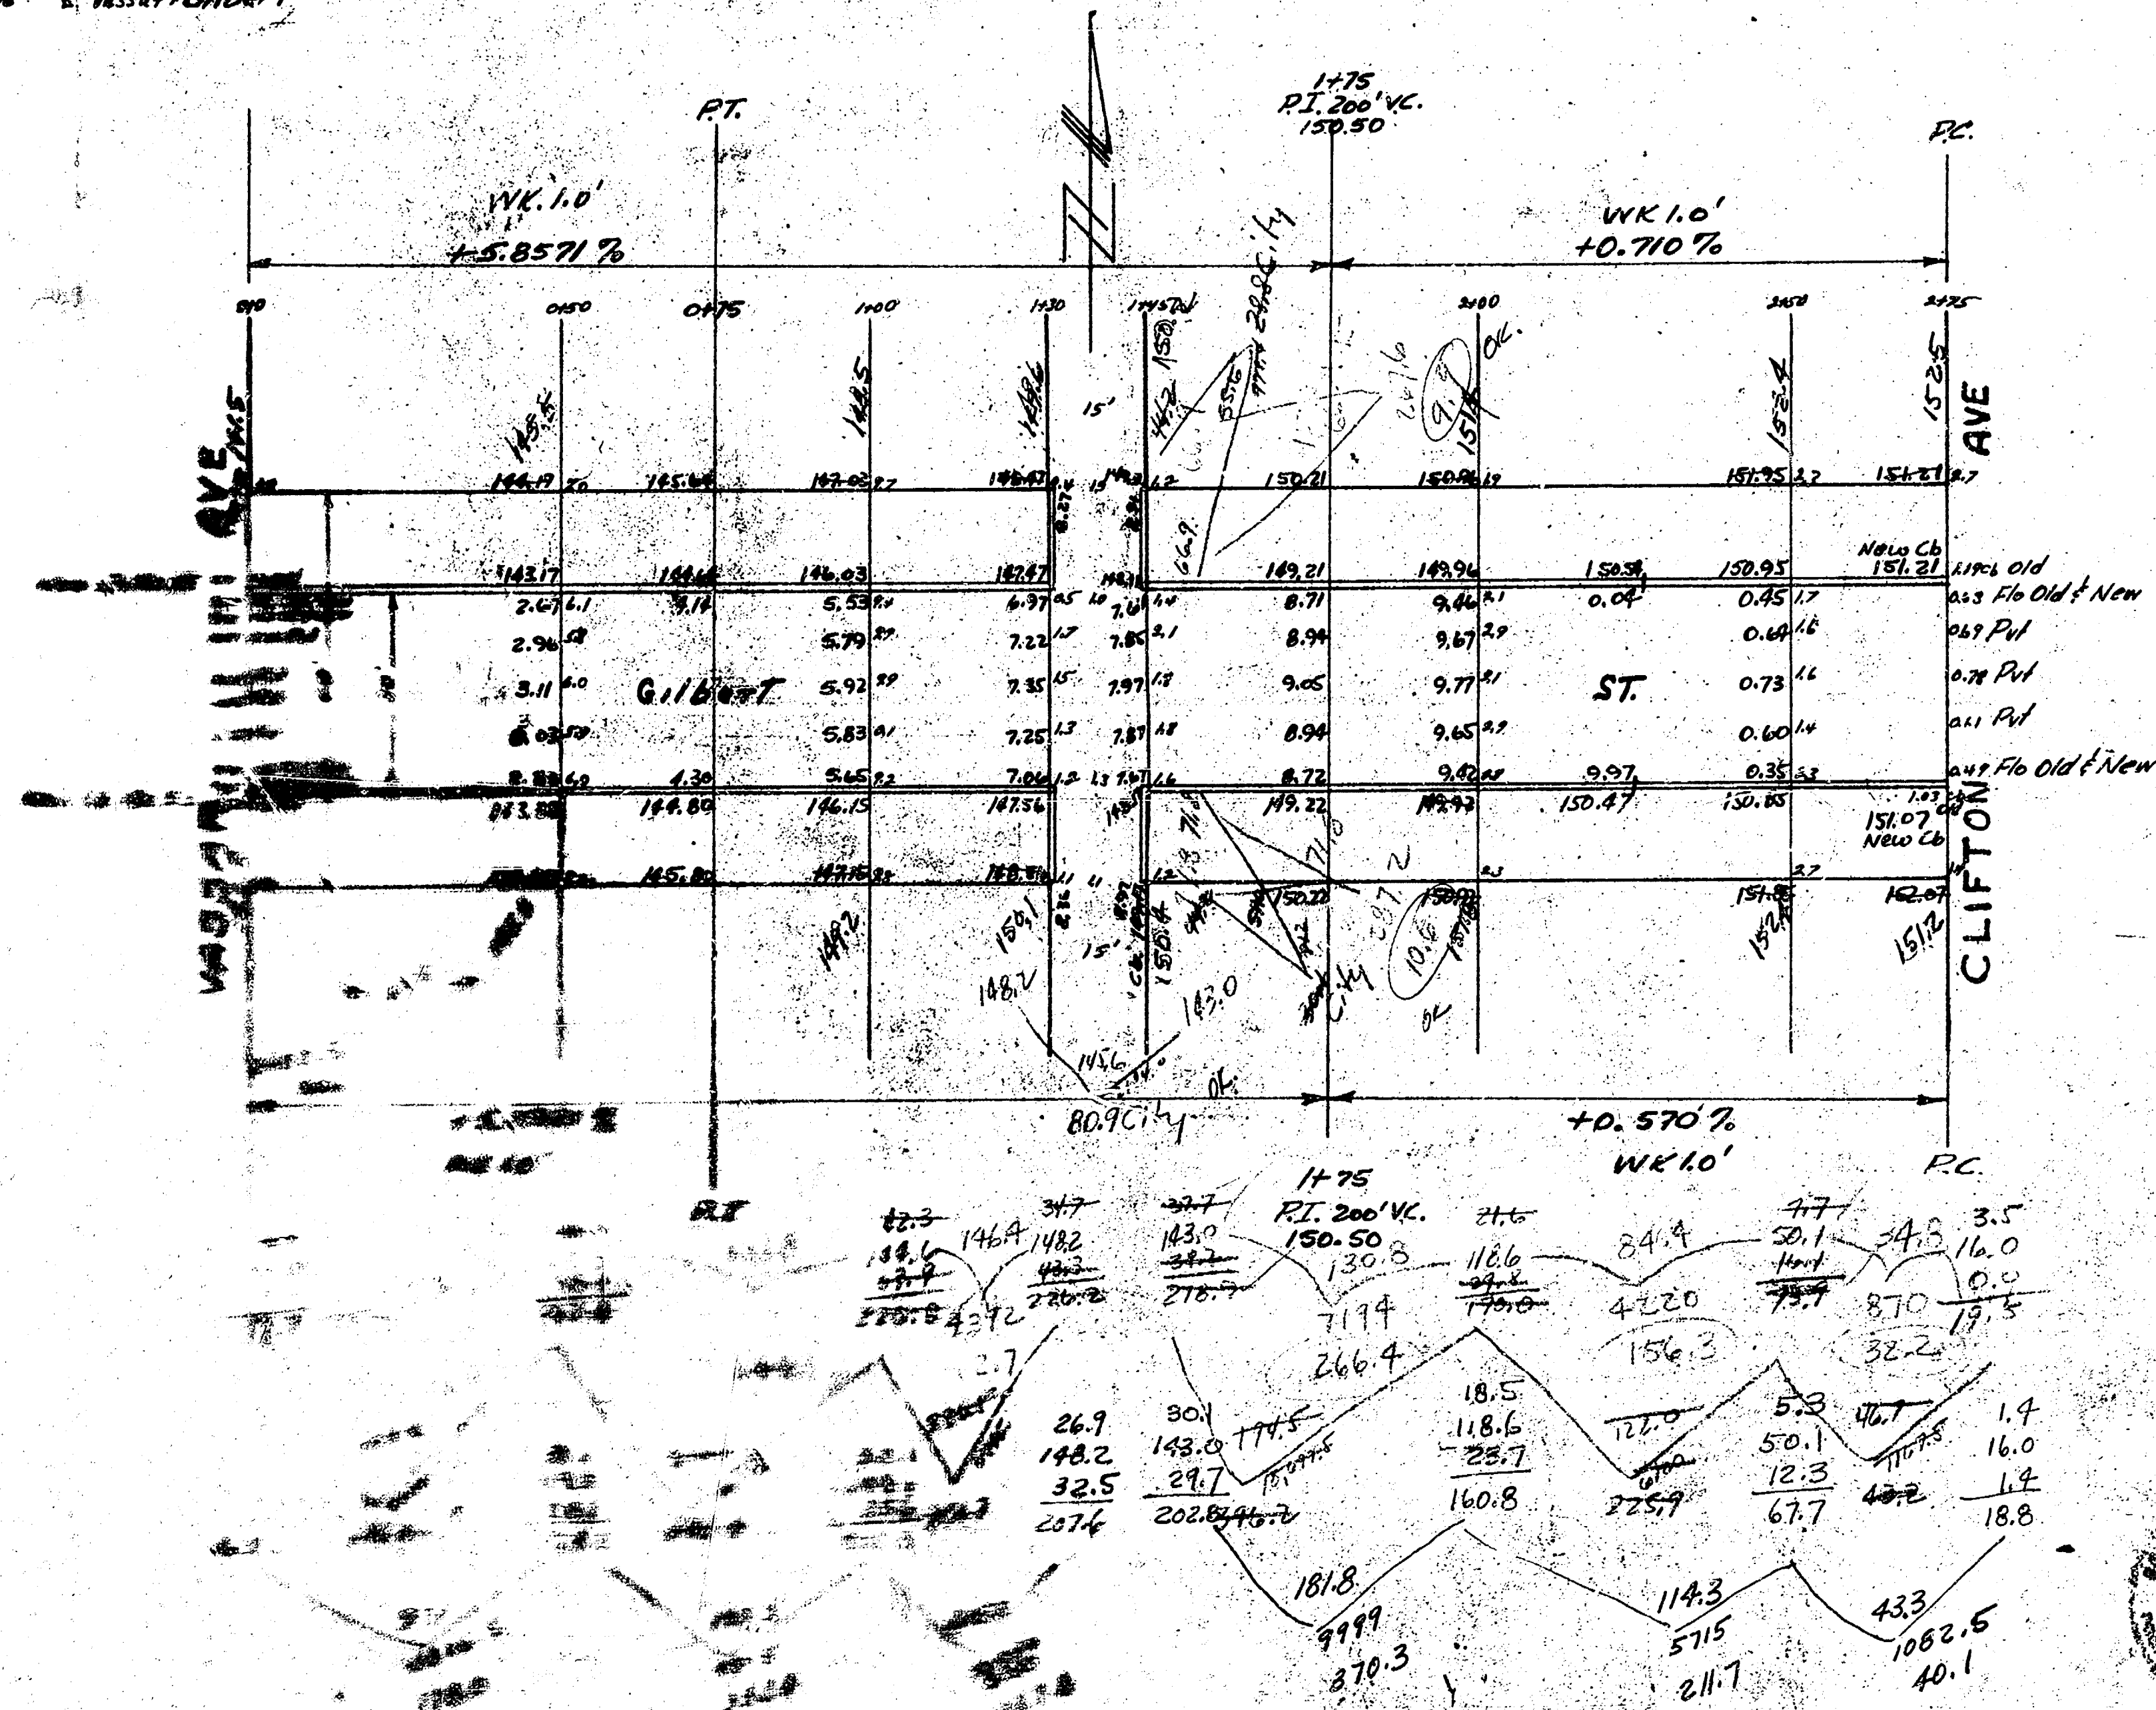


GILBERT
 ELVASSAR - W.L. CLIFTON
 30' Conc. & Curb
 City of Wichita Kansas
 LKWHITE City Engineer
 Proj C10-32

 

B.M. 138.21 N. Arm of Thimble * Vassar / Gilbert

Prop
191.9
385.4
251.7
396.2
225.9
43.2
1494.5
+10%
Total 1643.7 Cu. Yds

City
80.9
30.1
28.8
139.8
+10%
Total 153.8 Cu. Yds.

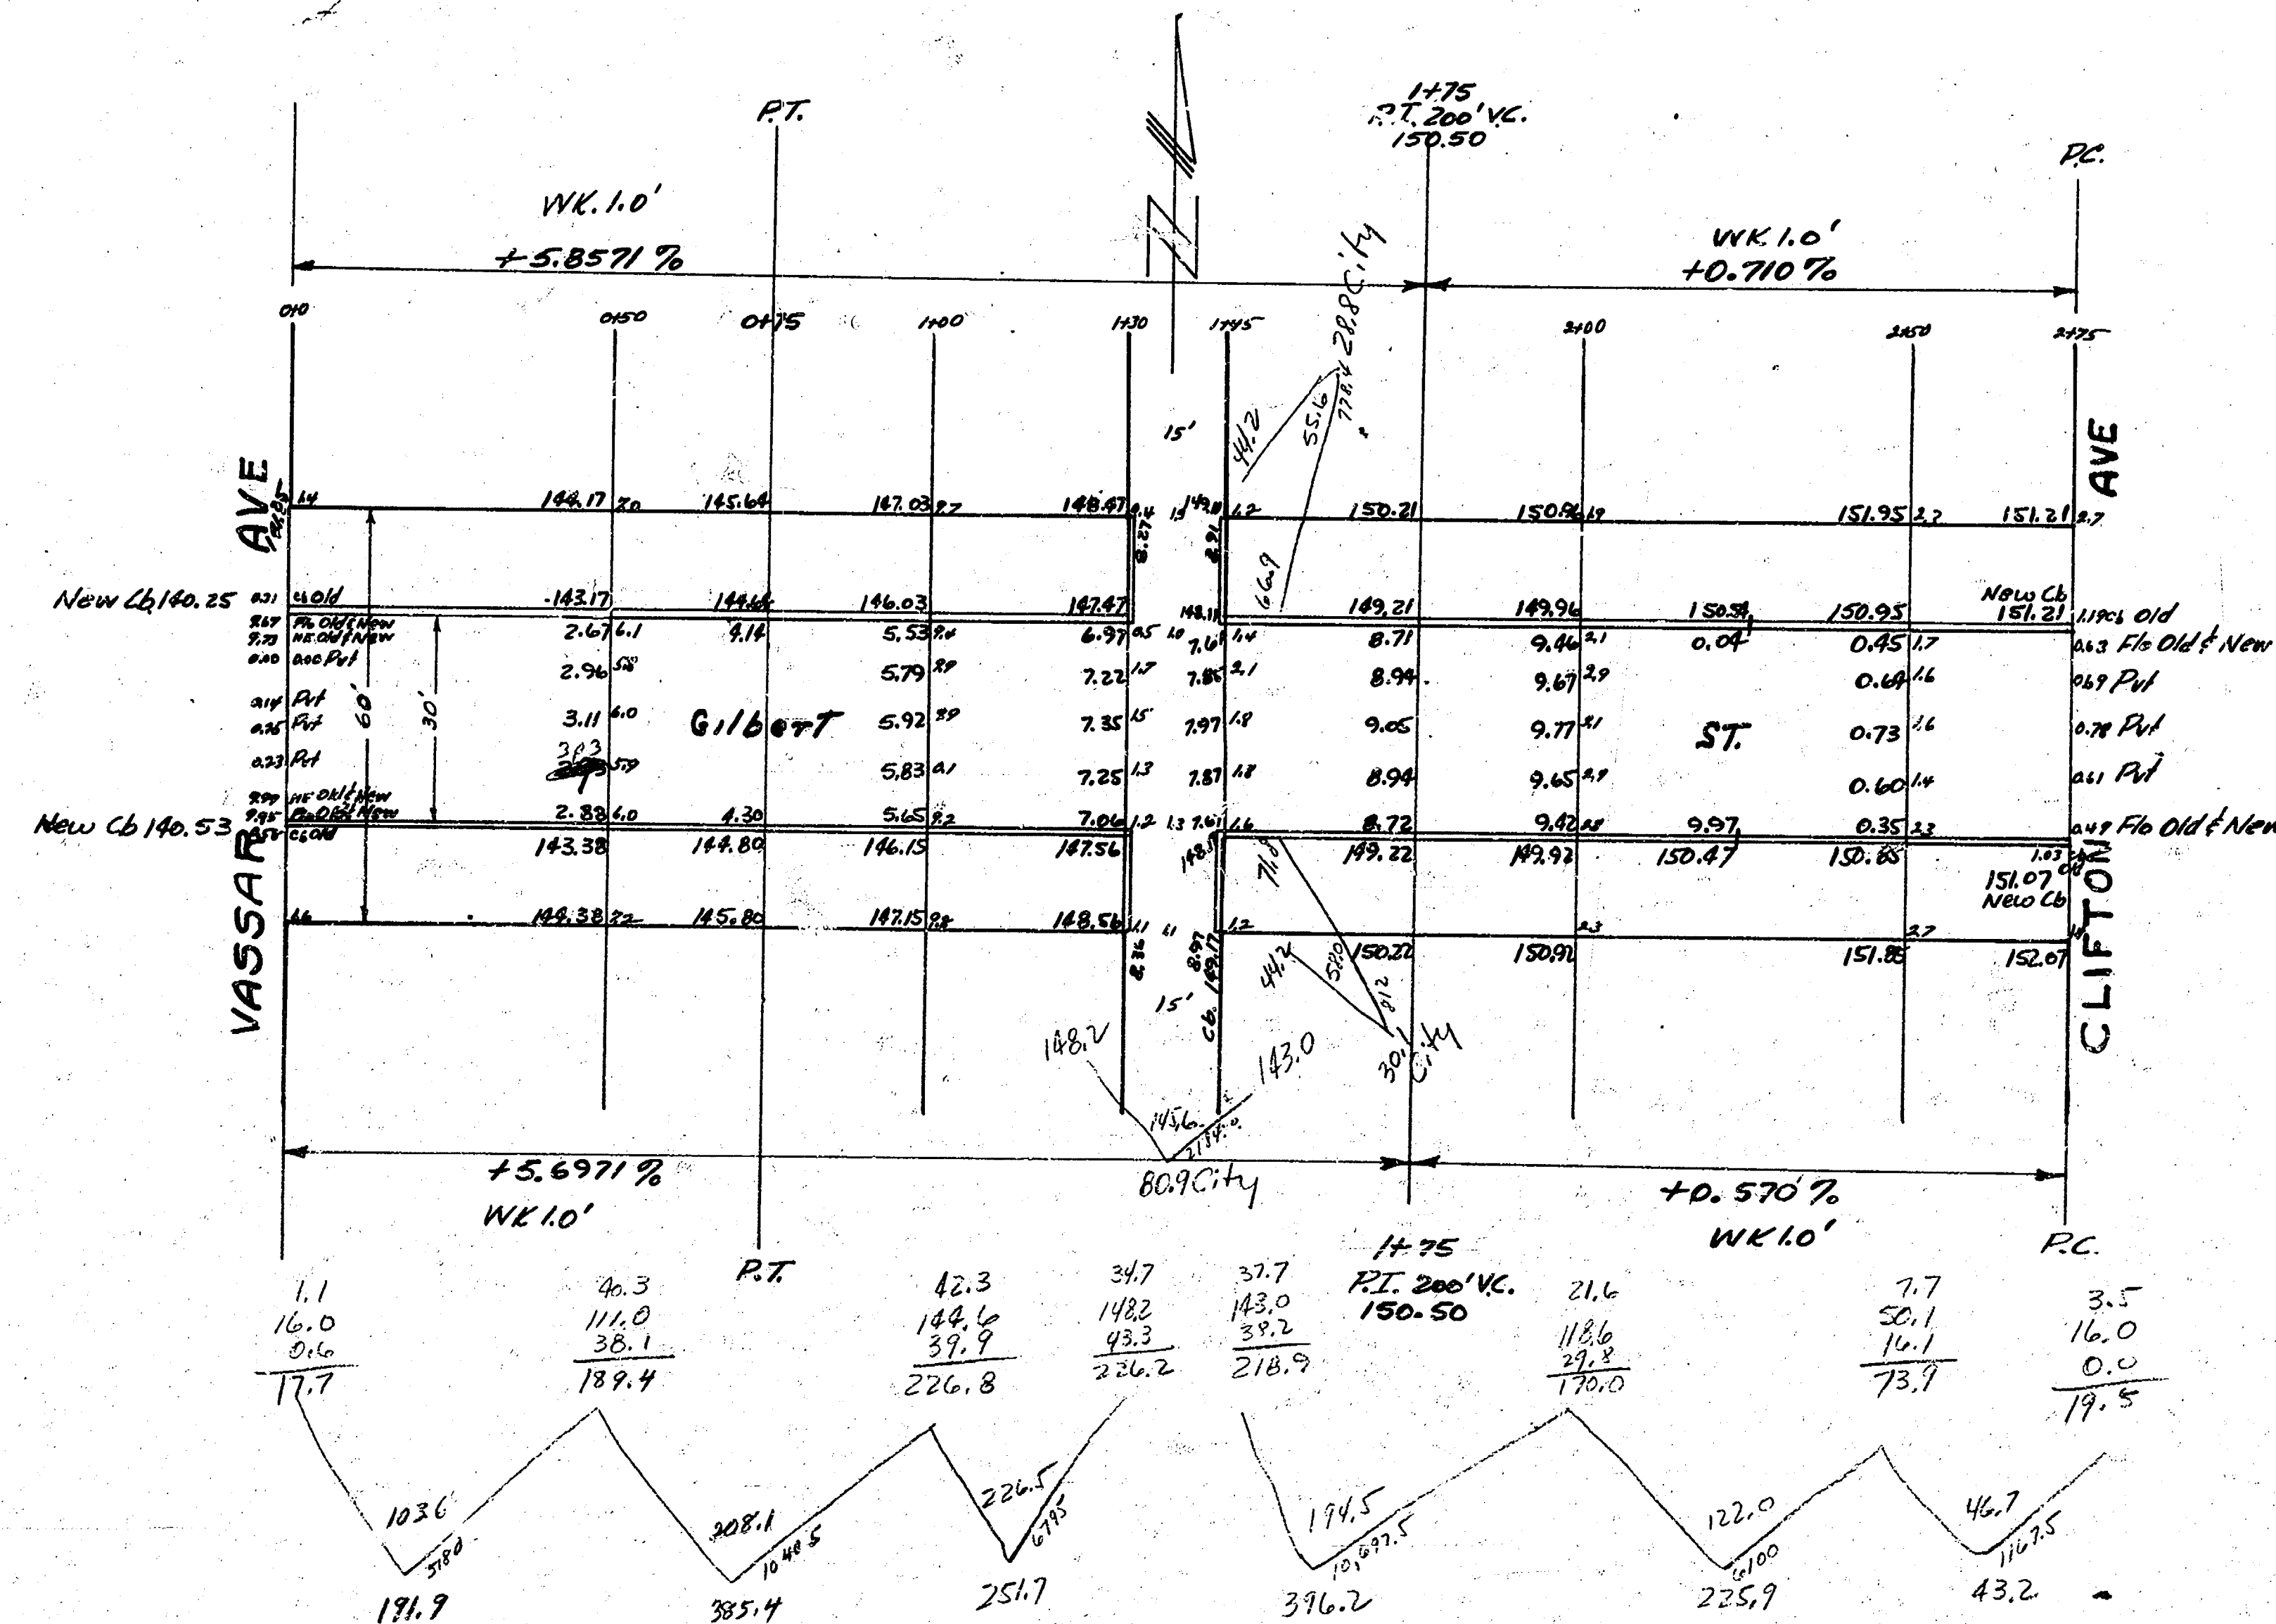

GILBERT
EL VASSAR - WL. CLIFTON
30' Conc. & Curb
City of Wichita Kansas
LK WHITE City Engineer
Proj C-18-32

4 13 3 10