


BM: 157.17 SE cor conc. porch Ho* 8032 E. Indianapolis.
Stationing on N Prop Line.

NOTICE TO CONTRACTOR & FIELD ENGINEER:-
From Sta. 1+00 to 6+00 cut a 3' berm south of edge of slab then
slope bank of a 3 to 1 slope. Take final cross-sections when
cut is completed. Install asphalt Hook-up of Rock Road.

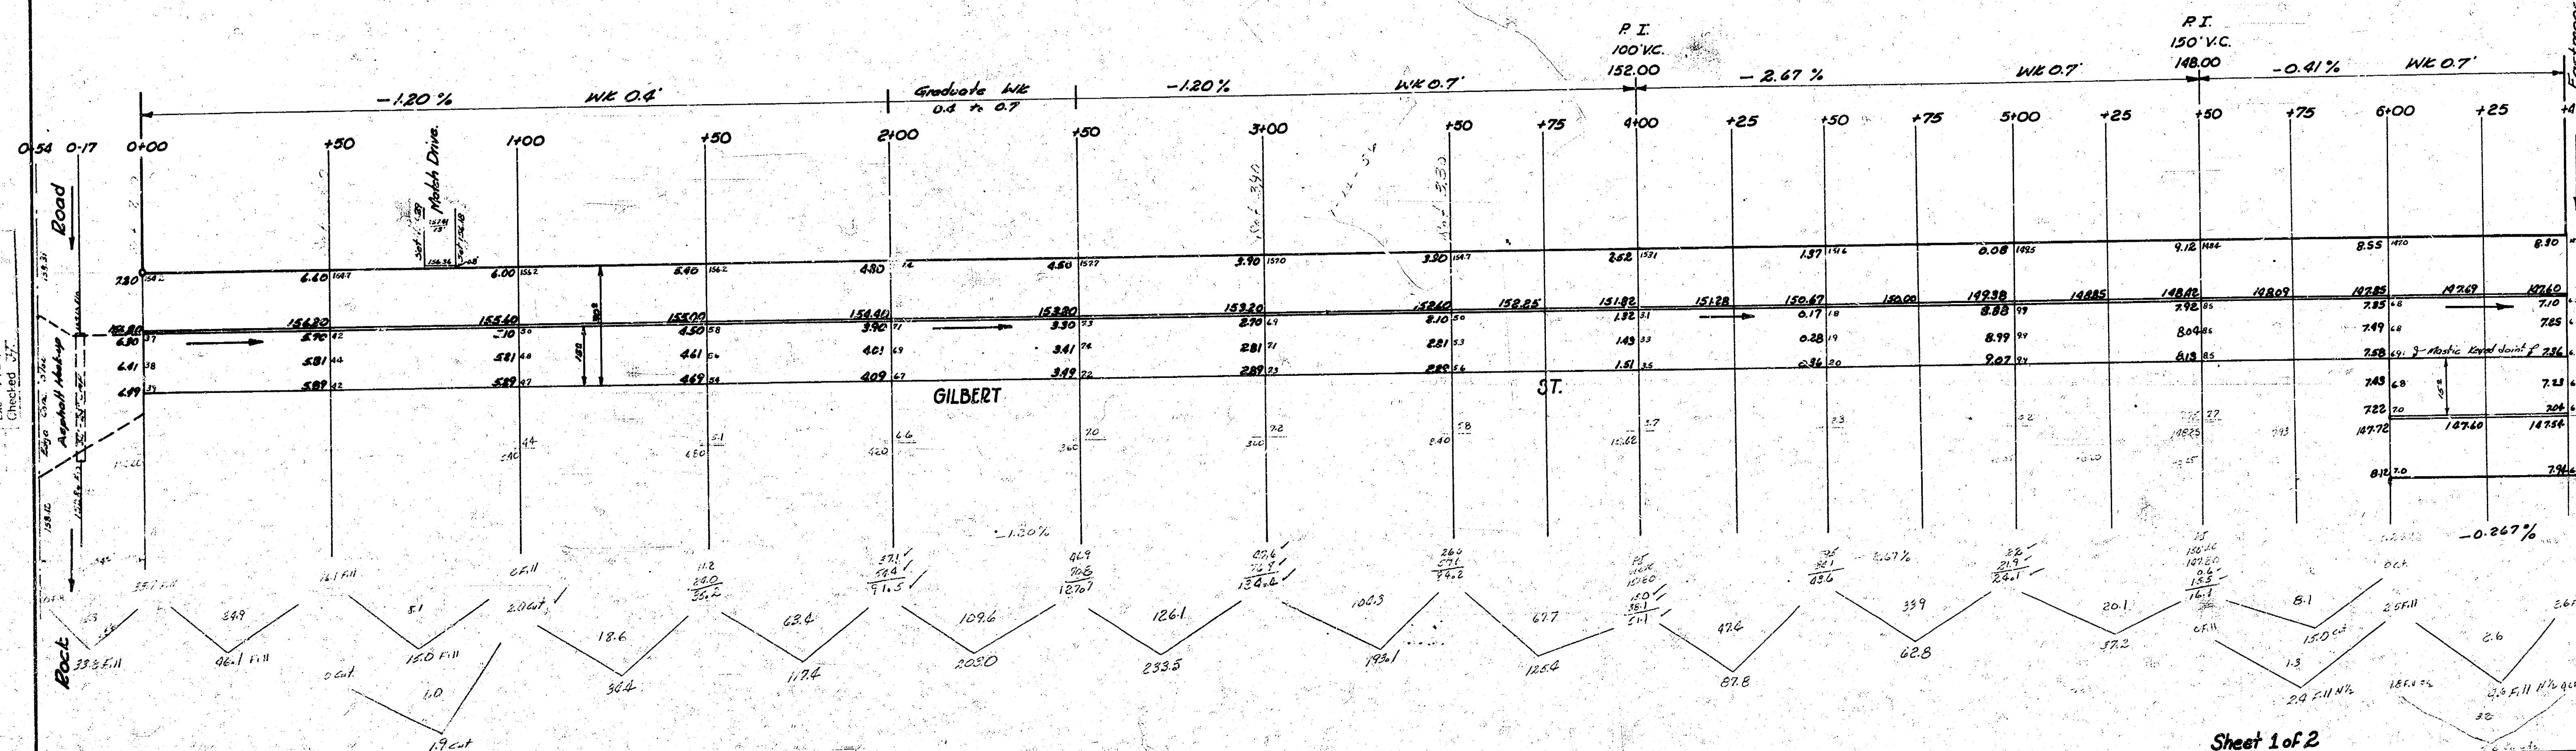

Excavation Totals


5' Excavation
Property
110' 6" 6.2 cu yds
5' 10" 5.0 cu yds

S/2 GILBERT ST. Sta. 6+00 to WL Eastmoor 15' Conc. & Cb. PRIVATE JOB.	N/2 GILBERT ST. EL Rock Road to WL Eastmoor 15' Conc & Cb. CITY OF WICHITA, KANSAS B.E. SMITH CITY ENGINEER Oct 1956 PROJ NO C15-121
---	---

