


Gilbert E.L. Erie W.L. Chautauqua
30' $\frac{1}{2}$ Curb Concr.

B.M. Elev. 106.64 K in Kensler C. App. Wk. 8 S 26 Gilbert E.S. Err.

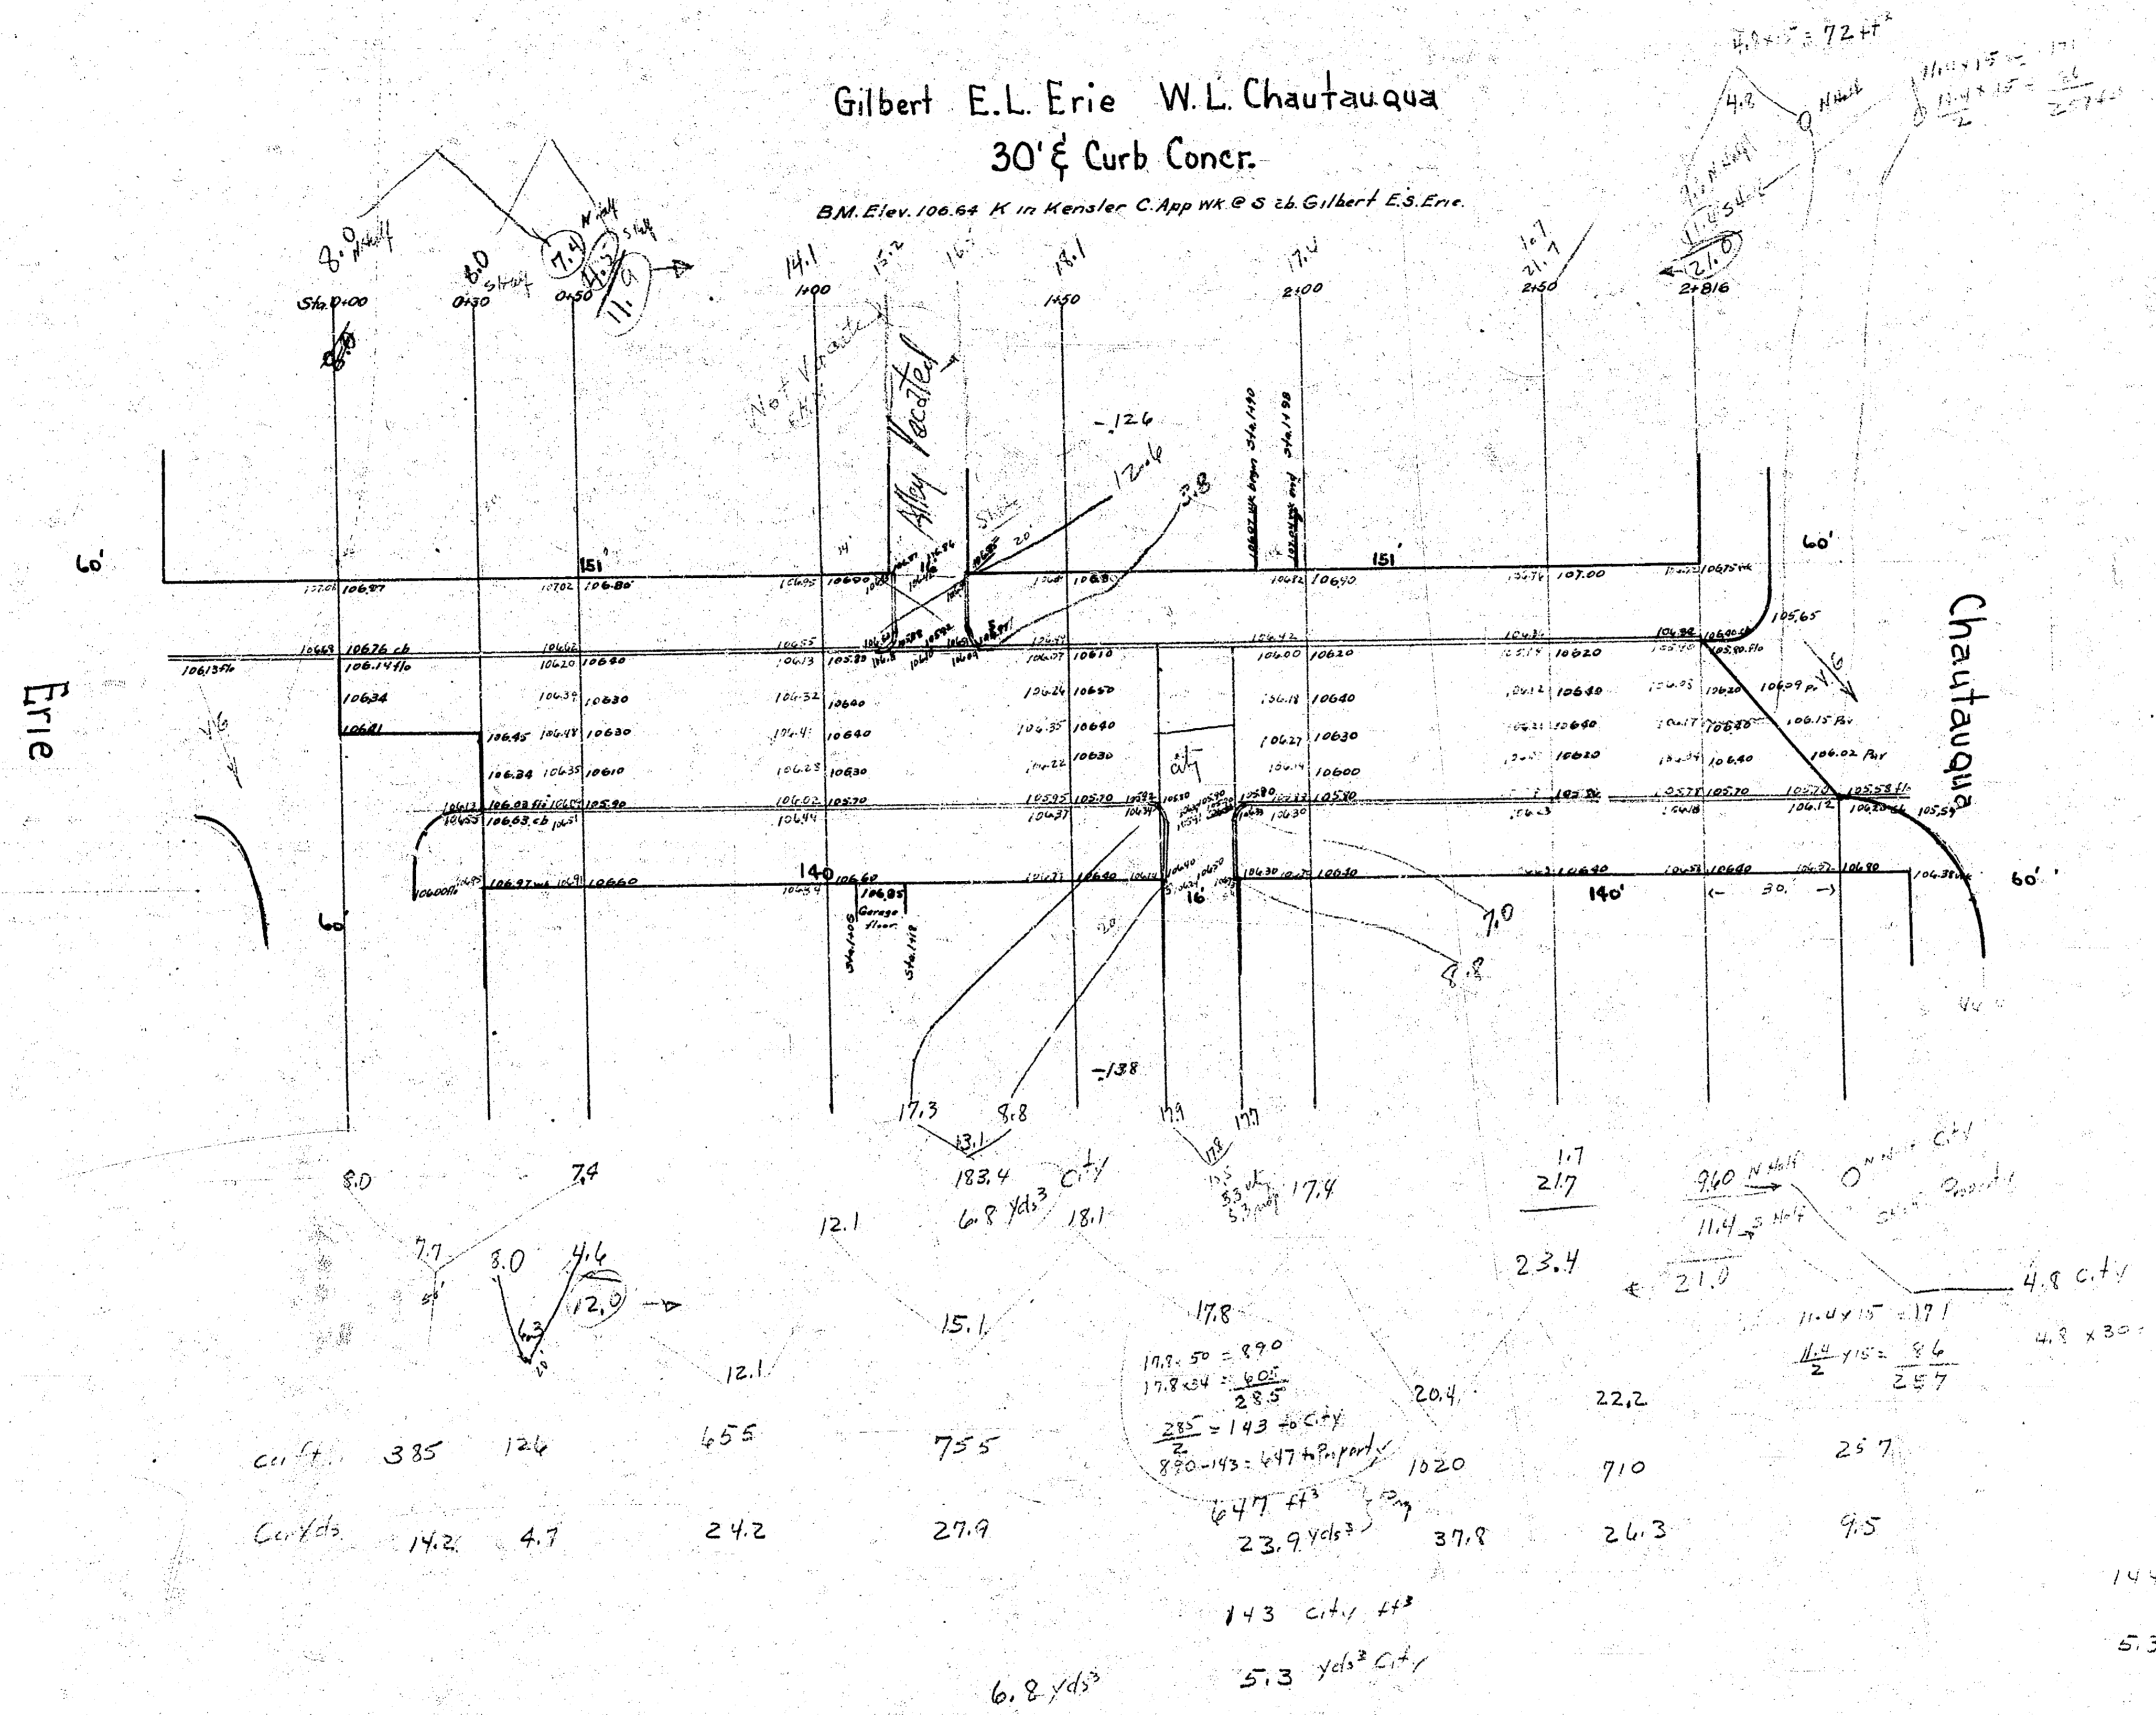

Plan
1940
Gilbert
E.L. Erie
W.L. Chautauqua