


Gilbert - El Holyoke to Mt. Rubin

How does this meet
downways p. 25

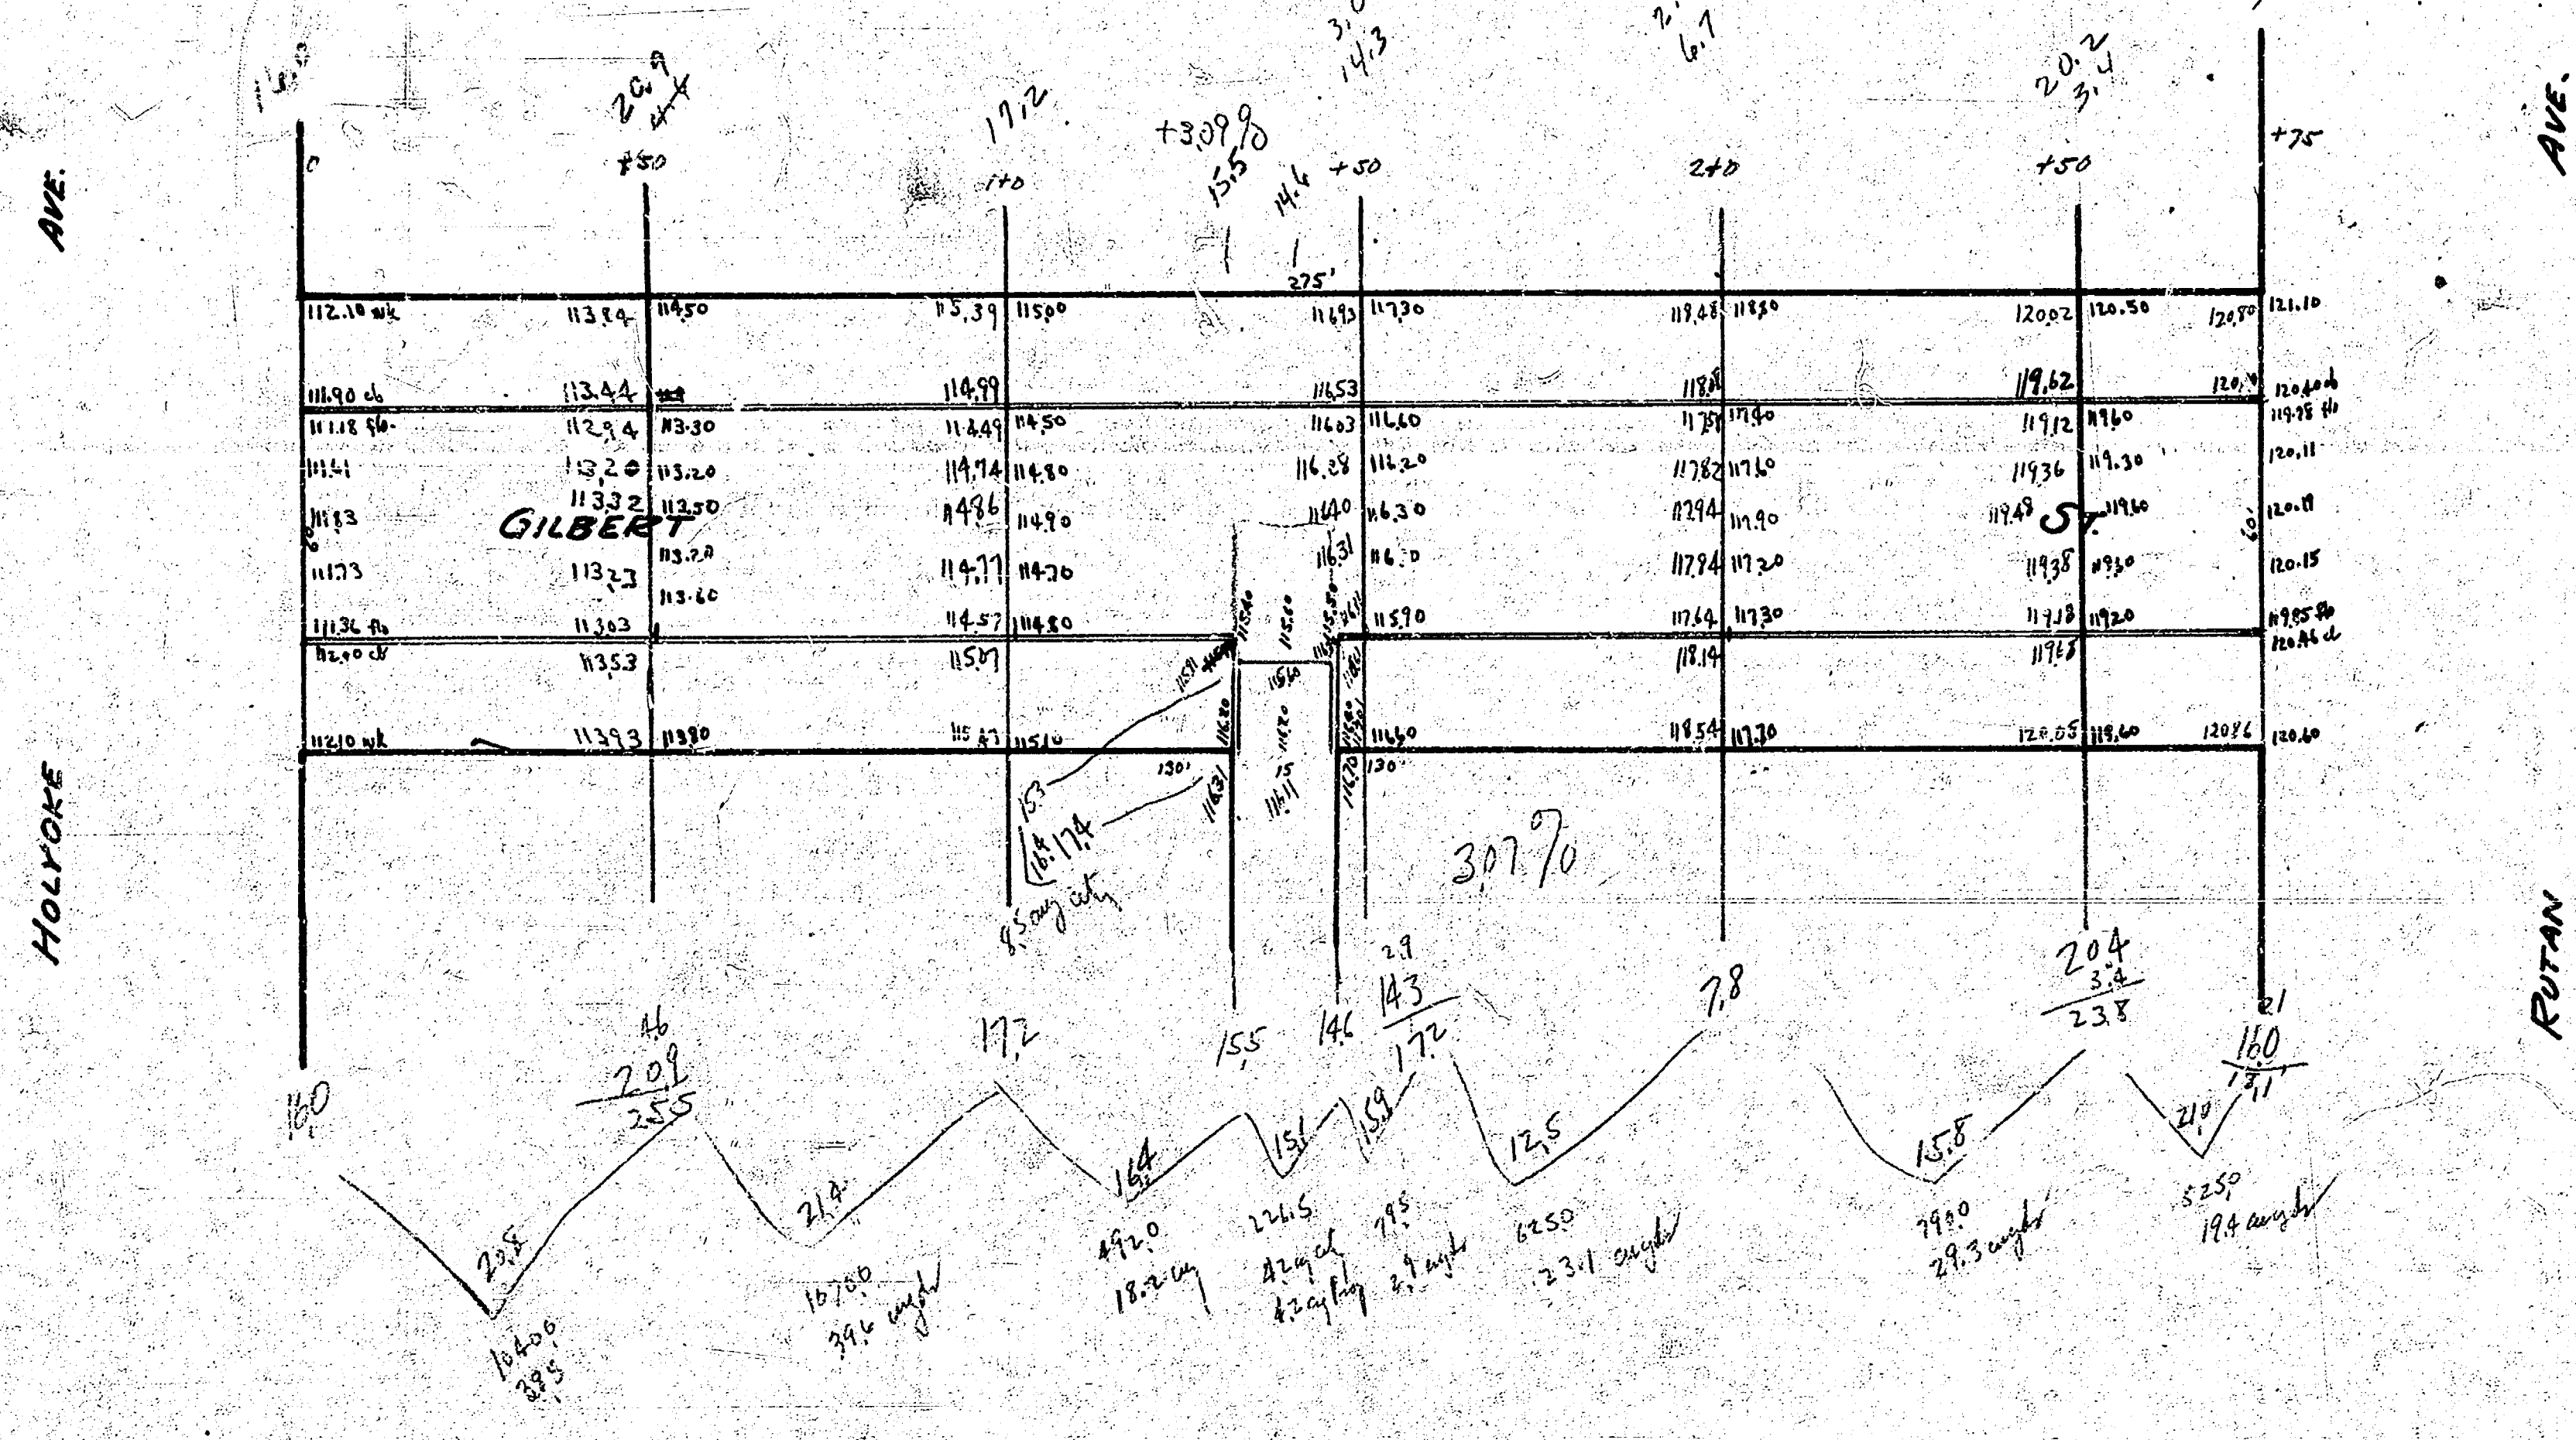

$$\begin{aligned} \text{Avg} &= 175.2 + 175 = 175.1 \text{ avg} \\ \text{chk} &= 12.7 + 1.3 = 14.0 \text{ avg} \\ &= 206.7 \end{aligned}$$

B.M. Elevation 106.75 Top of Hill, W.S. Hillside, C. Morris W
108.47 "8" in boundary ch. not W. S.W. Hillside, & hills