


Final Estimate shown
not include parking expansion
see meeting Nov 2nd 1940

Gilbert E.L. Poplar W.L. Green
30' ± Curb Concr.

BM Elev. 105.82 T in Thackeray Frk Wks SW Corner Gilbert
106.07 W in Whaley at S. E. Gilbert E.L. Poplar
106.77 K in Keeler C App. W. of N.W. Gilbert E.L. Green
106.01 N. Lim Lefever, C. W. N. N.W. Gilbert & Volusia

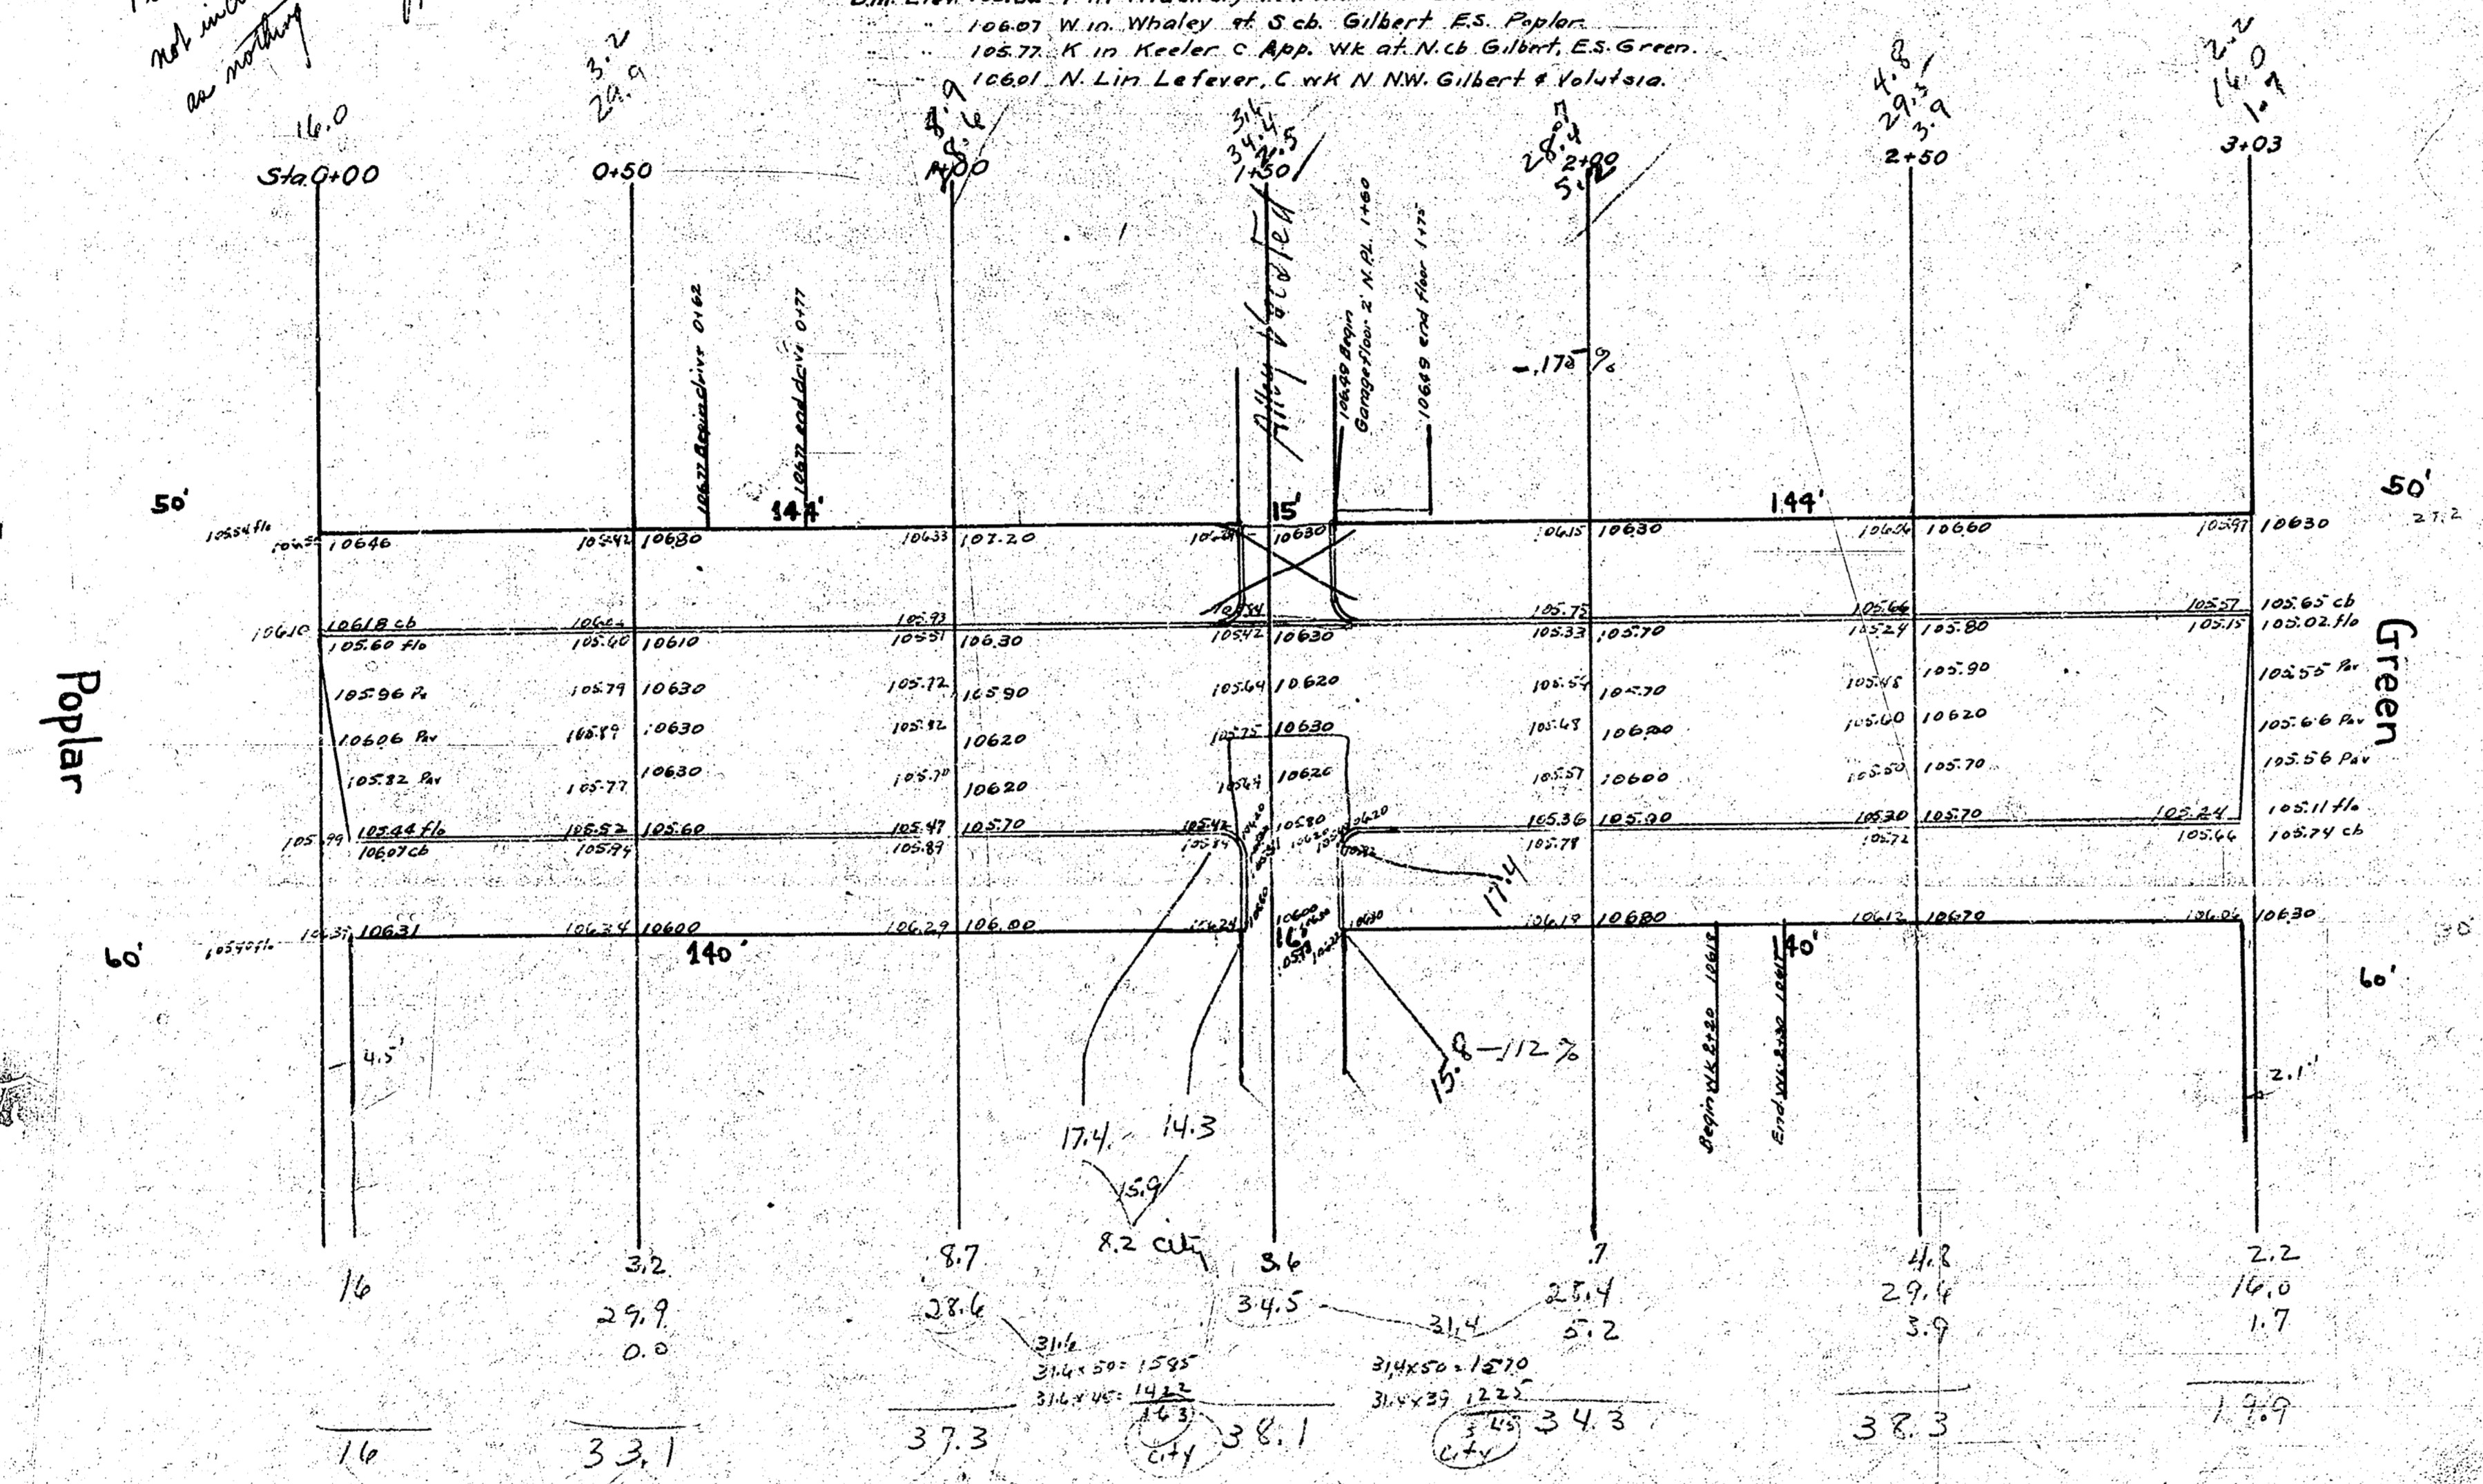

Prop City
 $359.0 + 25.9 = 384.9$ mgt
 $17.6 + 1.8 = 19.4$ mgt

Paving Plan
1940
Gilbert -
W.L. Green
E.L. Poplar

16	3.2	9.7	8.2 cut	5.6	7	4.2	2.2
16	29.9	38.6	31.4	34.5	25.4	29.4	16.0
16	0.0	37.3	31.4 + 2.0 = 33.4	31.4 + 2.0 = 33.4	5.2	5.9	1.7
16	33.1	37.3	38.1	34.3	38.3	38.3	1.7
24.6	35.2	37.7	36.2	36.3	29.1		
116.5	17.60	189.5	181.0	186.5	145.0		
43.6	65.2	163	60.7	69.0	53.7		
		6.0	12.8				
		3.0 cut	6.4 cut				

Prop City
 $349.6 + 35.0 = 384.6$
 $17.6 + 1.8 = 19.4$
 $384.6 + 19.4 = 404.0$ Total Exc.