
Book 38Y Pages 21-22

B.M. 1443.1 Bolt N.S. Elm Tree 100' W & 50' N of N.W. Cor. Elpyco of Larry Lane

ELEVATION	
PROP.	CITY
107.2	0
77.6	
55.0	
26.1	
28.9	
36.9	
39.6	
61.7	
78.2	
77.2	
90.9	
103.1	
102.0	
126.3	
88.9	
77.8	
1152.2	
+10%	
1267.4	ELEV.

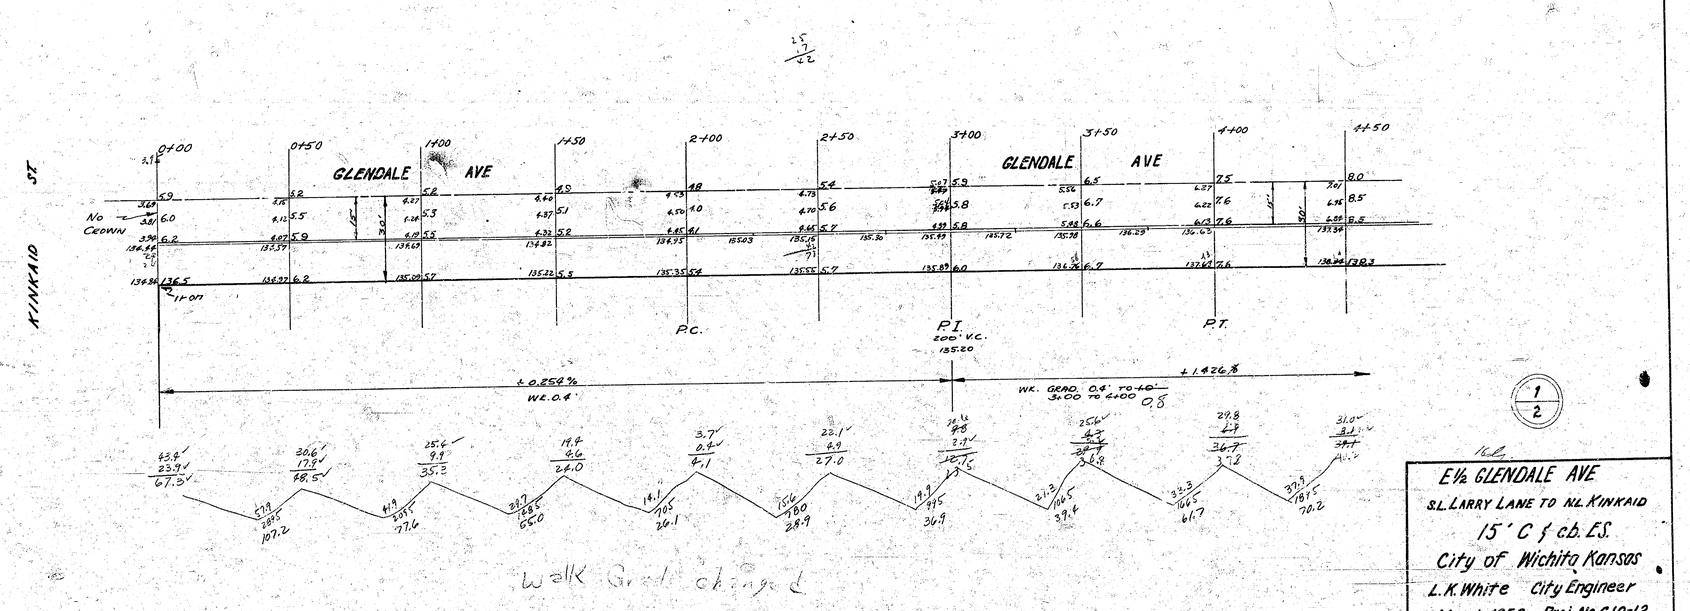


Walk Grade changed

E½ GLENDALE AVE
S.L. LARRY LANE TO N.L. KINKAID
15' C & cb. E.S.
City of Wichita Kansas
L. K. White City Engineer
March, 1950 Proj No C10-12

Book 381 Pages 21-22


N

B.M. 144.31 Bolt N.S. Elm Tree 100'W & 50'N. of N.W. Cor. Elysco & Larry Lane

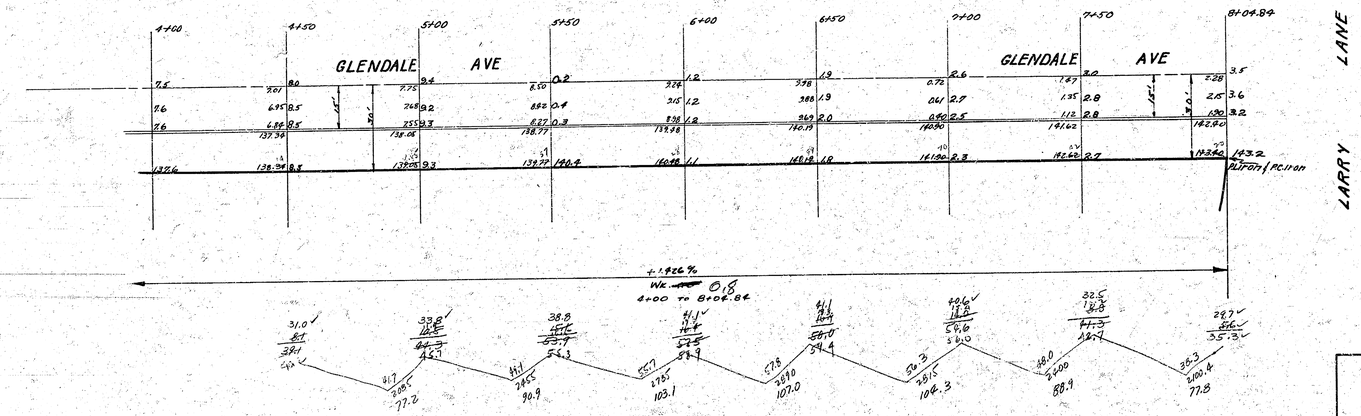


2/2

4 2 4 11

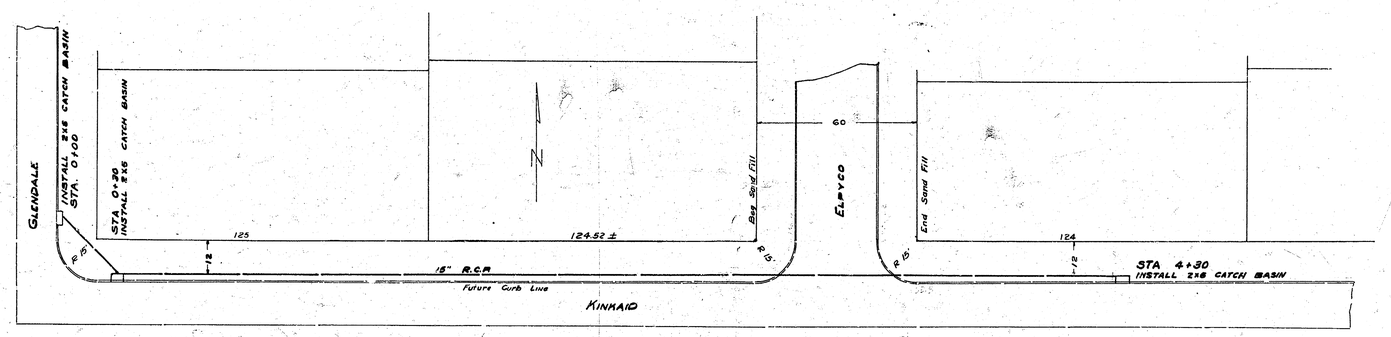

NOTE: Catch Basin at Sta 4+30 not to be installed until Kinkaid Ave. is paved

B.M. 134.37 TOP OF CURB E. SIDE GLENDALE N.L. KINKAID

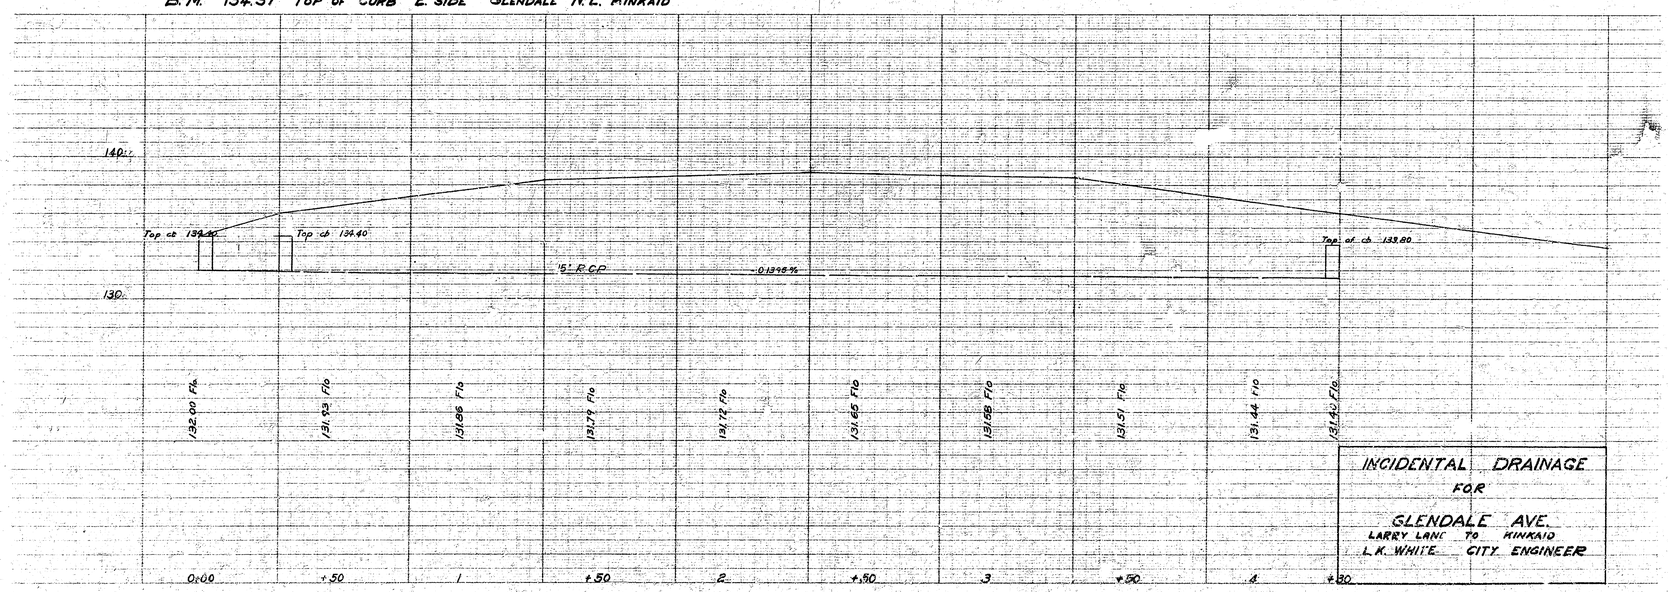

INCIDENTAL DRAINAGE
FOR
GLENDALE AVE.
LARRY LANE TO KINKAID
L.K. WHITE CITY ENGINEER

(11) 4 5 4