Glendale — SE Kellogg to N.C. Watermain

B.M. Elev. Sheet Asph. Black Base — Only

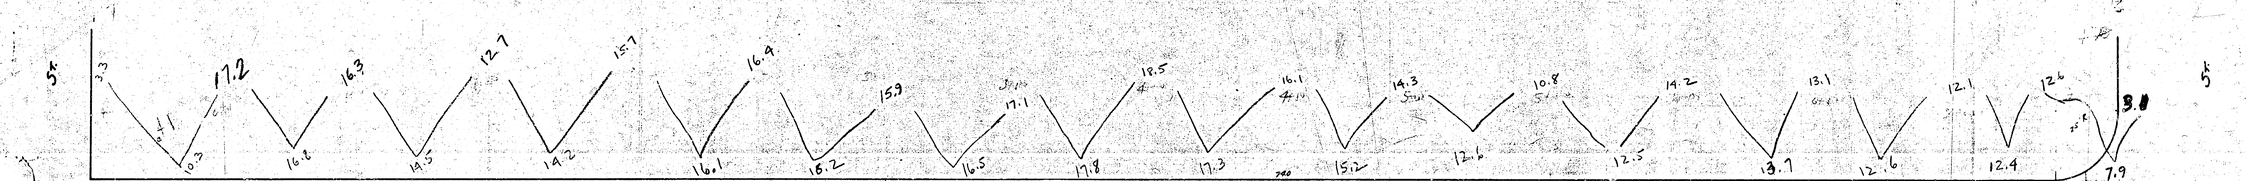

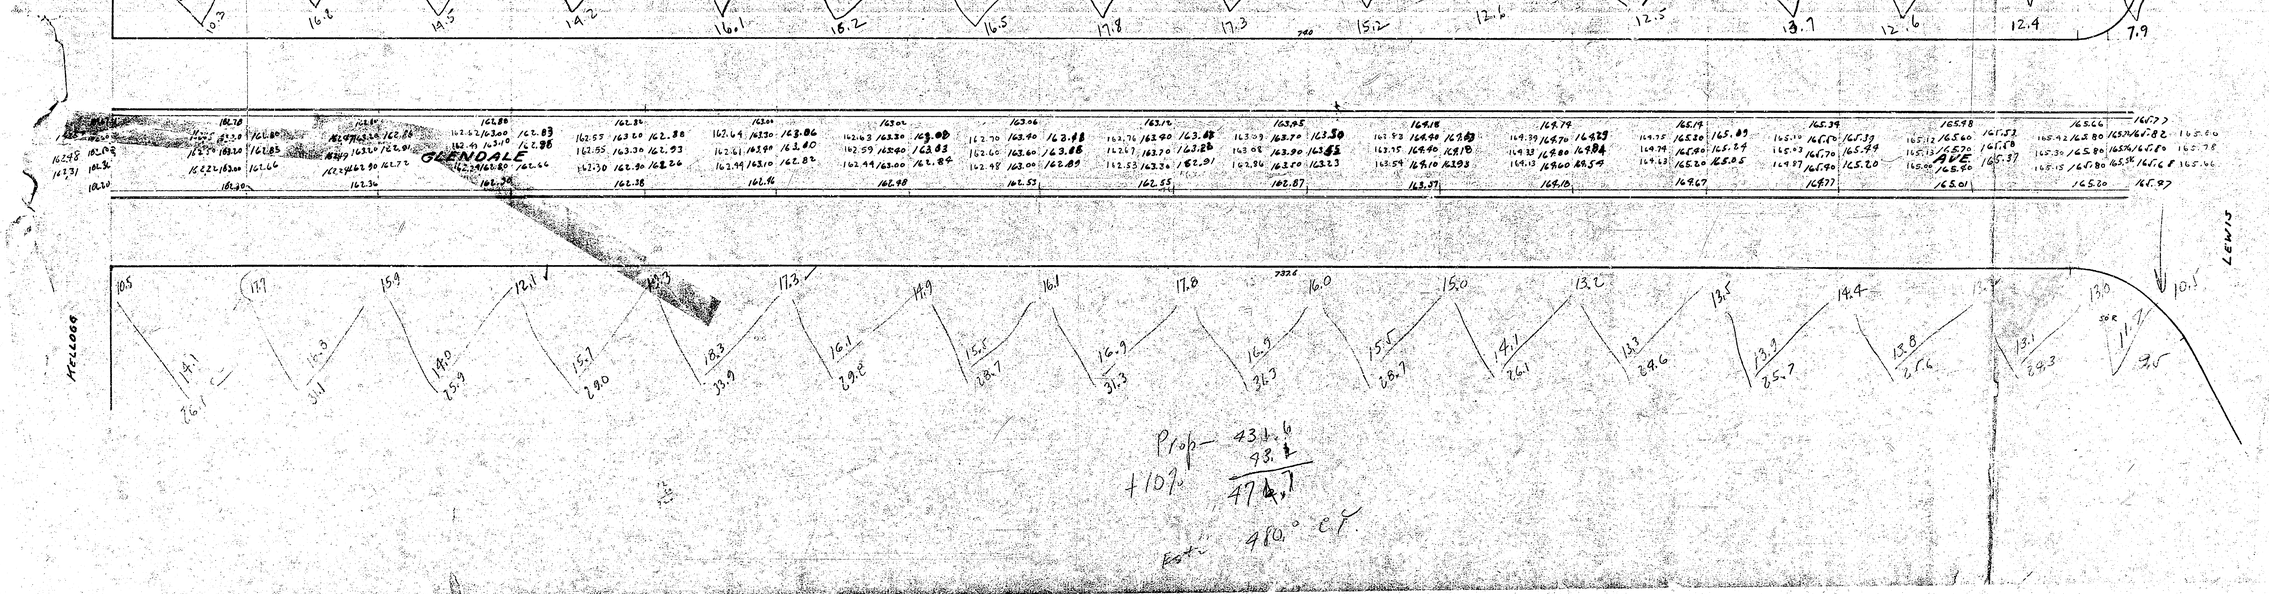

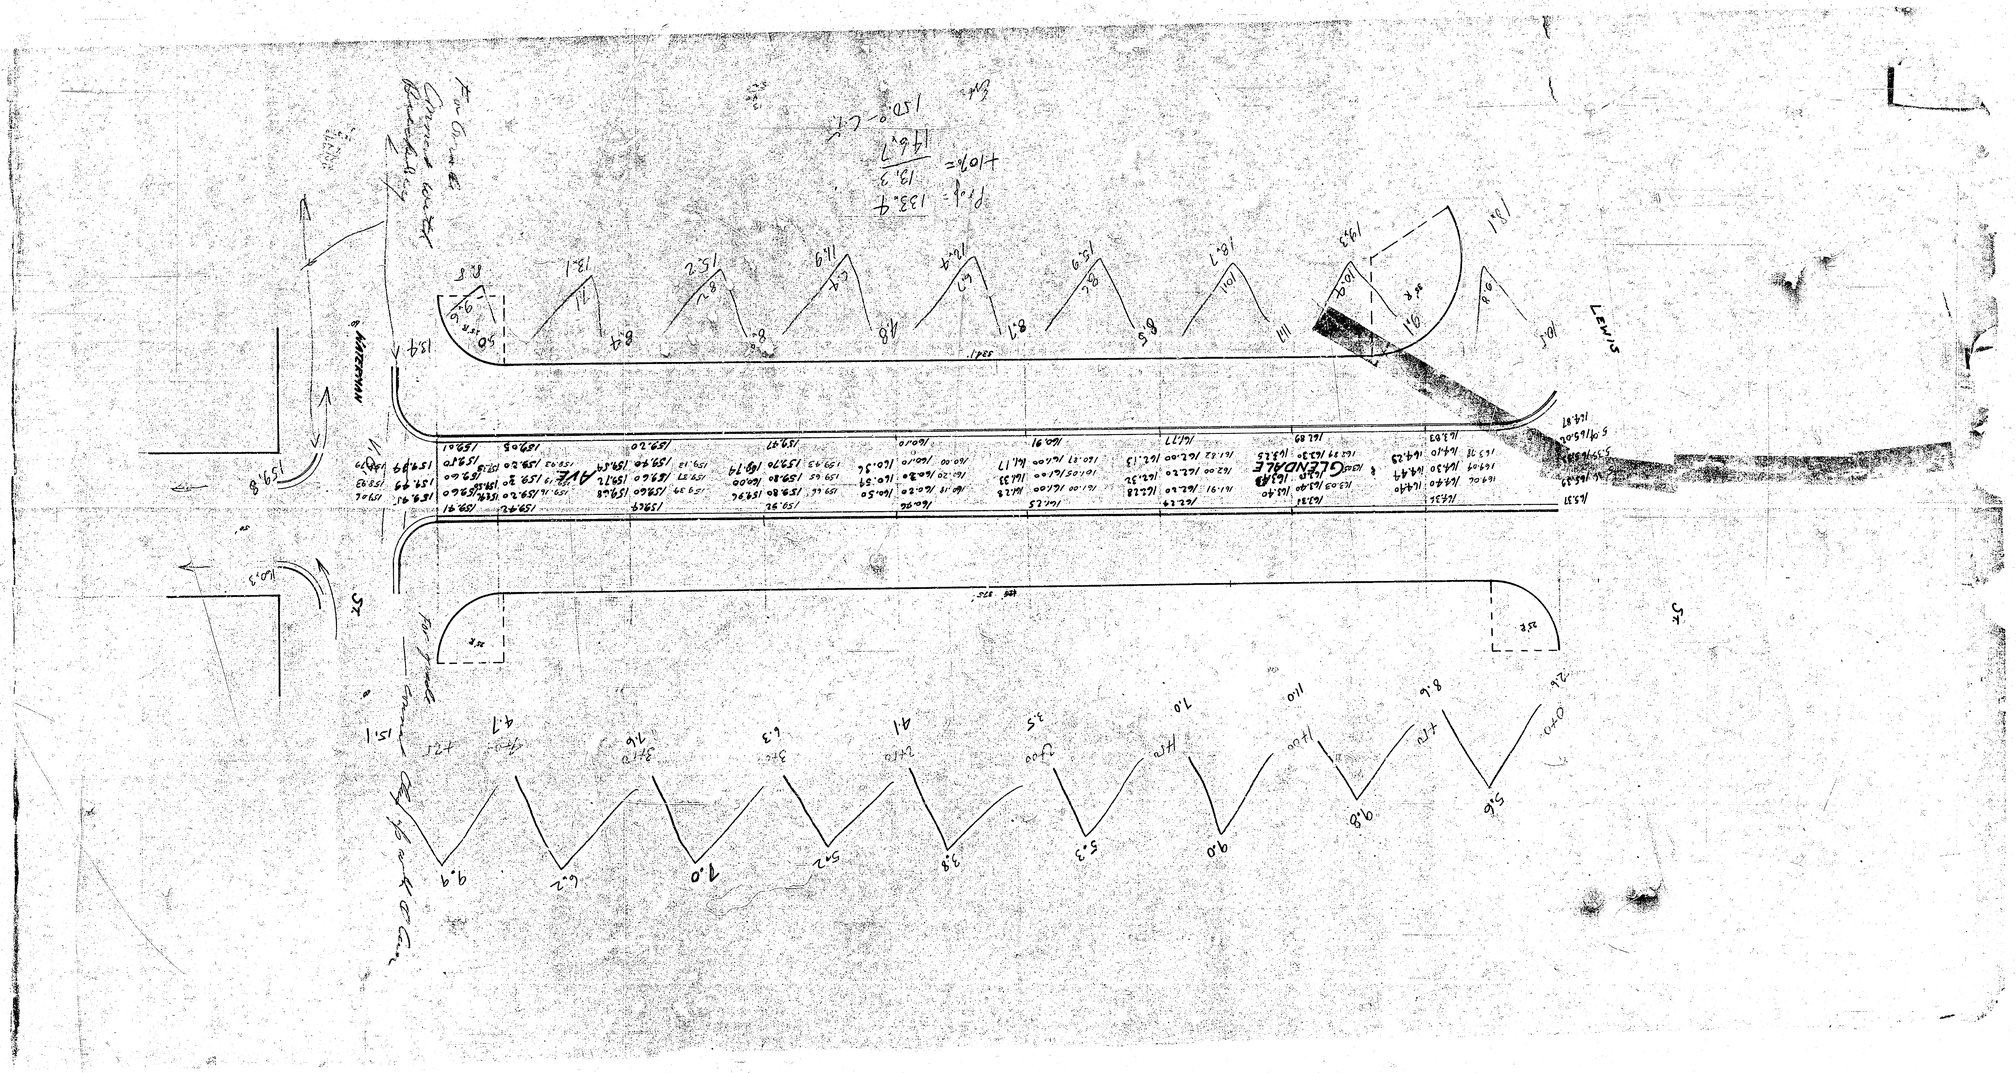
GLENDALE
LEWIS
