1941

GLENDALE - SL. ENGLISH to NL. WATERMAN

26' Concrete

5 Drive

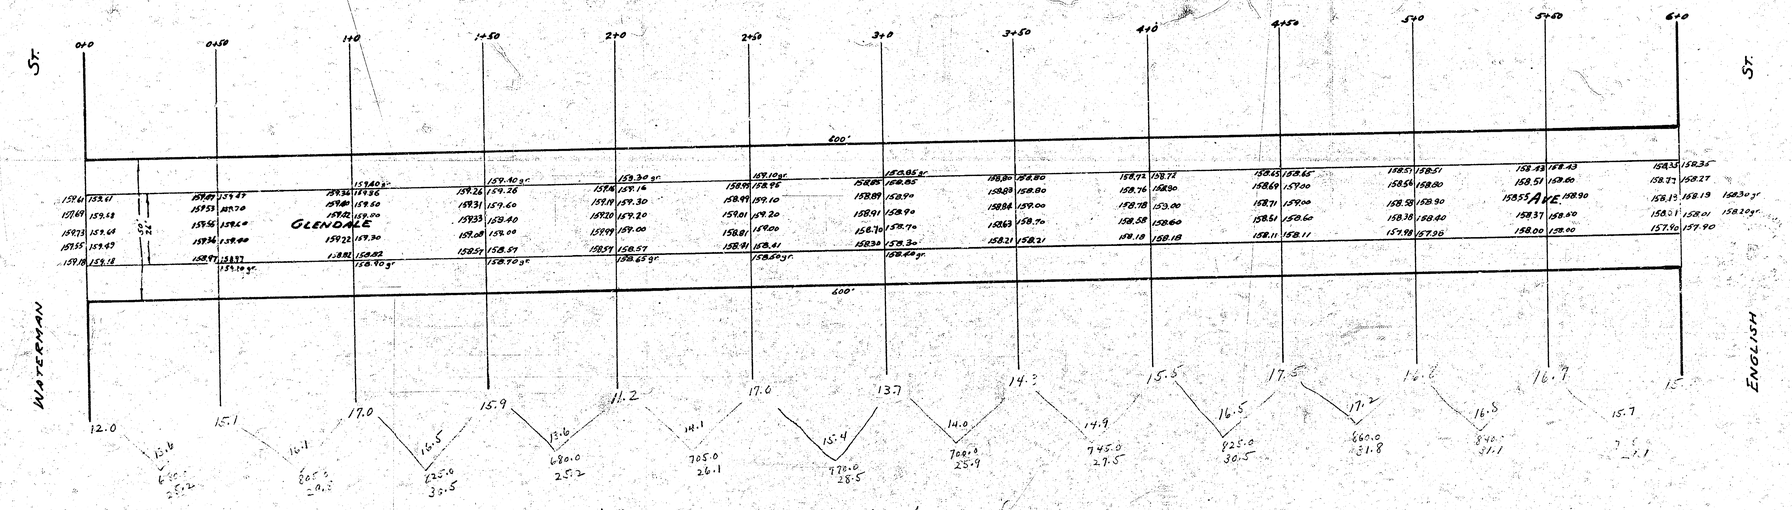

B.M. Elev. 158.84 "G" in Globe E. ch. Glendale N.L. English (N. Globe)

Curb and gutter has settlement in neighborhood of Station 1 to 2+50

+10% 34.1

375.3 cu. yds.

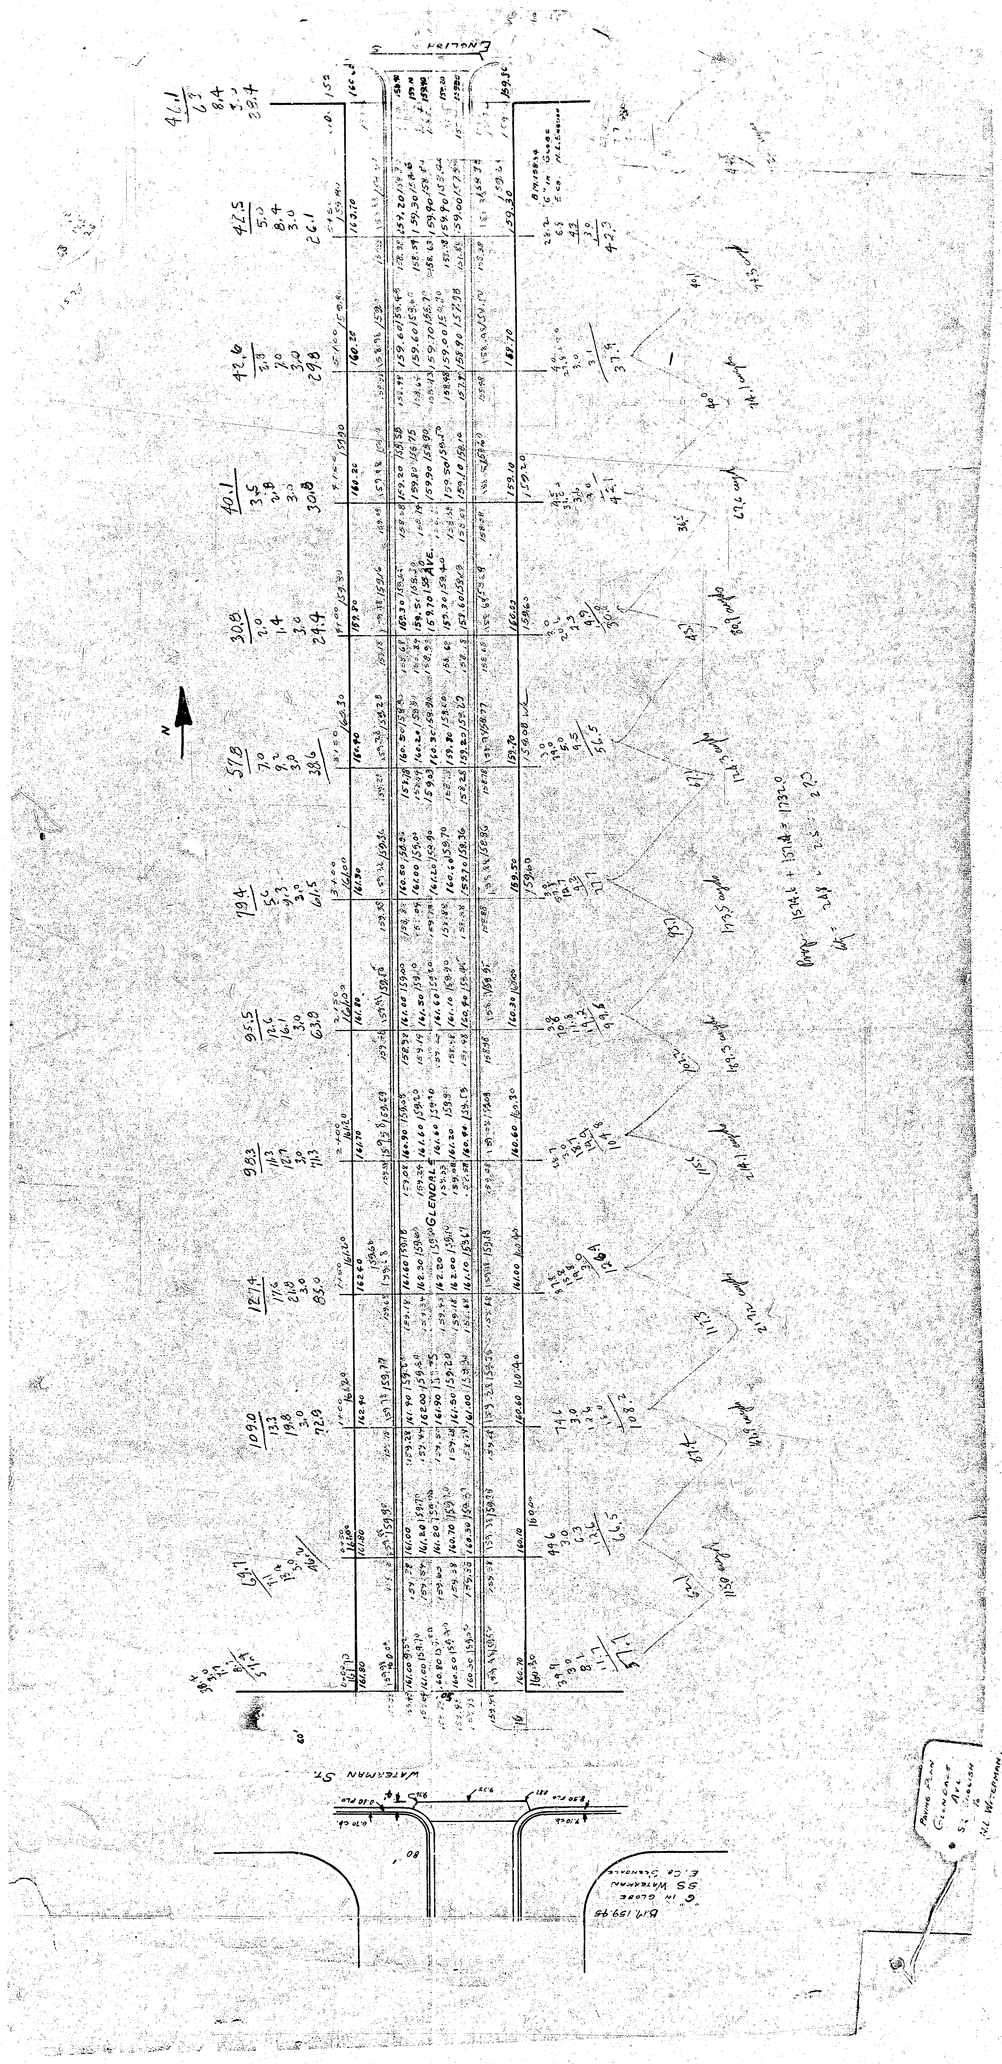
WATERMAN ST.
GLENDALE AVE.
ENGLISH
N