


GLENDALE AVE N.L. 1ST to S.L. 2ND 26' Conc.

BM. Elev. 169.87 'X' on E. ab. Glendale @ S.L. 1ST St.
 " " 167.62 'G' in Globe W. Gutter Glendale S.L. 2ND

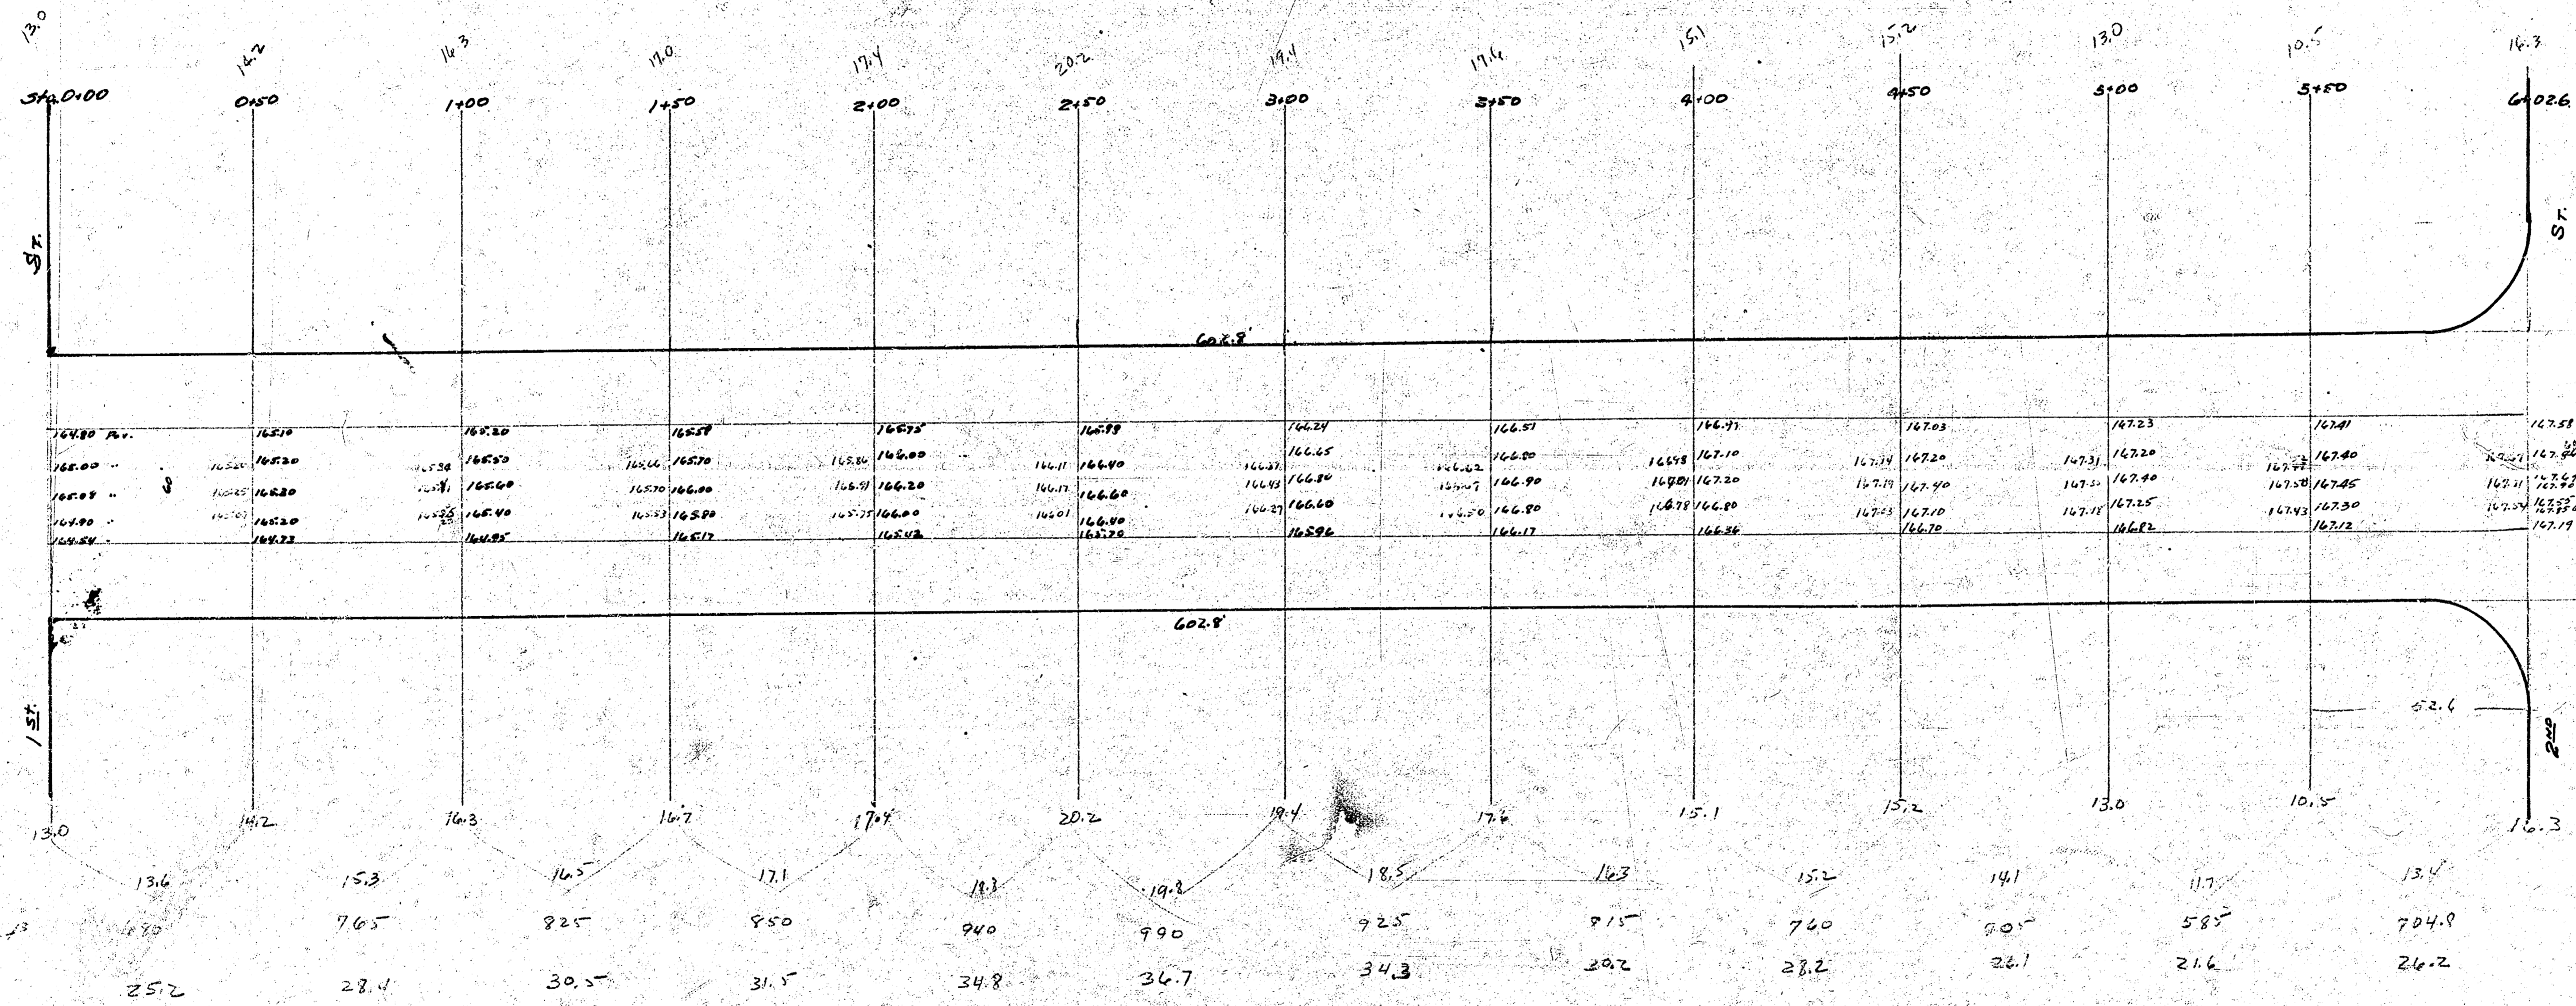

Plan
 GLENDALE AVE
 N.L. 1ST
 to
 S.L. 2ND
 1920.